




LEGEND  
 [Green Outline] Contemplated Mining 44A  
 August 2, 1909 to February 3, 1913  
 [Black Outline] Mining Completed

Mine Works 7/30/09 R.S.T.  
 Mine Works 8/13/09 W.K.E.  
 Up to date 4/27/07 R.S.T.  
 Mine Works 7/4/07 G.B.T.  
 Mine Works 10/20/08 R.S.T.  
 - REVISIONS -

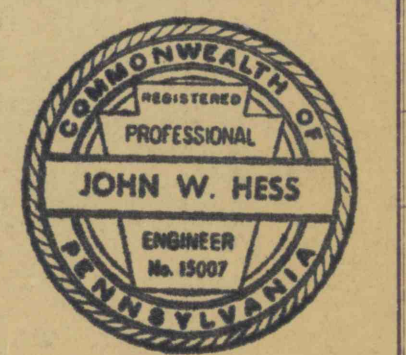

C SEAM  
 PERMIT #64-1

HEBURNIA COAL CO.  
 LULA MAY NO. 1  
 SUSQUEHANNA TWP. CAMERIA CO., PA.  
 SCALE 1 inch = 100 feet  
 AUGUST 21, 1909 JOHN W. HESS  
 CLEARFIELD, PA. ENGR. 11874