



MAP
 SHOWING
 "B" SEAM WORKINGS OF
 HERTZOG COAL CO. NO. 1 MINE
 CLEARFIELD TWP, CAMBRIA CO., PA.
 SCALE - 1" = 100'
 J.L. BANFIELD REG. ENG.

- PROPERTY LINE
- - - WORKED OUT AREAS
- - - PROJECTED WORKINGS

11-14-68 - 10-14-68

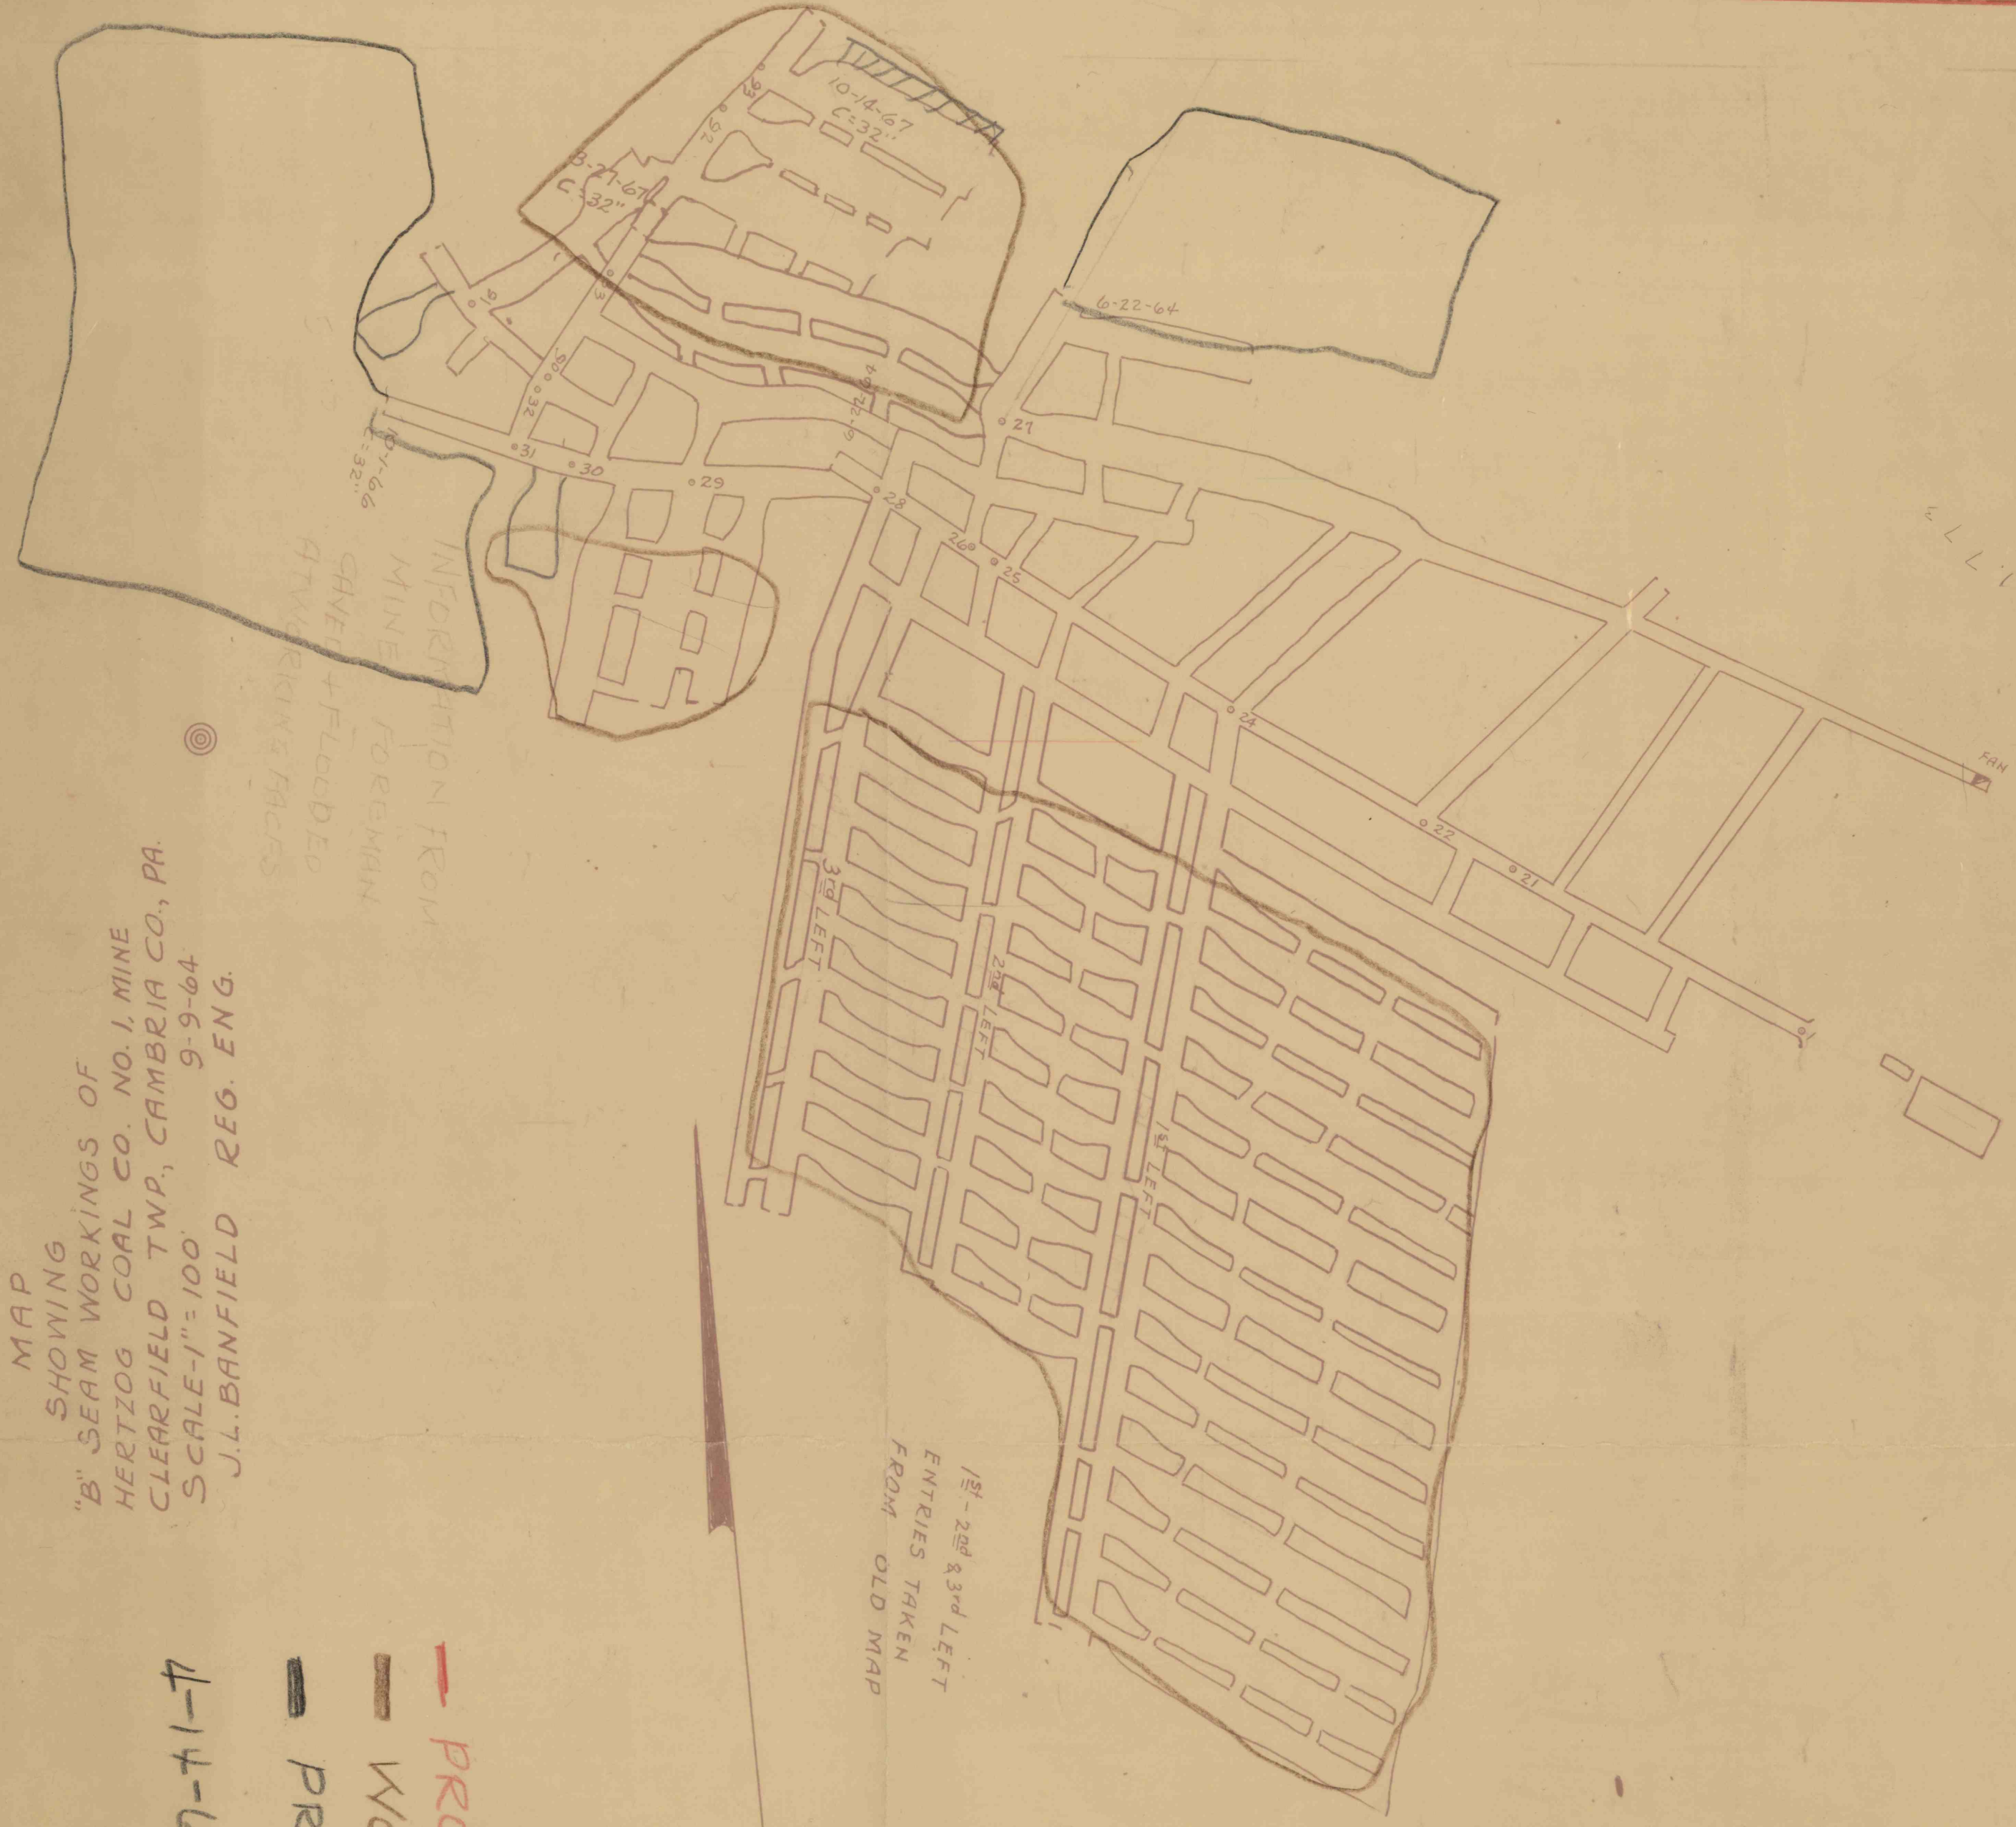

J. C. MCGOUGH SURF.
 REGIS HERTZOG COAL
 1890 AS.

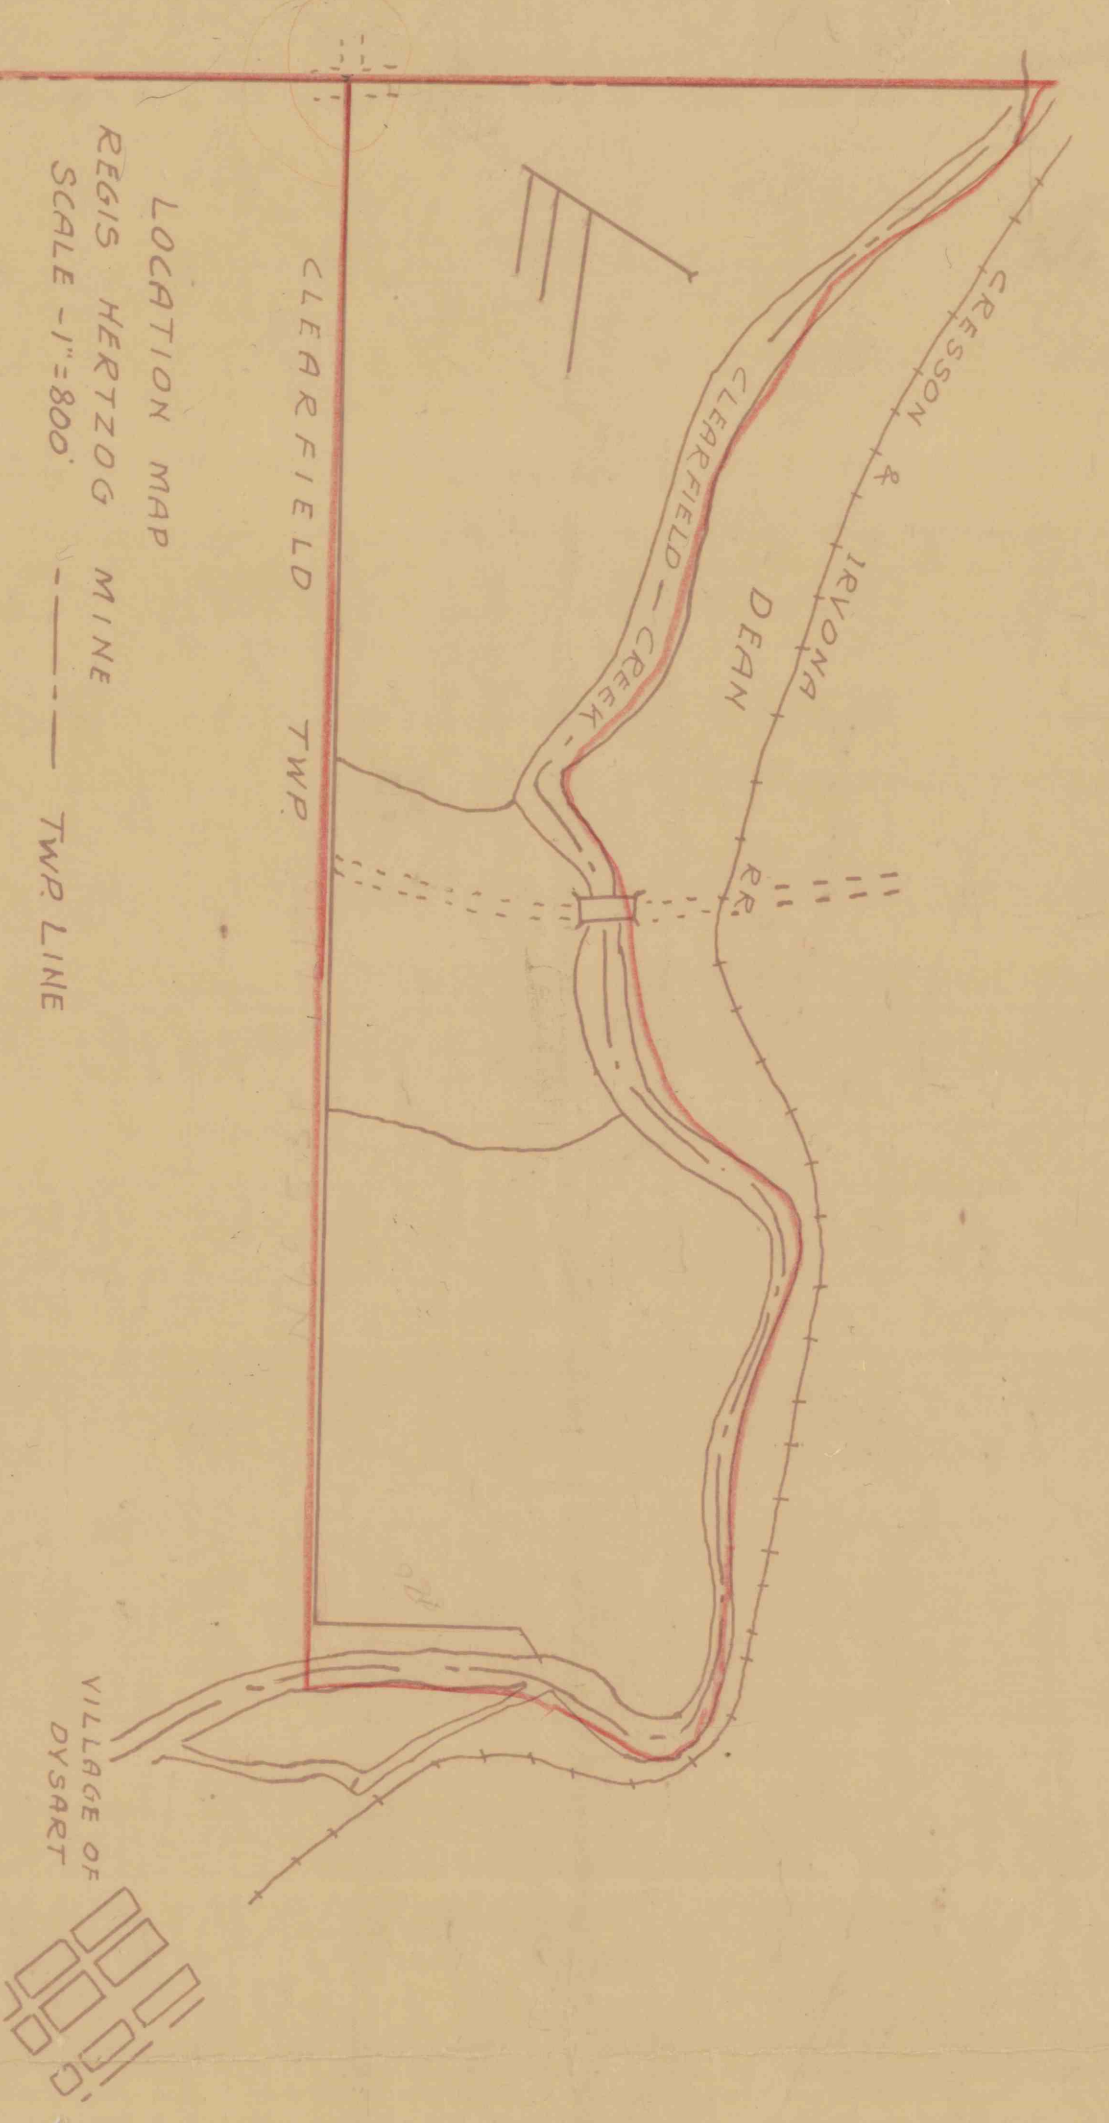

MAKE PRINT TO THIS LINE

84E