





ABANDONED WORKINGS

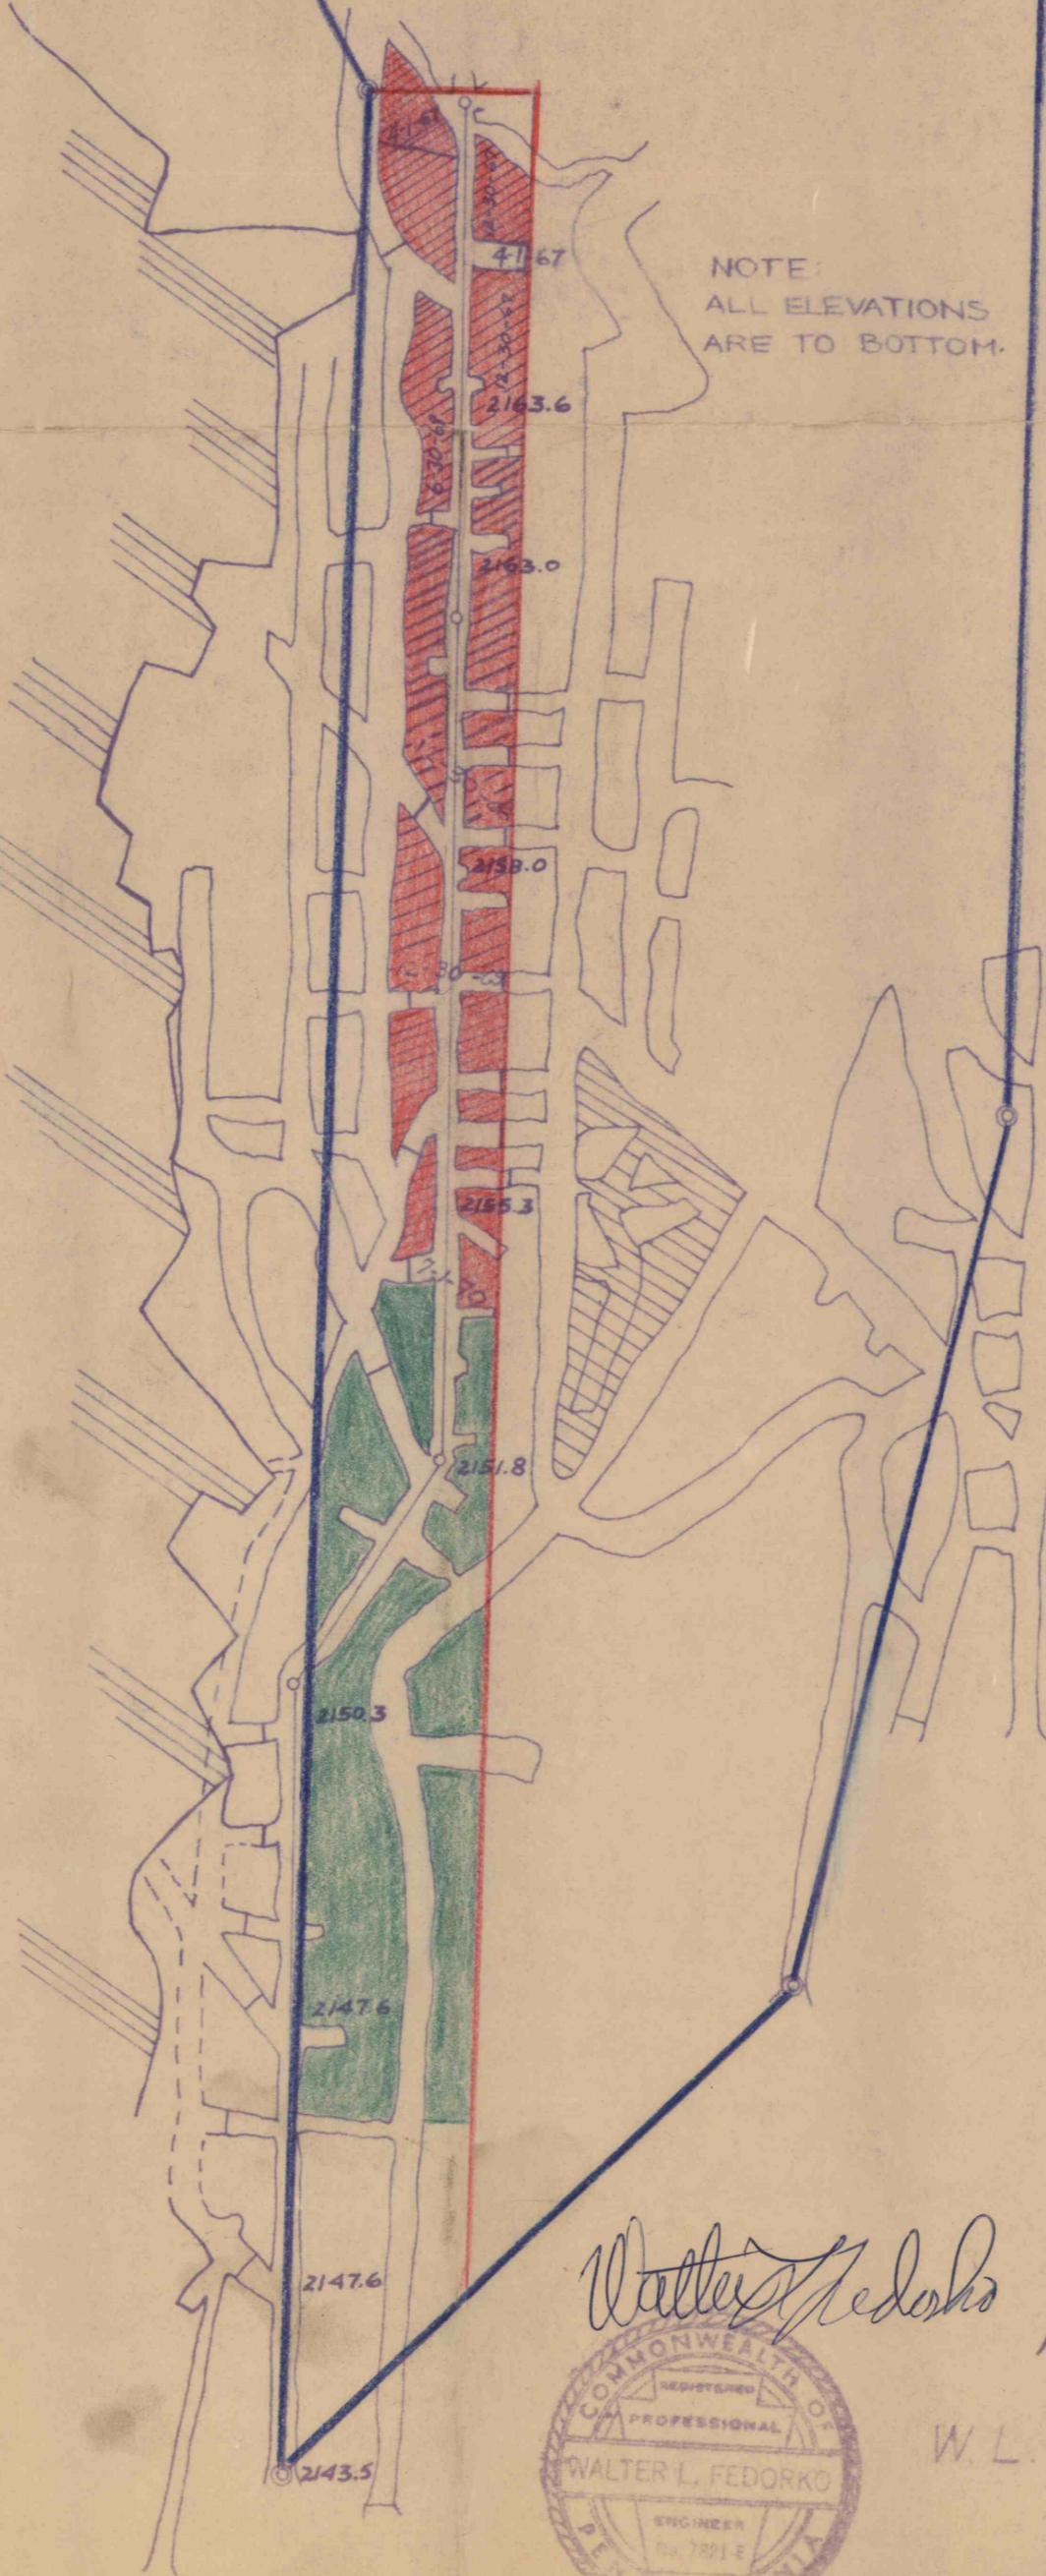

NOTE:
ALL ELEVATIONS
ARE TO BOTTOM.

LEGEND:

- PERMIT AREA
- MINING COMPLETED
- CONTEMPLATED MINING 7-1-70 to 1-1-71

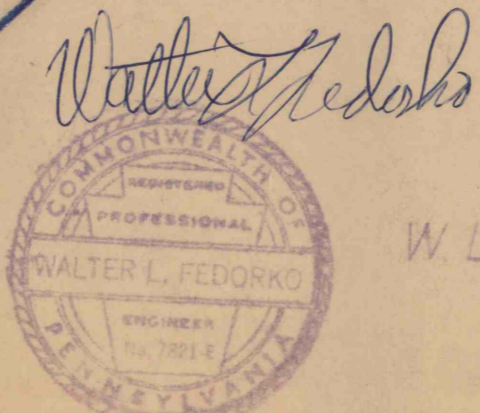

Walter Fedorko
LONLEY COAL CO.
PORTAGE, TWP. CAMBRIA CO.
 SCALE: 1"=100' SEPT. 1966
W. L. FEDORKO CONSULTING ENGINEERS
 PORTAGE, PENNSYLVANIA

253