

CAMBRIA LAND CORP-FEE

WM SPONSKY-FEE  
54 AC TRACT

JOHN SPONSKY-SUR  
CAMBRIA COUNTY COMM-COAL

MINING COMPLETED

MINING COMPLETED

PERMIT 11890-1 PROJECTION No 22

WILLIAM SPONSKY

MINE No 1

LOWER FREEPORT MINING  
SITUATE

WEST CARROLL TWP. CAMBRIA CO.

AUG 1956

SCALE 1"=100'

Martin C. Kirsch PE  
Spangler, Pa.


FED. No 36011610

LEGEND

FEE AGAIN RED

PROJECTED MINING AREA

FROM 4-21-77 TO 10-21-77 GREEN

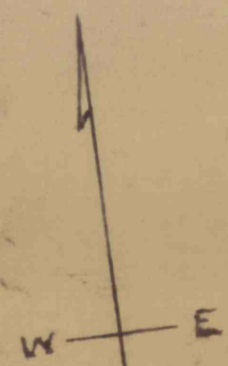

CAMBRIA LAND CORP  
FEE

WM SPONSKY SUR COAL

To Record