




CHARLES
KURTZ

- PROPERTY LINE
- BARRIER LINE
- 6 MONTH PROJECTION

REVISIONS	
1	JAN. 1, 1967
2	JAN. 30, 1968
3	AUG. 20, 1968
4	MAR. 18, 1969
5	OCT. 13, 1969
6	FEB. 9, 1970
7	SEPT. 15, 1970
8	
9	
10	

W. A. BURKETT


MINING AREA SEPT. 15, 1970 to MAR. 15, 1971

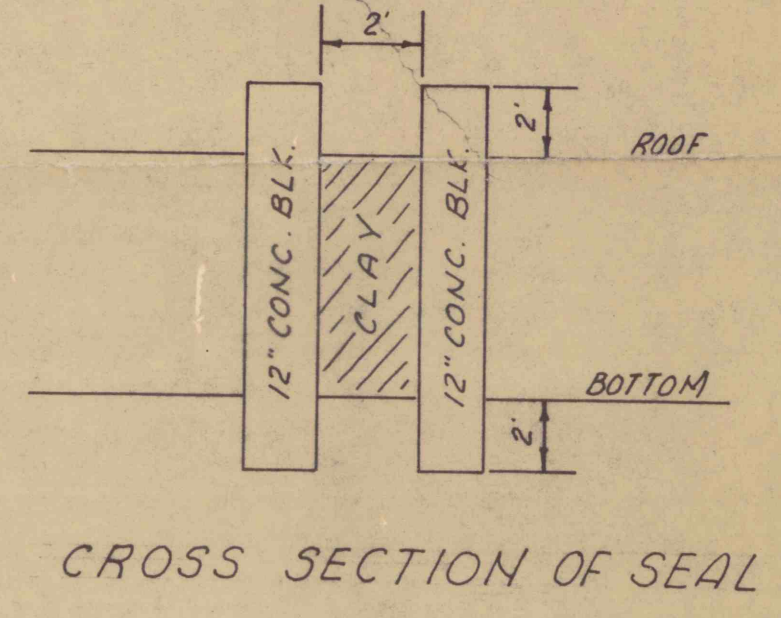

MINE DRAINAGE
SUPER COAL CO. MINE
 SITUATE
 WHITE TOWNSHIP, CAMBRIA CO. &
 BECCARIA TOWNSHIP, CLEARFIELD CO., PA.
 SCALE: 1"=100'
 OCT. 10, 1966
 REV. JAN. 18, 1967
 REV. MAR. 7, 1969

PLAN PARTIALLY TRACED FROM PLAN OF
 W.L. FEDORKO, RE. PORTAGE, PA.
 TRACED BY: IBB

PLAN PREPARED BY
 MINING DEPT
 GWIN, ENGINEERS-CONSULTING ENGINEERS
 ALTOONA, PA.

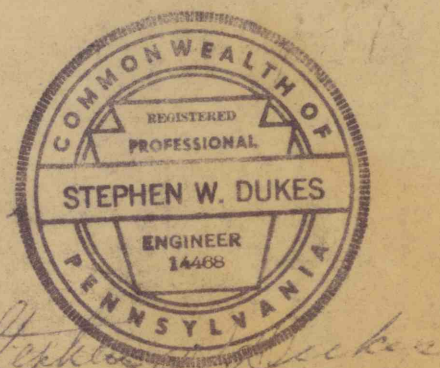

210-000
 66-9-90