

CHAPLES  
KURTZ

OLD MINE WORKINGS

O'SHALL & CHAPLIN (IN FEE) 100' BARRIER  
28 ACRES

OLD MINE WORKINGS

W. A. BURKETT

37 ACRES 18 PC

W. A. BURKETT

PROPOSED SEALS FOR  
FUTURE MINING  
SEALS TO BE ERECTED  
SEQUENCE FROM RIGHT TO LEFT  
(PA)

GOAL EL 1630

EQUIPMENT  
STRIP OUT

BARRIER



RIGHT WALL

RISE

EL 1585

MAX VOL. 20,000 C.F.M.

50" DIAM FAN  
100 HP ADJUSTABLE SPEED  
7.5 HP MOTOR 2880 AC  
20,000 C.F.M.  
W.G. READING 1750 R.P.M.  
DUFF BLIND 8848

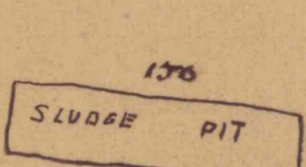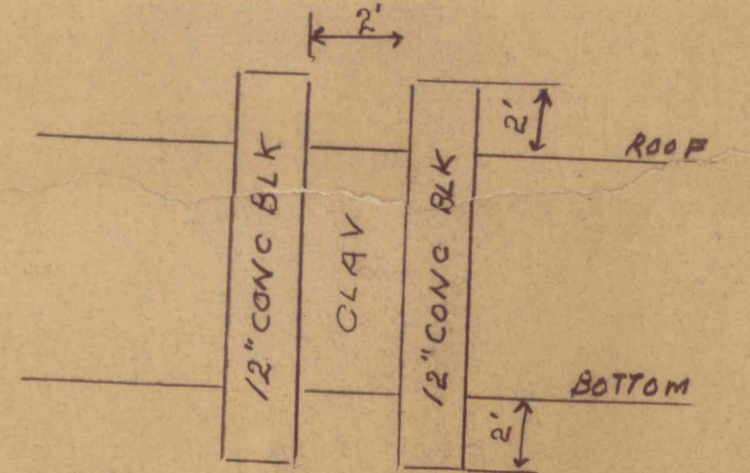

- PROPERTY LINE
- BARRIER LINE
- 6 MONTH PROJECTION

REVISIONS	
1	JAN 1 1967
2	JAN 30 1968
3	AUG 20 1968
4	MAR 18 1969
5	OCT 13 1969
6	FEB 9 1970
7	SEPT 15 1970
8	APRIL 27 1971
9	By <i>A. J. Hill</i>
10	

W. A. BURKETT  
ALL NOTES ADDED AS INSTRUCTED BY  
FEDERAL MINE INSPECTOR

MINING AREA SEPT 15, 1970 to MAR 15, 1971

LEGEND	
INTAKE AIR	→
RETURN AIR	←
CHECK	⊕
LINE CURTAIN	+++++
SEAL FUTURE MINING	

MINE DRAINAGE  
SUPER COAL CO MINE D SEAM  
SITUATE

WHITE TOWNSHIP CAMBRIA CO &  
BECCARIA TOWNSHIP CLEARFIELD CO PA  
SCALE 1" = 100'  
OCT 10 1966  
REV JAN 18 1967  
REV AUG 1969

NOTE  
WORKINGS PLOTTED FROM  
MAP FURNISHED BY OWNER  
PLOTTED BY *A. J. Hill* RS

PLAN PARTIALLY TRACED FROM PLAN OF  
W. LEEDORNO PE PORTAGE PA