

COMM. OF PENNA. - SURF D. BINNIX-COAL

COMM. OF PENNA. - SURF
D. BINNIX - COAL
96 ACRES +/-

COMM. OF PENNA.
SURF
D. BINNIX - COAL




BASE POINT


COMM. OF PENNA.-SURF D. BINNIX-COAL
MINE BOUNDARY

+++++	MULE HAULAGE
o4	SURVEY POINTS
-	CONTEMPLATED MINING AREA
15011	ELEVATION
-	MINE BOUNDARY
-	MINED AREA (TURNED)

COMM OF PENNA SURF
D. BINNIX - COAL

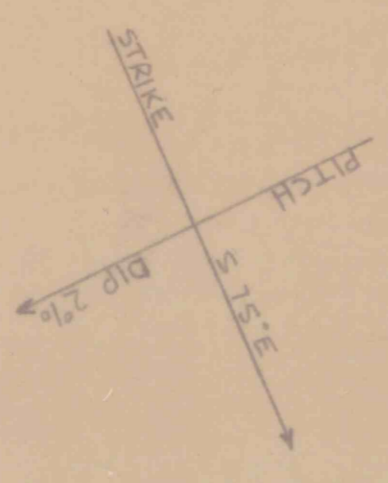

Actual D' seam MS 11-1-82

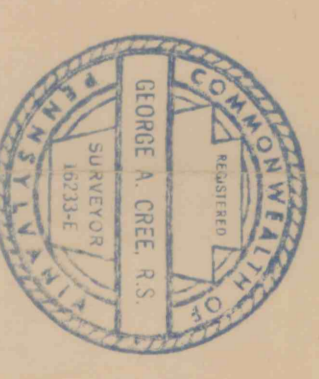

STELLA MARIS COAL CO
STELLA MARIS MINE NO. 1
LOWER KITTANNING SEAM WORKINGS
DEAN TOWNSHIP - CAMBRIA CO., PA
SCALE 1" = 100' DEPART PENNA. 16535
DATE _____
 CONTEMPLATED MINING 2-20-78 TO 2-20-79
 MINING COMPLETED _____ TO _____
 REVISED ADDITIONS _____ TO _____
SURVEYOR - GEORGE A. CREE
SIGNED *George A. Cree*

247