




RICH HILL No. 1 MINE
 WORKING AREAS - "E" SEAM
 MINING COMPLETED FEB. 28, 1967
 FINAL MAP
 SCALE 1" = 100'

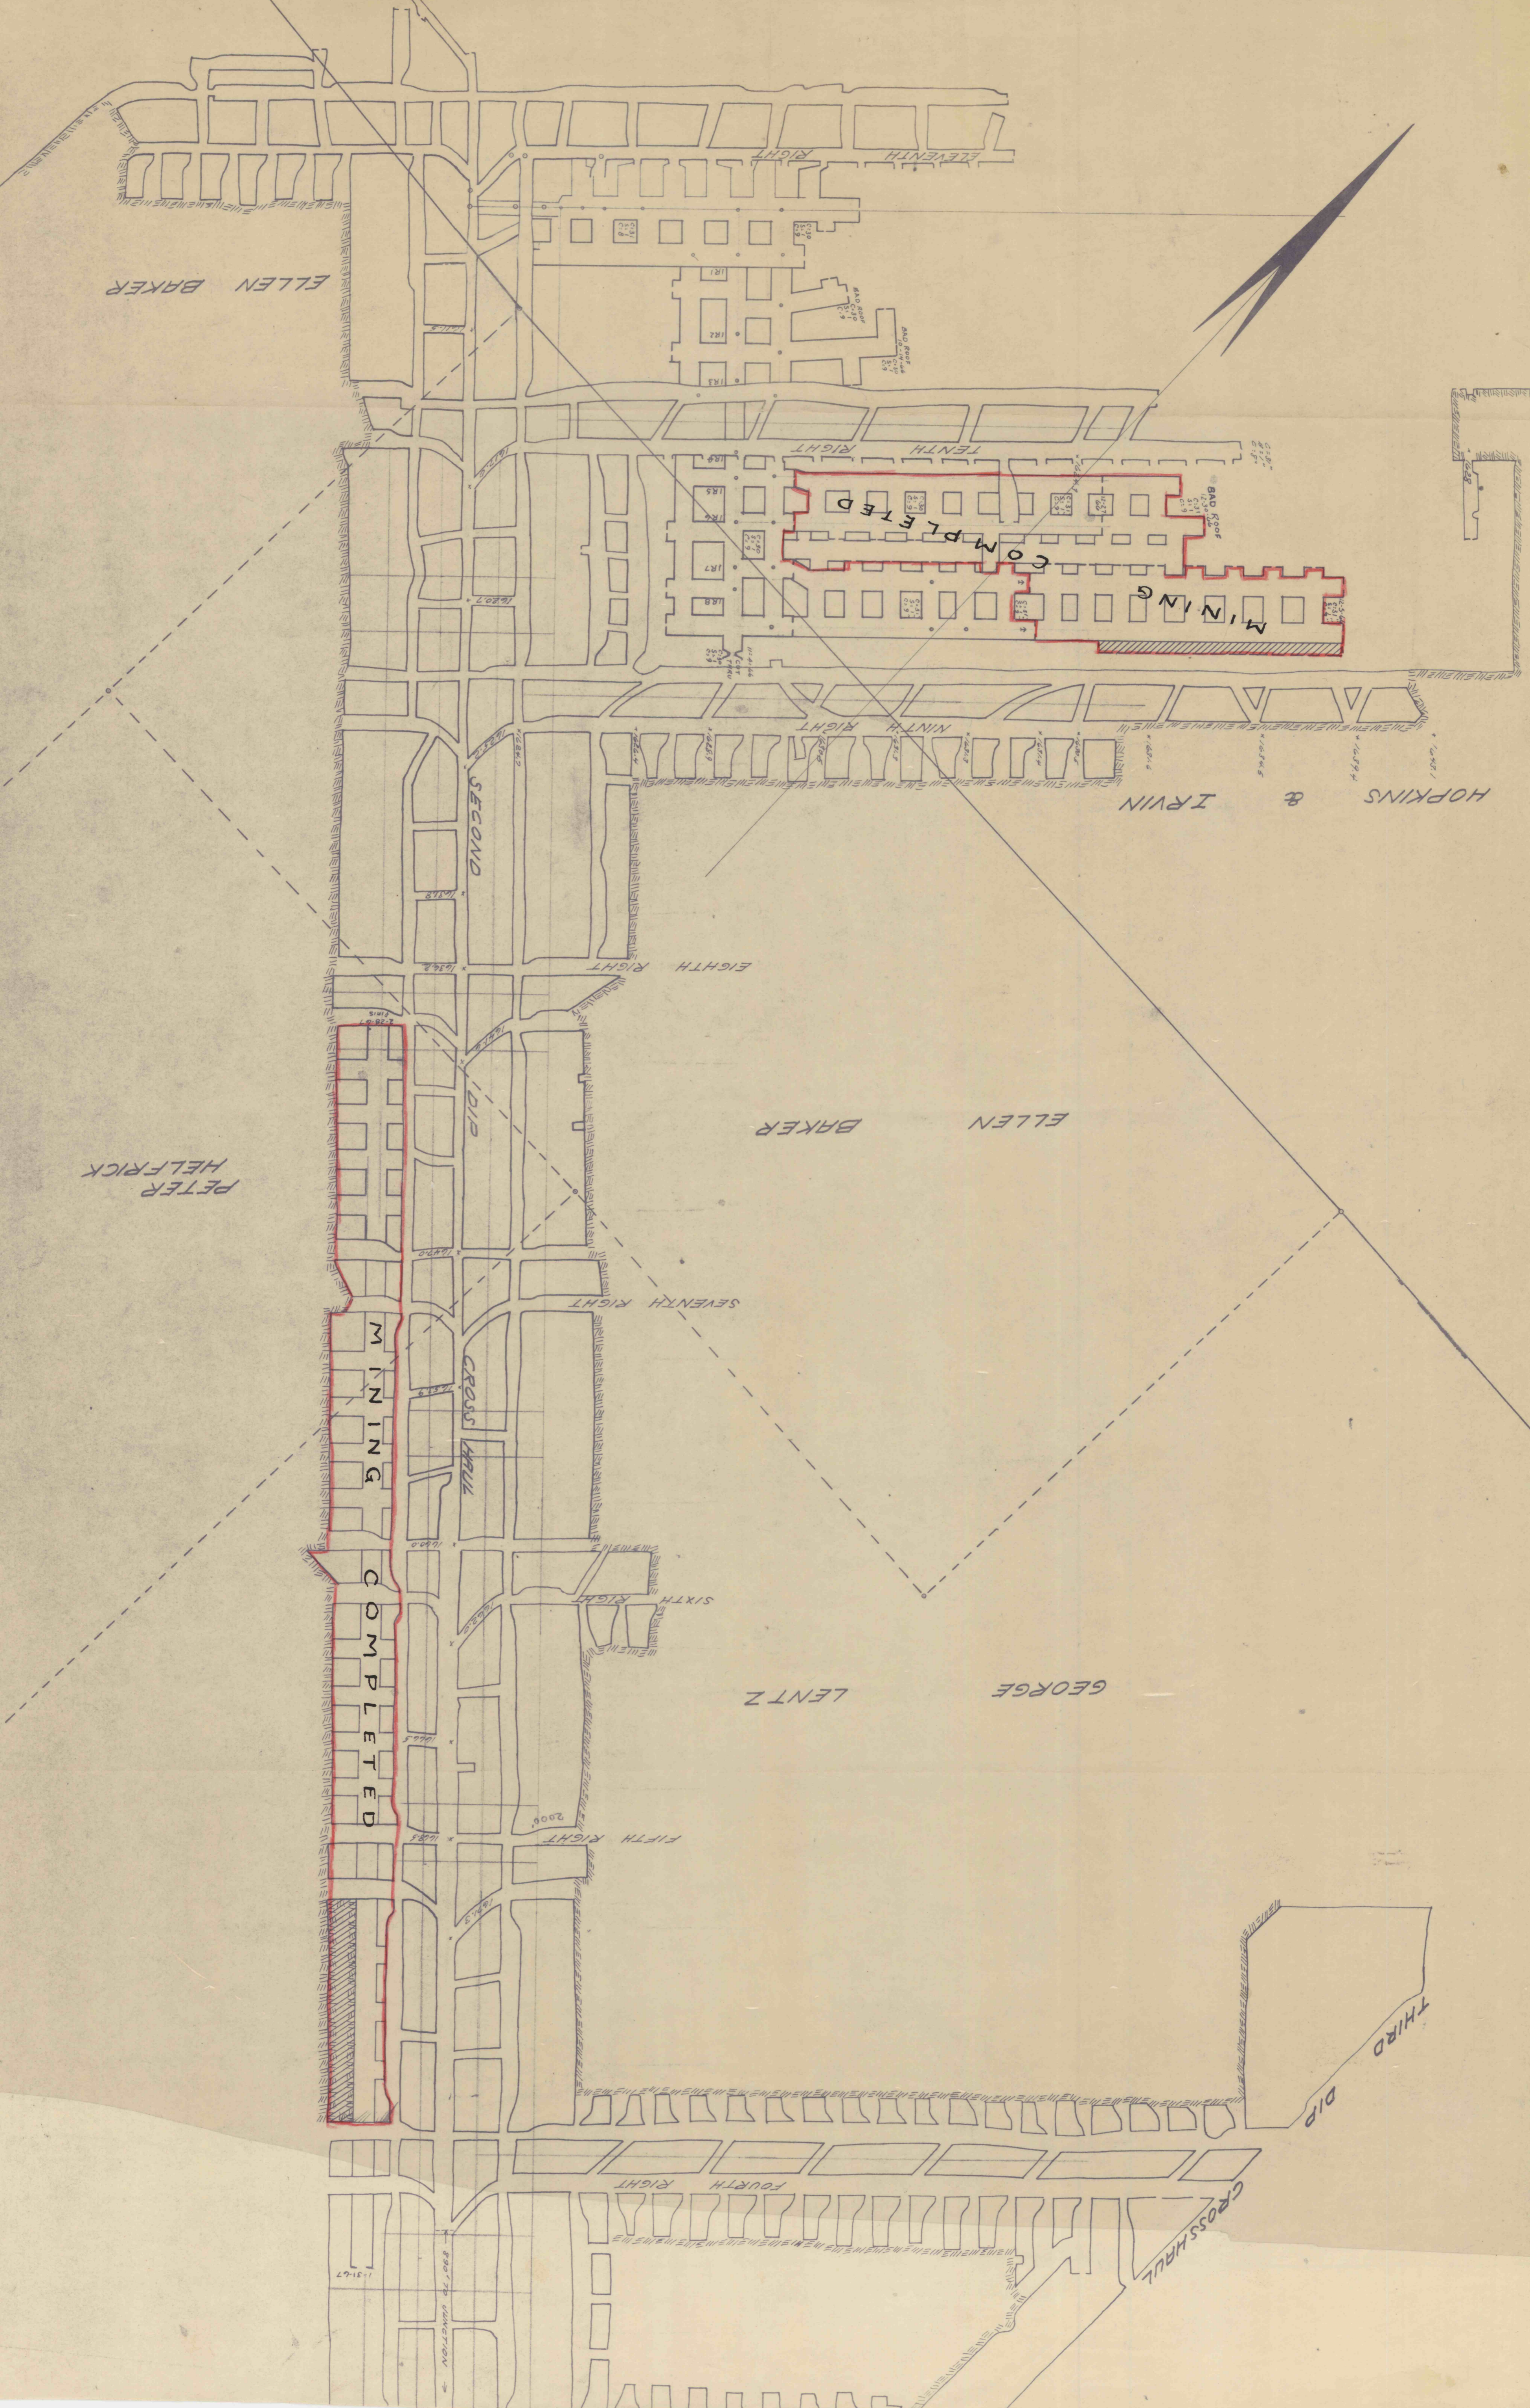

PETER HELFRICK

HOPKINS & IRVIN

Parsons & Co.