


MAP OF
BINDER NO. 2 MINE
D. SEAM
BINDER COAL CO. - OPERATORS
Apr. 1918
Scale 1"=100'

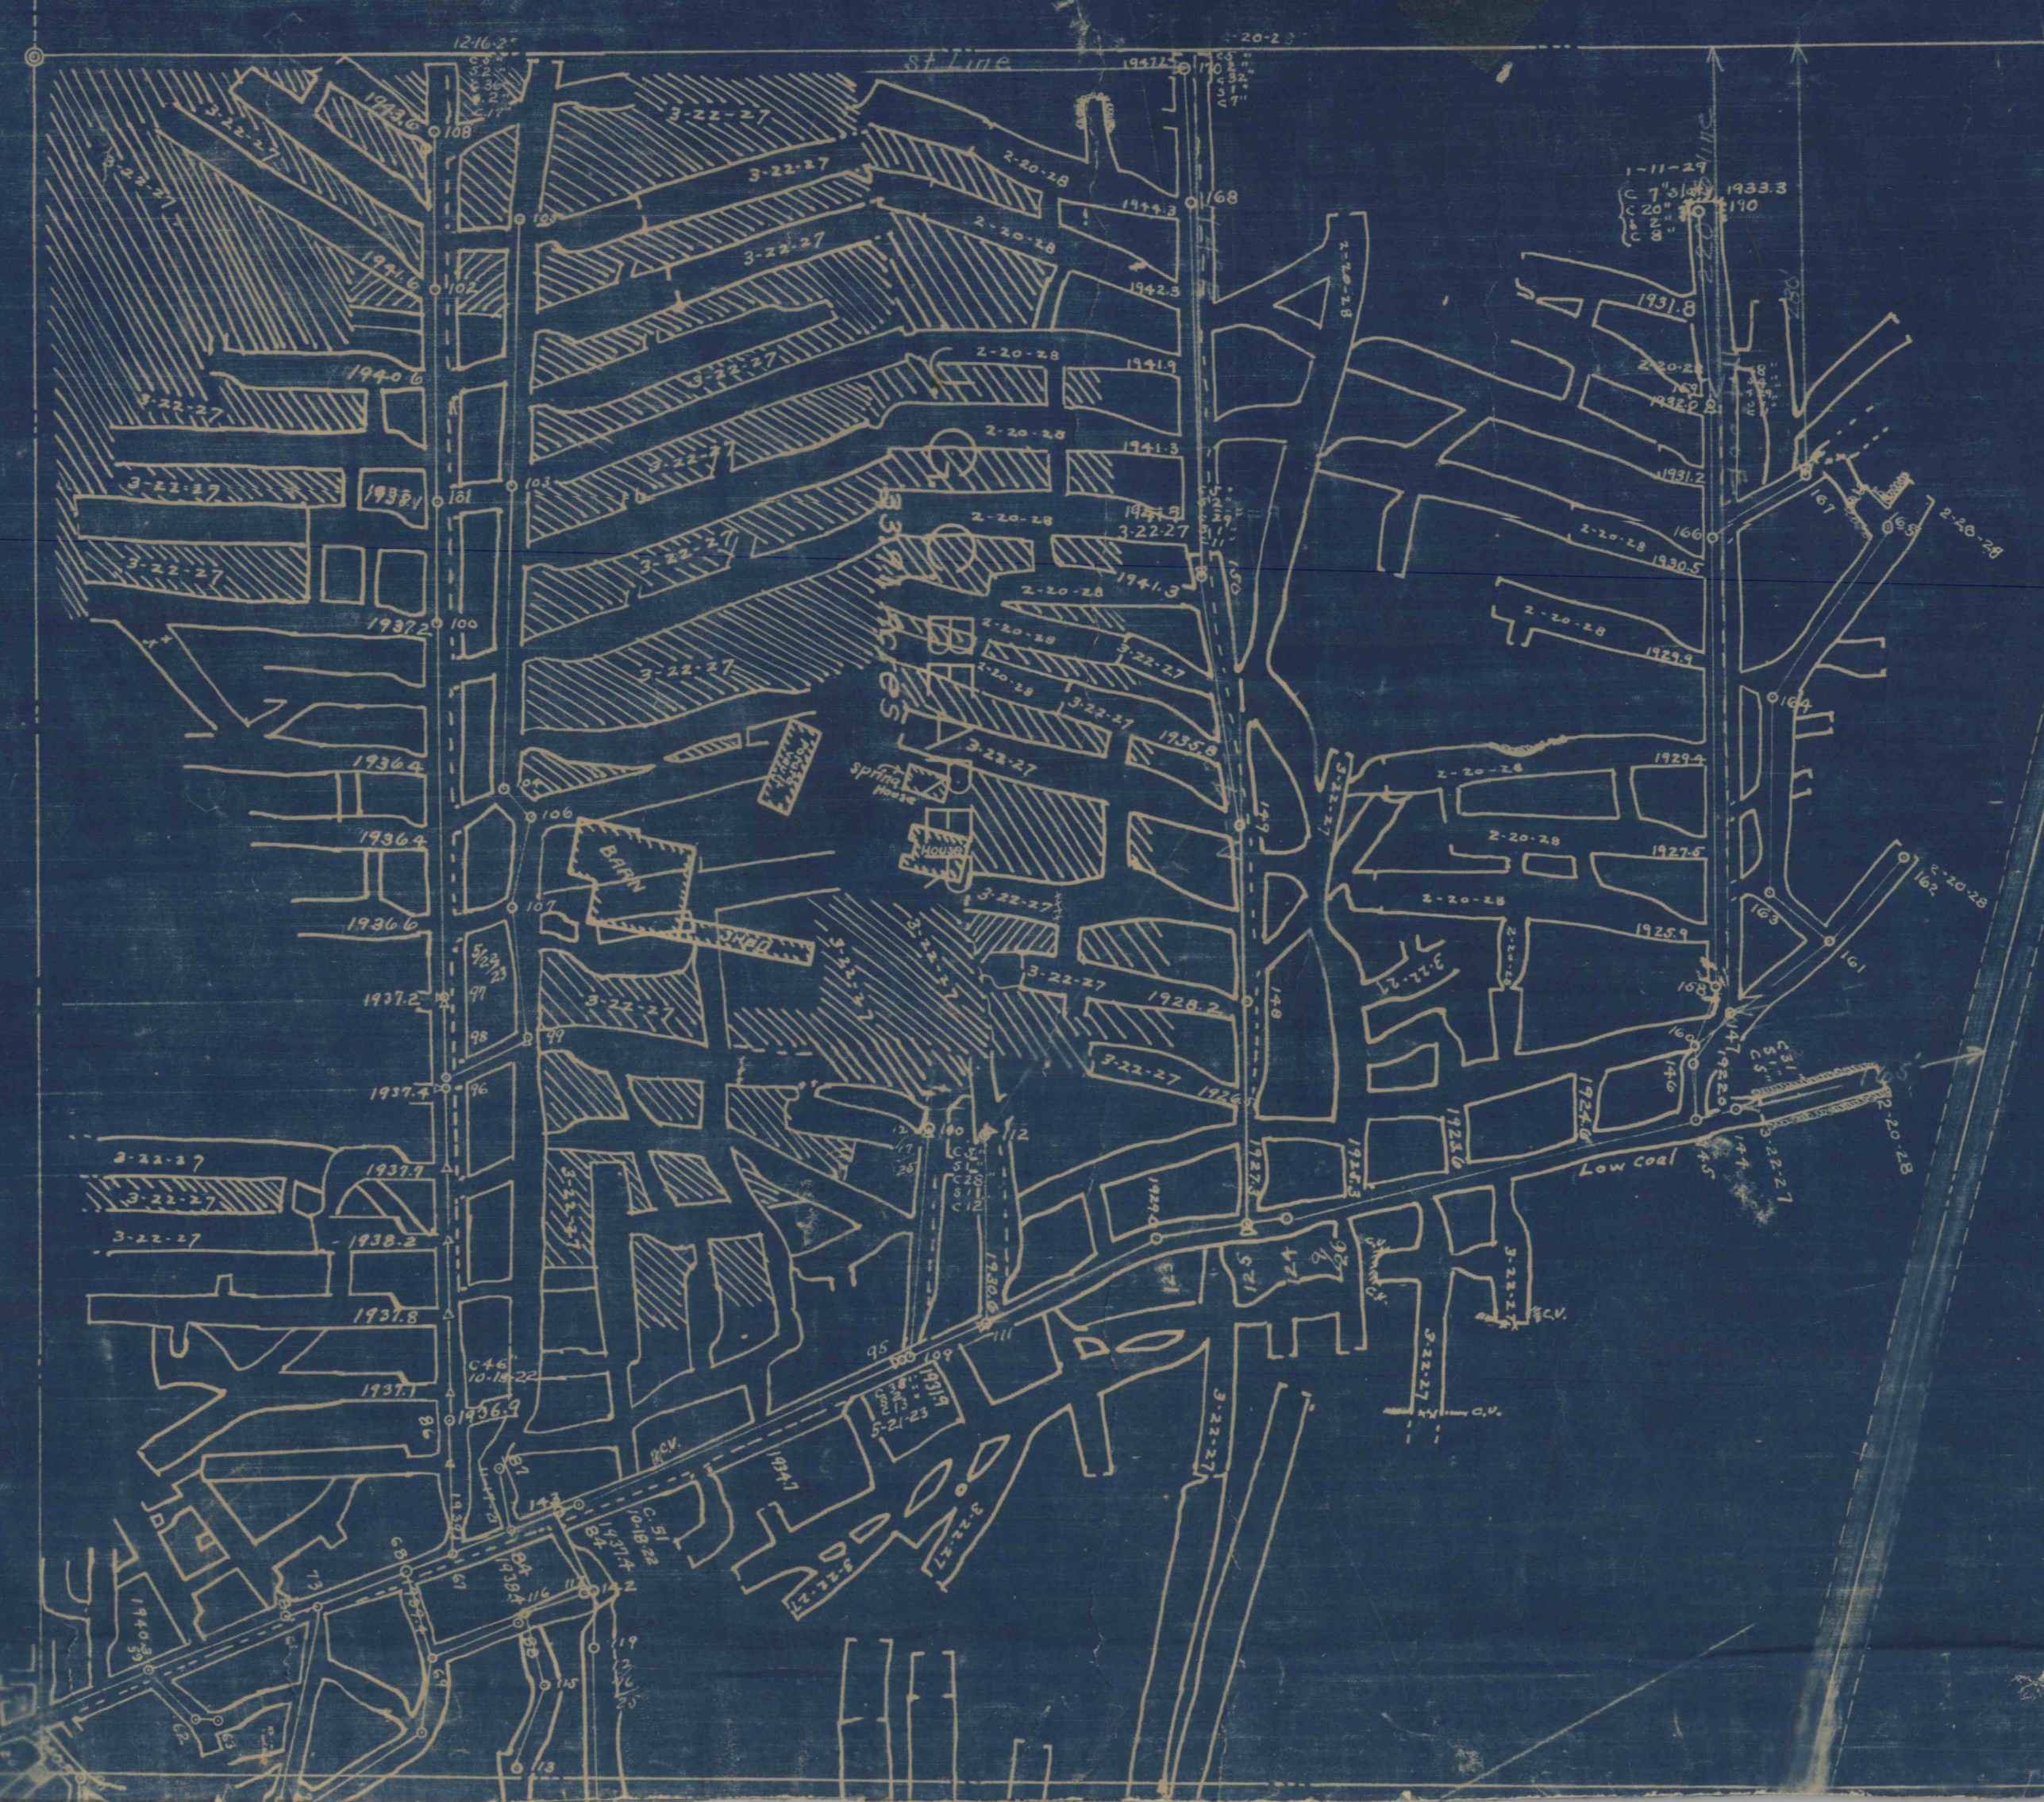

P. L. ECK

MARY THOMAS