


The Lorain Steel Company
 Subsidiary of
 UNITED STATES STEEL CORPORATION

STINEMAN COAL & COKE CO.
 Subsidiary of
 The Lorain Steel Company

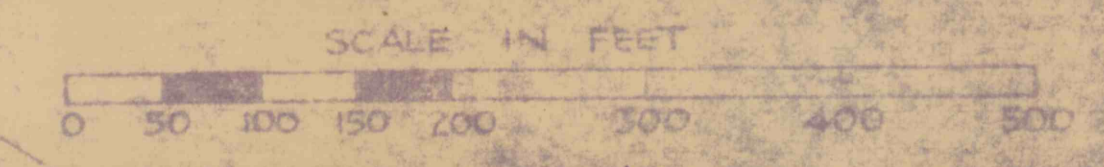

MAP SHOWING MINING OPERATIONS
 No 3 Mine of the Seam
 Ingleside Richard Twp., Cambria County,
 Carnegie-Illinois Steel Corporation
 LORAIN DIVISION
 Subsidiary of
 UNITED STATES STEEL CORPORATION
 U.S.
 STINEMAN COAL & COKE CO.
 OCT 4, 1939

PARCEL No 29

PARCEL

PARCEL

PARCEL

PARCEL

PARCEL No 20

NOTE
 ALL ELEVATIONS MADE BY ARE ON SEA LEVEL
 ALL ELEVATIONS MADE BY ARE ON BITUMINOUS COAL

INDEX TO GENERAL SURVEYS CONTD
 6 JUNE 1940, L.H. ALTEMUS
 JULY 1941, L.H. ALTEMUS

INDEX TO GENERAL SURVEYS	
A	JAN 1930, L.H. ALTEMUS
