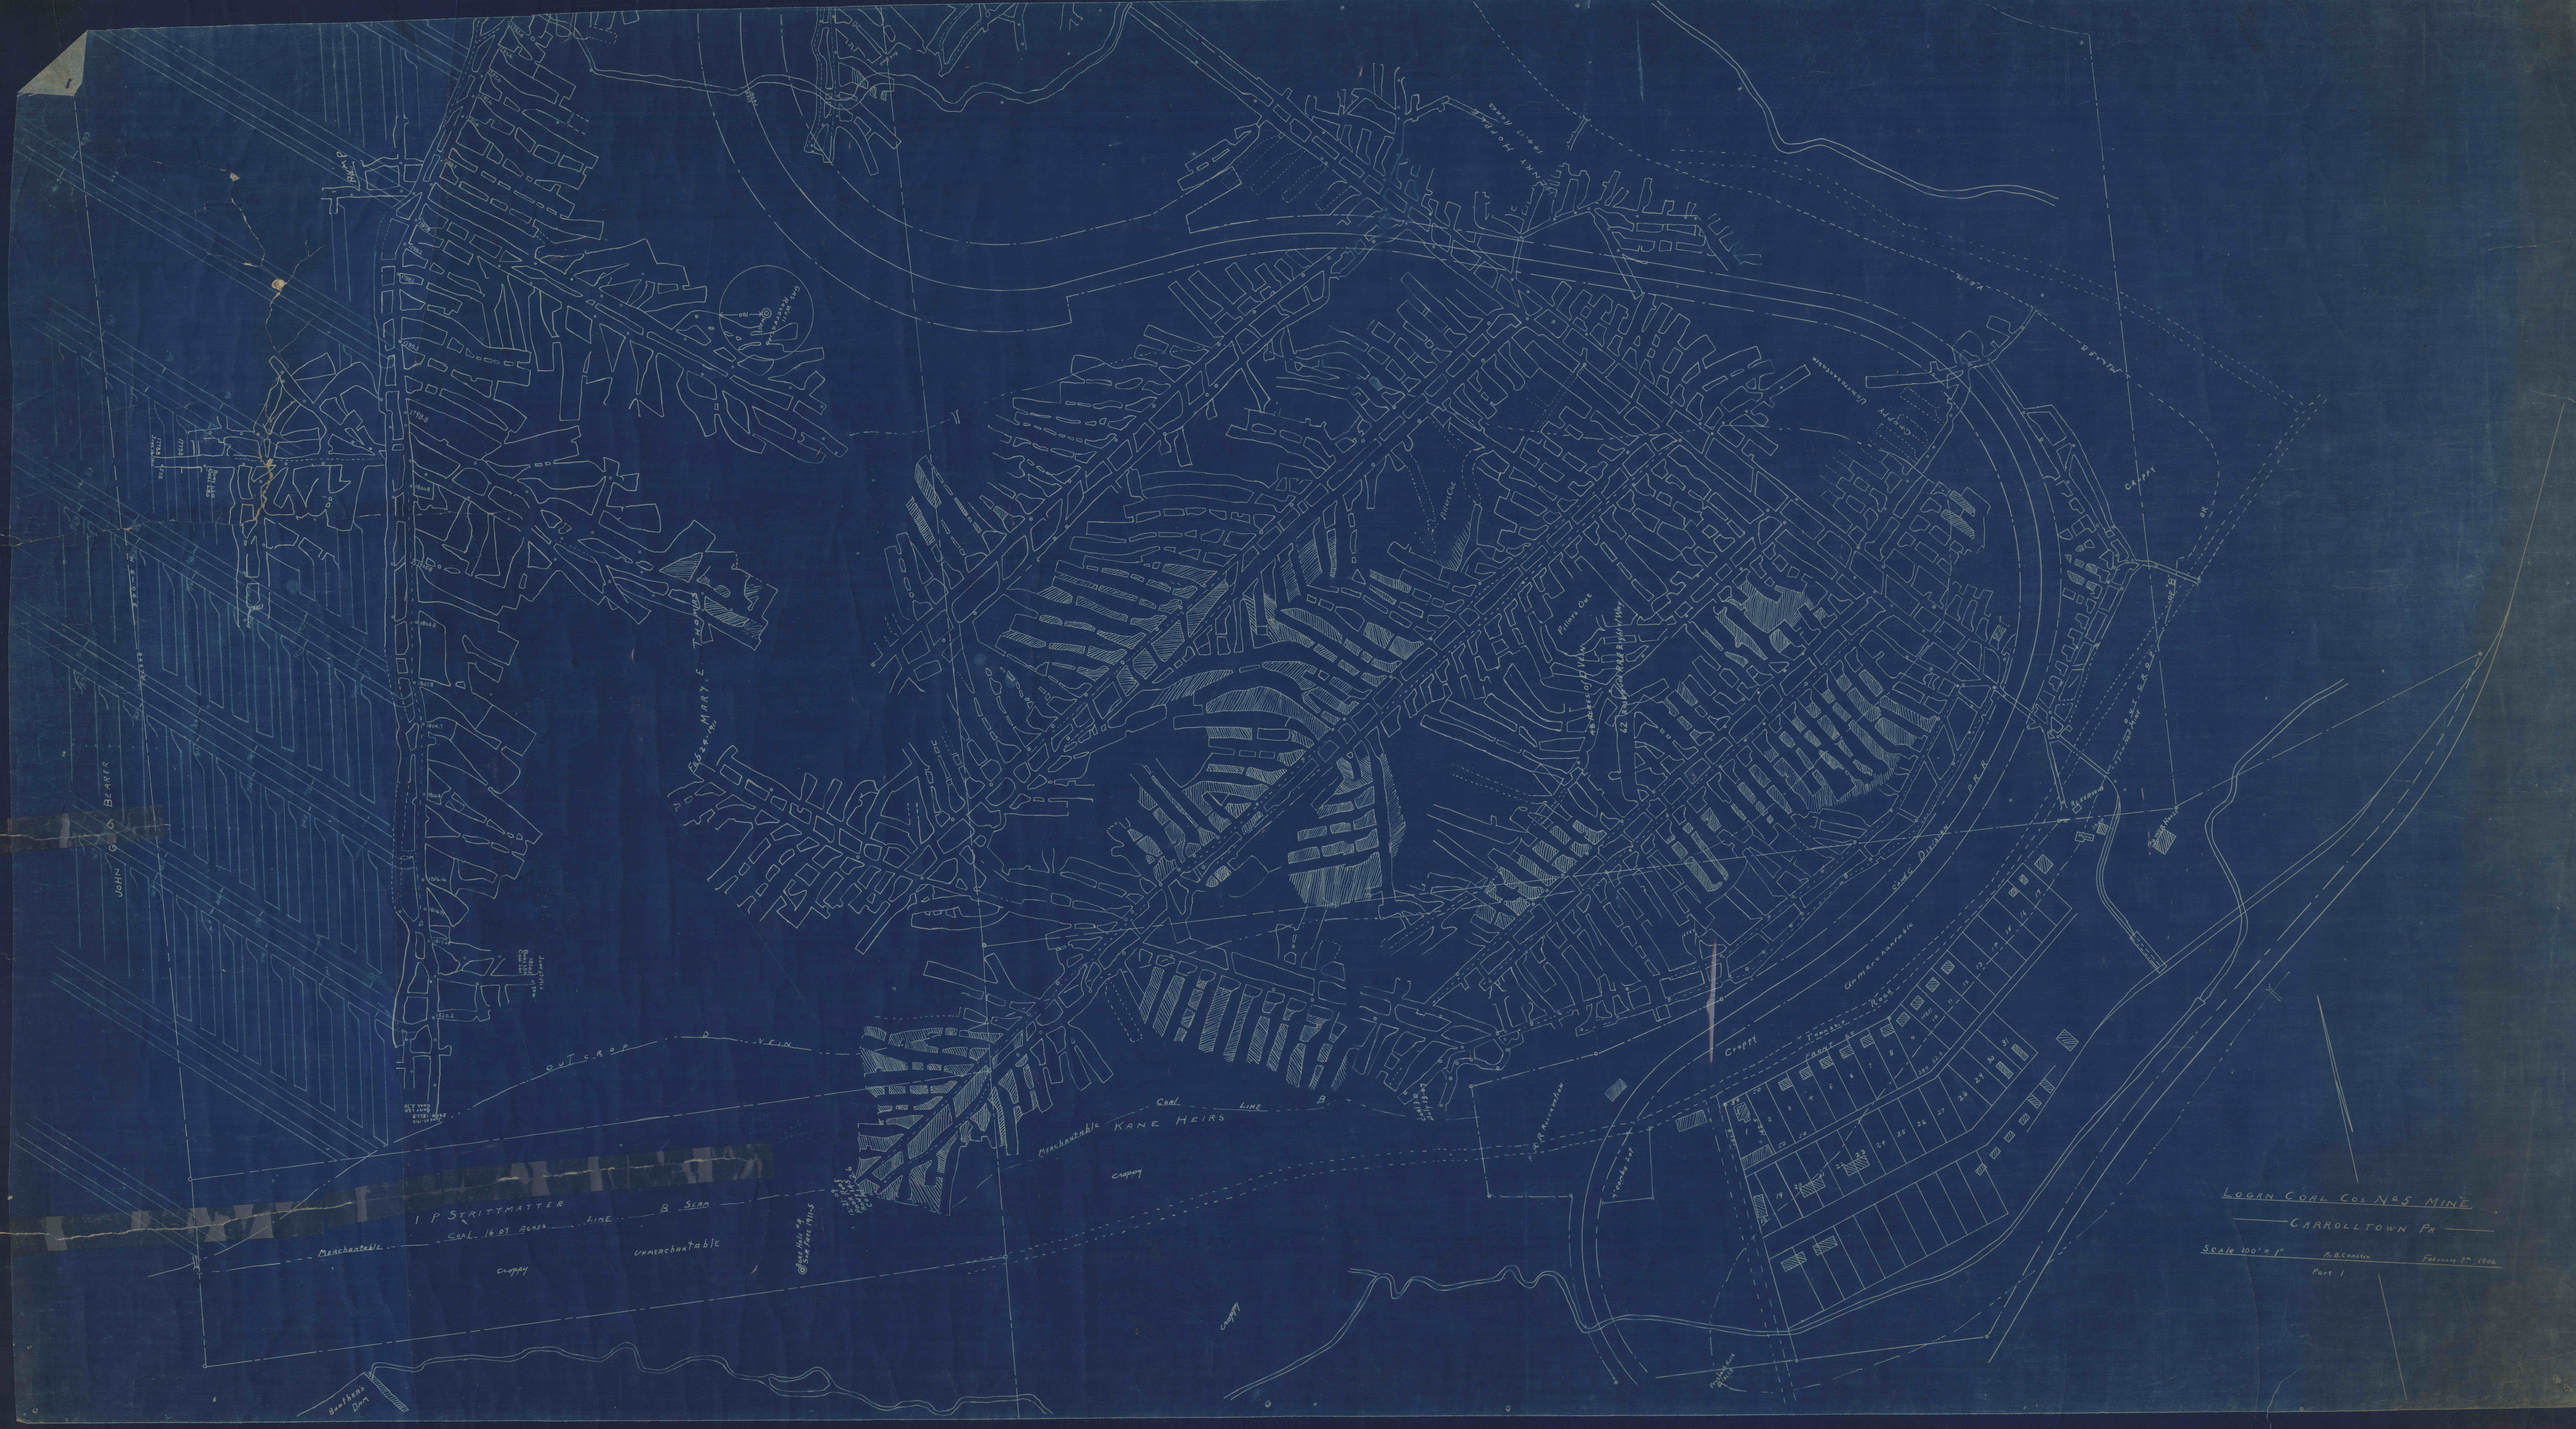
LOGAN COAL COS No 5 MINE
CARROLLTOWN PA
Scale 100' = 1"
A. B. Cashton
February 7th 1906
Part 1
KANE HEIRS
I. P. STRITTMATTER
Coal 16.07 Acres
Line B Seam
Merchantable
Unmerchantable
Croppy
Coal Line B
Outcrop D Vein
Pillars Out
Cade Division P.R.R.
Cade Division
Commerchantable
Bentham's Dam
John G. O. Bearer
Mary E. Thomas