



**CLOYD S. ROUDABUSH ET. AL.**  
 SHOWING PROPERTY & MINING OPERATIONS  
 IN THE  
**B SEAM OF COAL**  
 SITUATE IN  
 CONEMAUGH TOWNSHIP, CAMBRIA COUNTY, PENNSYLVANIA  
 July 31, 1928

Scale 1" = 100'  
 S. B. DeKeyser & Co.  
 Civil and Mining Engineers  
 Johnstown, Pa.

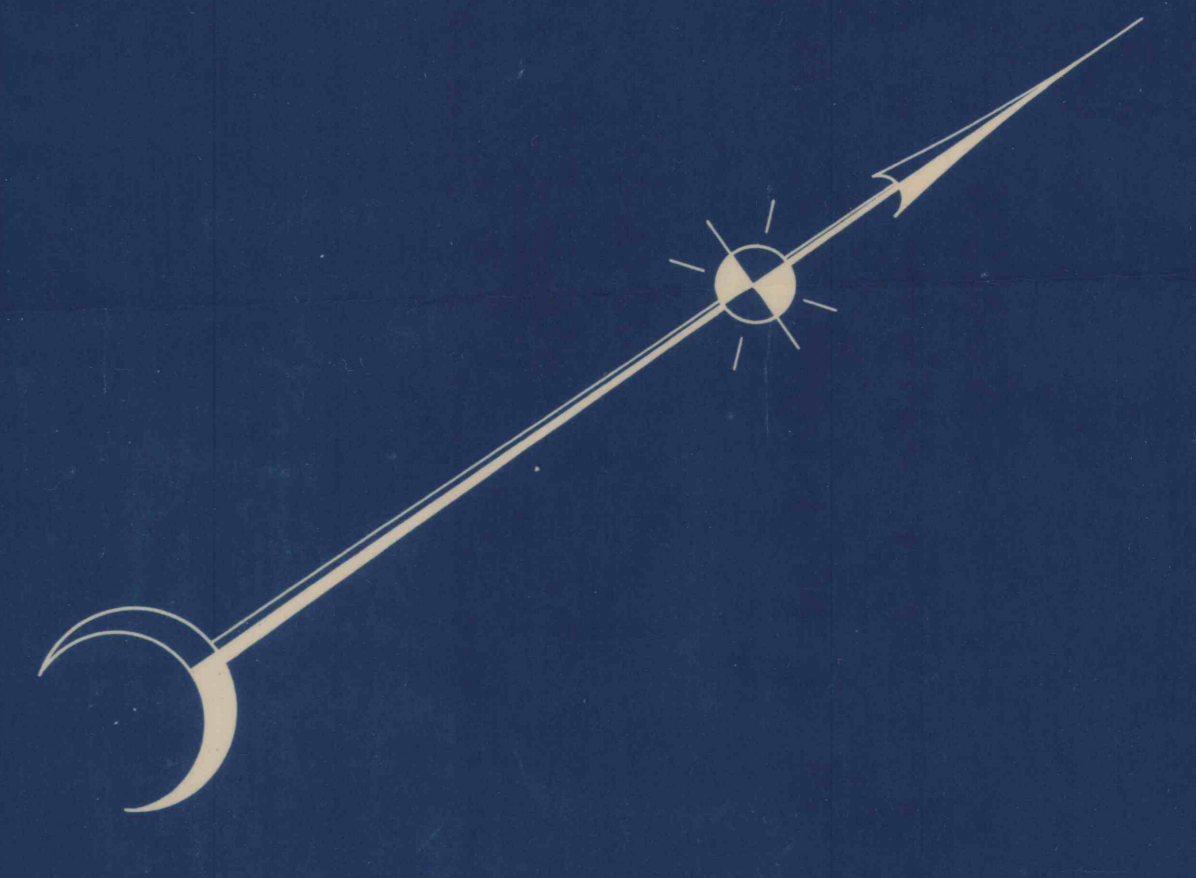

J. C. STINEMAN EST.

CAMBRIA IRON Co.

CAMBRIA IRON Co.

CAMBRIA IRON Co.

CAMBRIA IRON Co.

CAMBRIA IRON Co.

CAMBRIA IRON Co.

CAMBRIA IRON Co.

**INDEX TO SURVEYS**

Survey Letter	Date of Survey	Surveyed By	Plotted By
A	July 18, 1928	C. S. Roudabush	C. S. Roudabush
B	July 18, 1928	C. S. Roudabush	C. S. Roudabush
