



127

GRAMLING COAL CO.
MINING OPERATIONS IN UPPER FREEPORT SEAM,
SITUATE IN
STONYCREEK TWP. CAMBRIA CO., PA. Nov. 21, 1946
SCALE 1"=100'
LOYD W. HUFMAN R.S. #6242

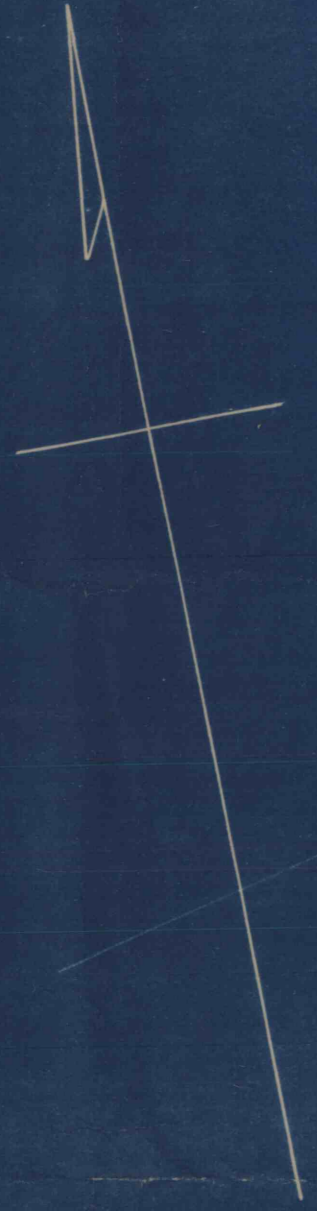

CAMBRIA - OCHTIE COAL CO.

MON. ST. MON.

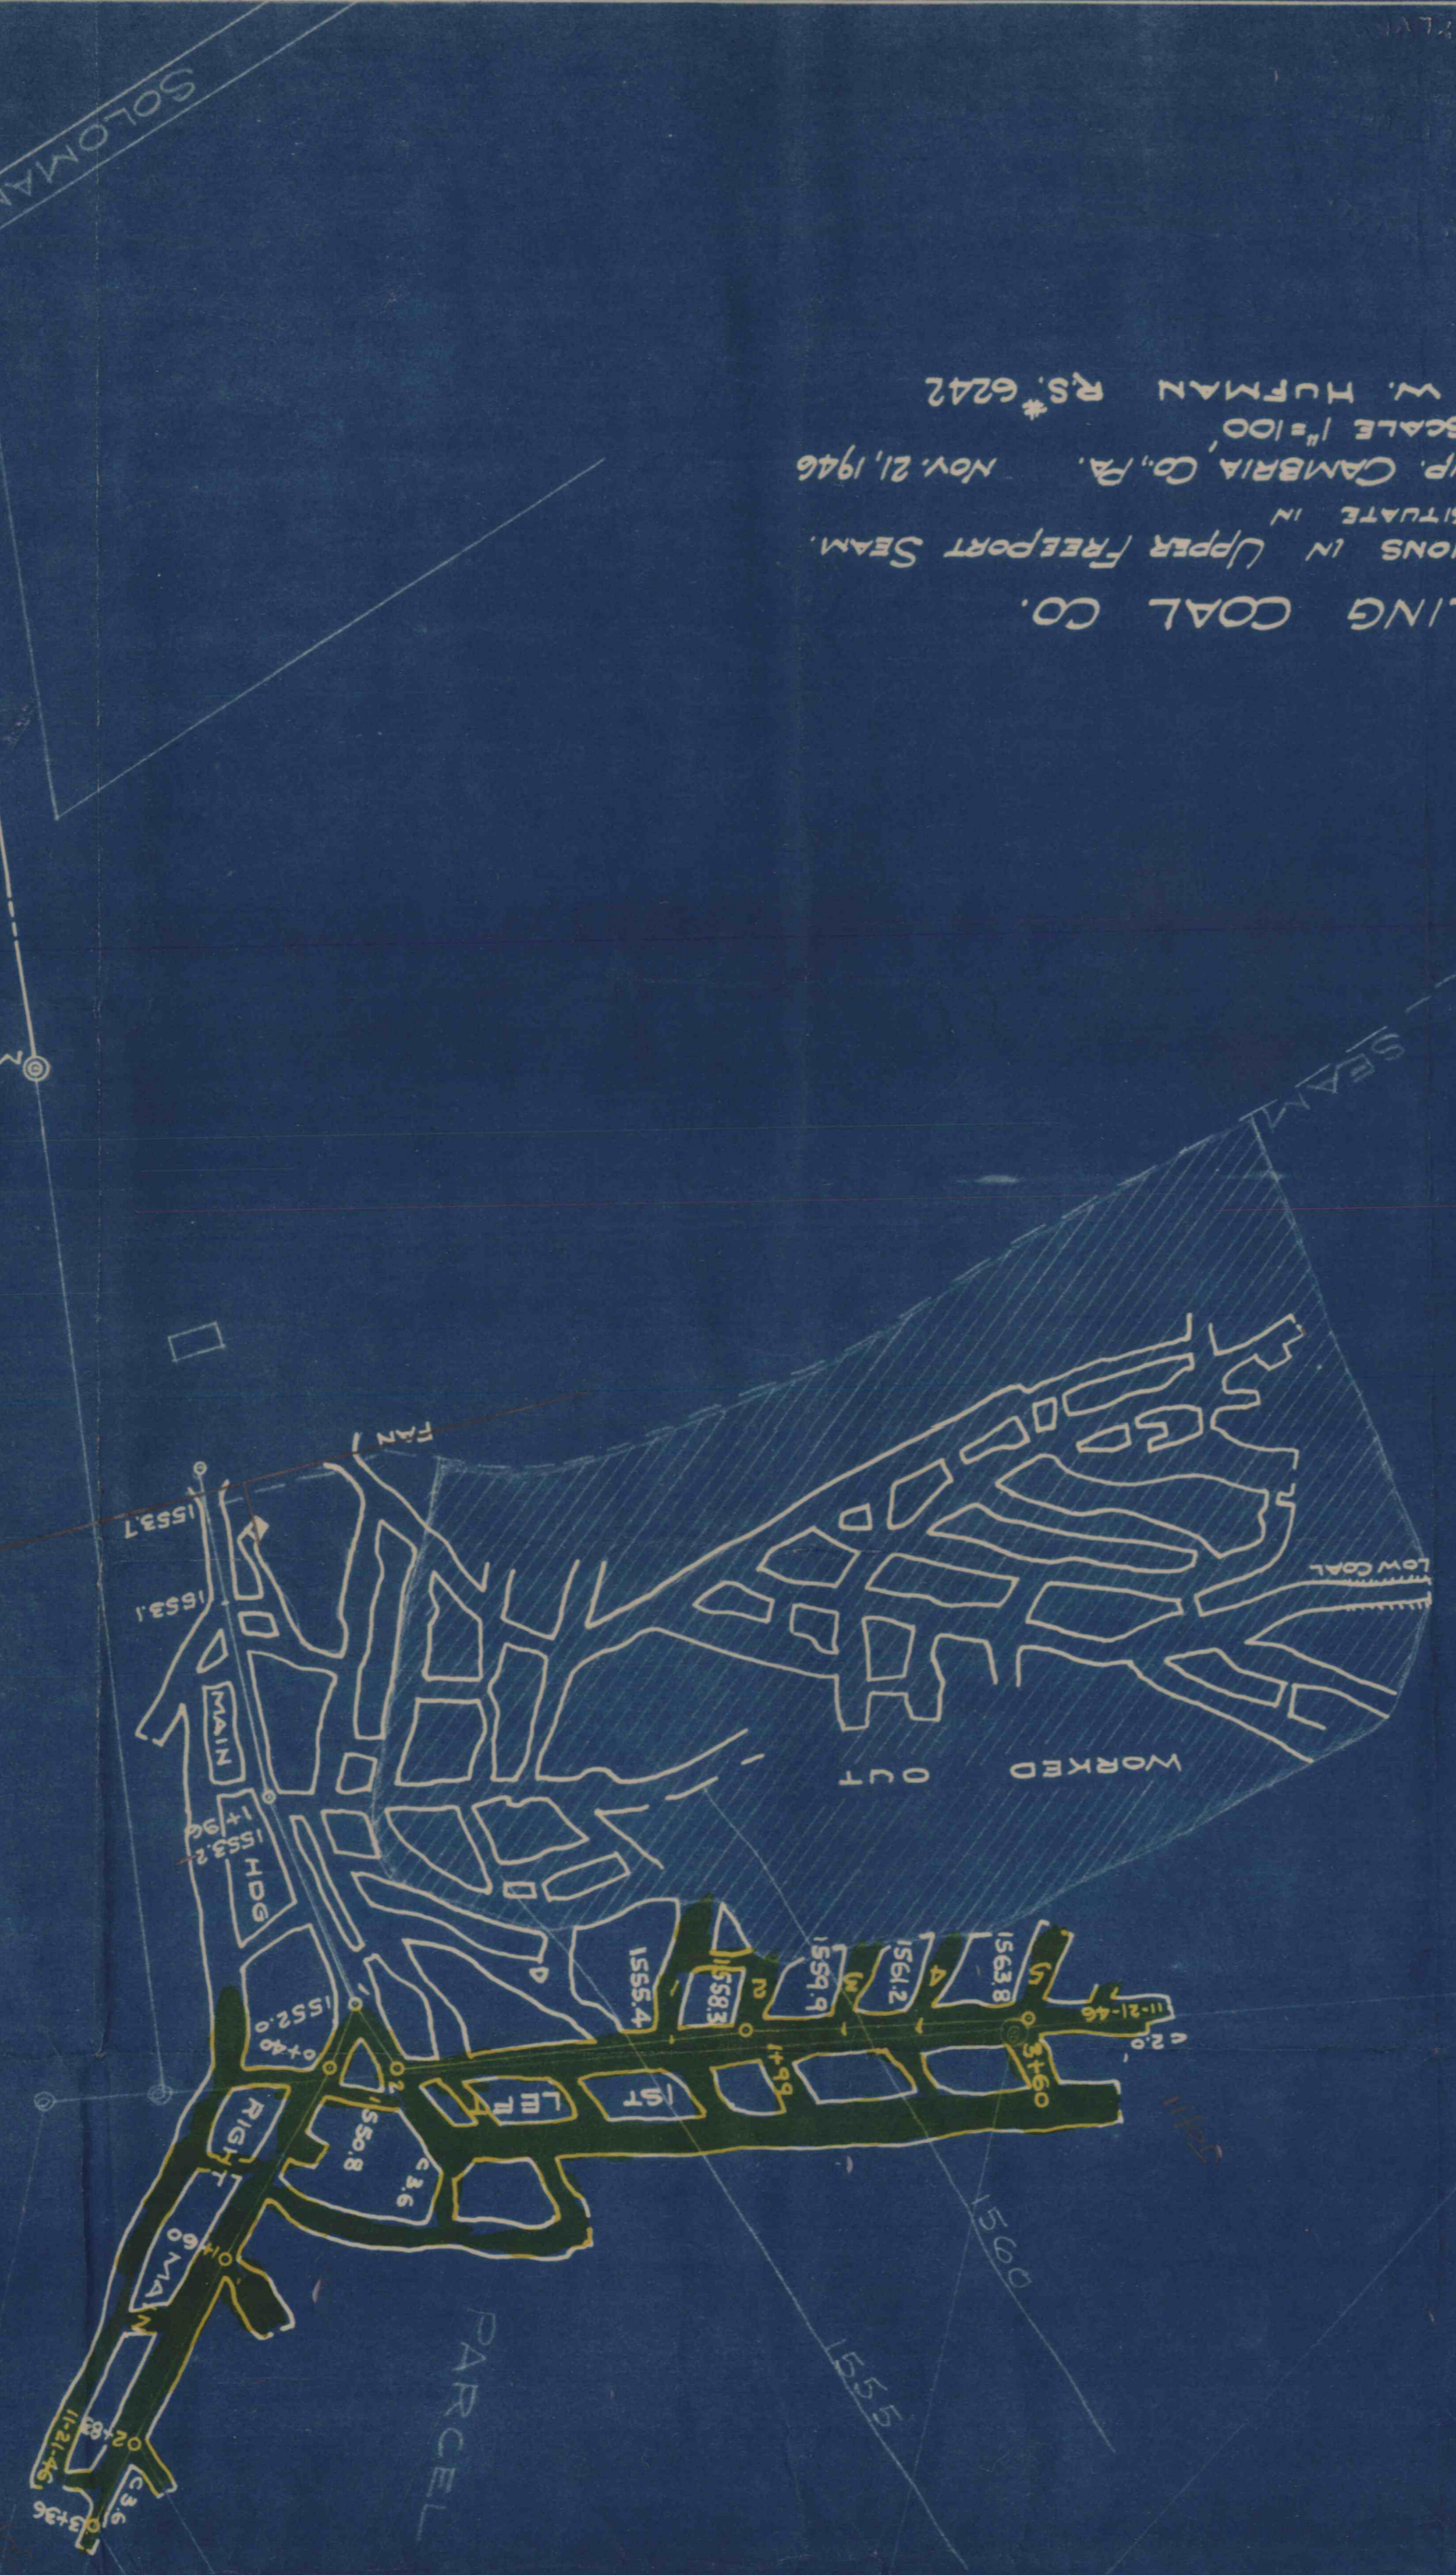

DANIEL YOUNKER
APPROXIMATE COURSE OF SEAM

W.M. GRIFFITH
R. L. GRIFFITH

HEADING
S 23° 00' W
418.50

GRIFFITH
PARCEL No 2

ELI
PARCEL No 1