

11.4




MIXING PLAN
 OF
STINEMAN COLLIERY NO. 2.
 OPERATED BY
STINEMAN COAL & COKE CO.
 SOUTH FORK, PA.
 SCALE 100 FT. = 1 IN. S. GETTYSBURG, PA.
 1903

LEGEND

SUSAN F. O'CONNOR

4

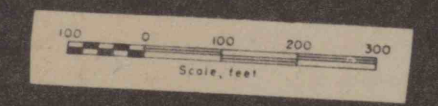

PDVMS 03065 494 36X 323398

71