



#71

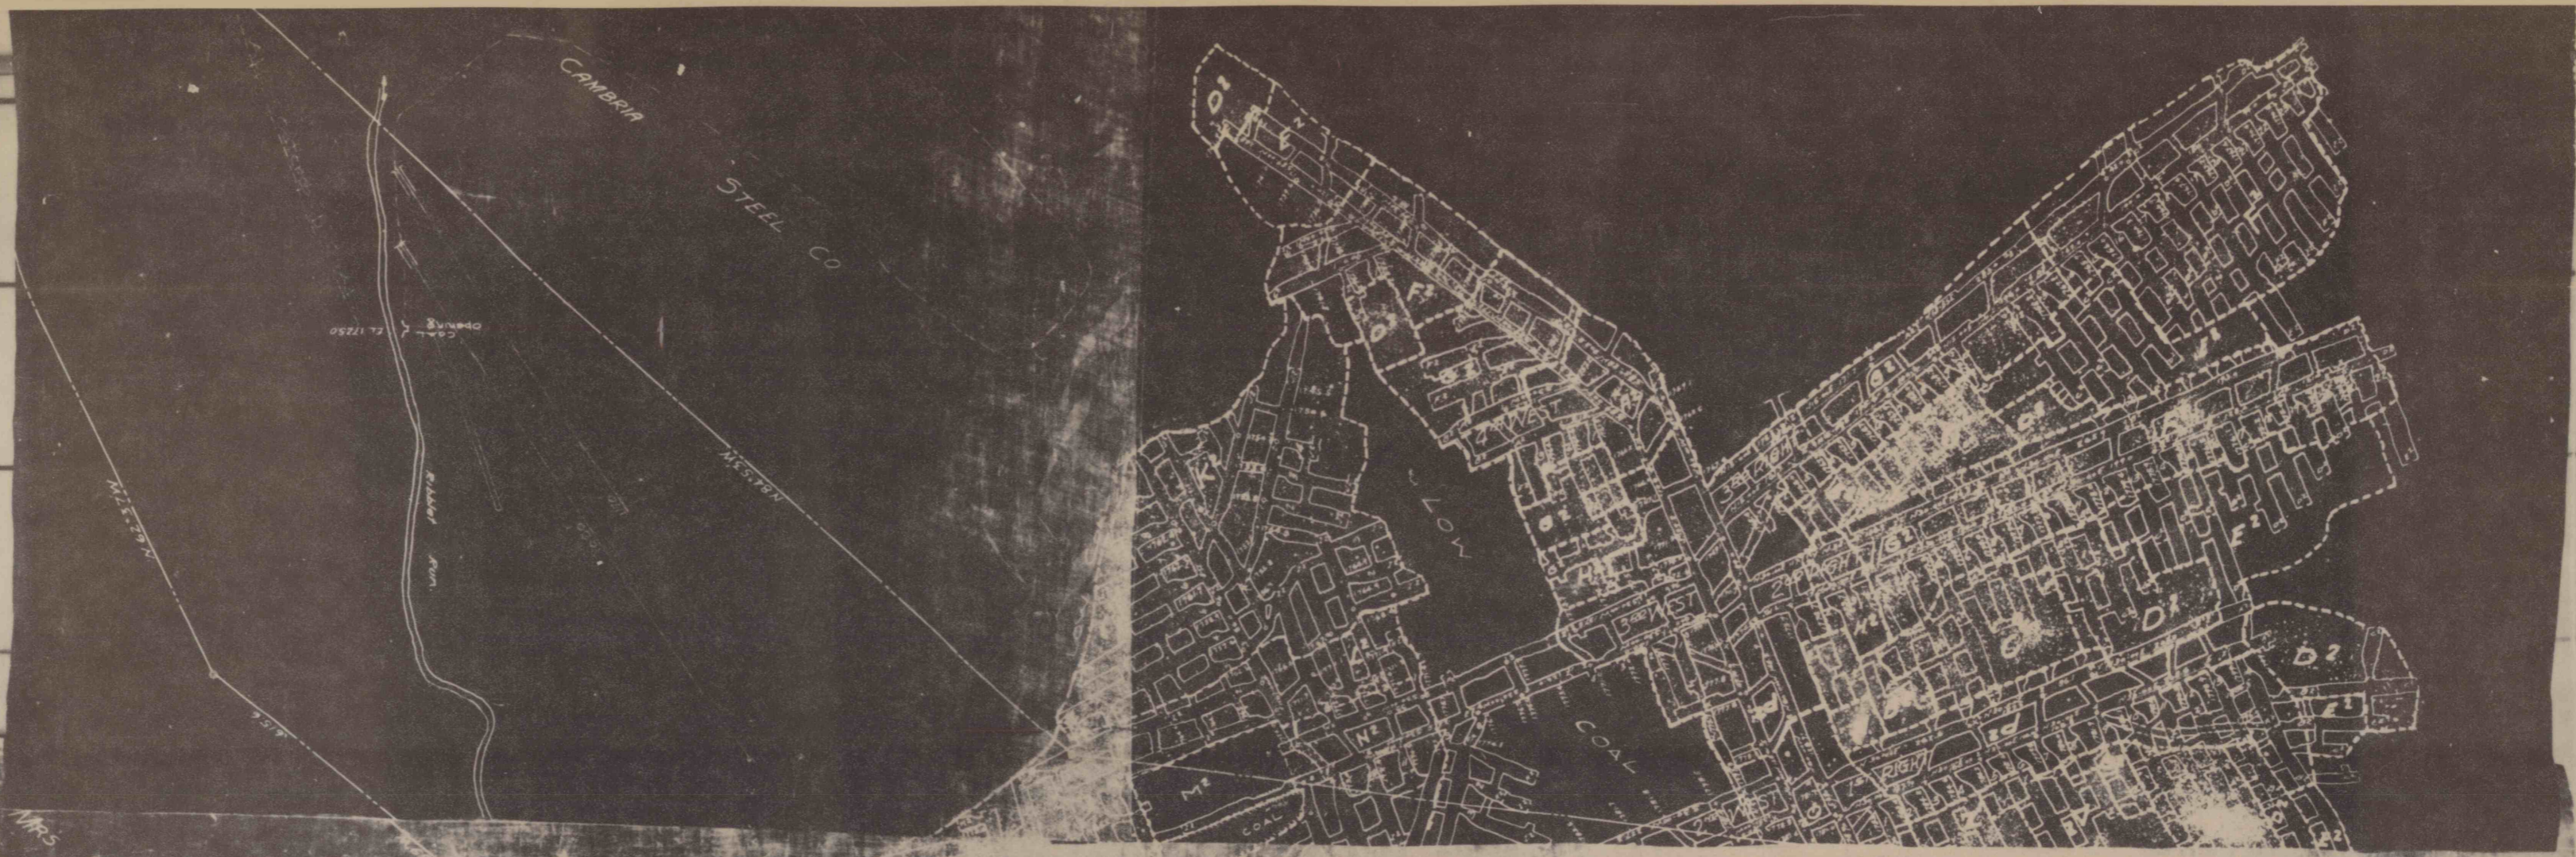

1941
 100 New
 Mine City
 Bureau of
 Maps

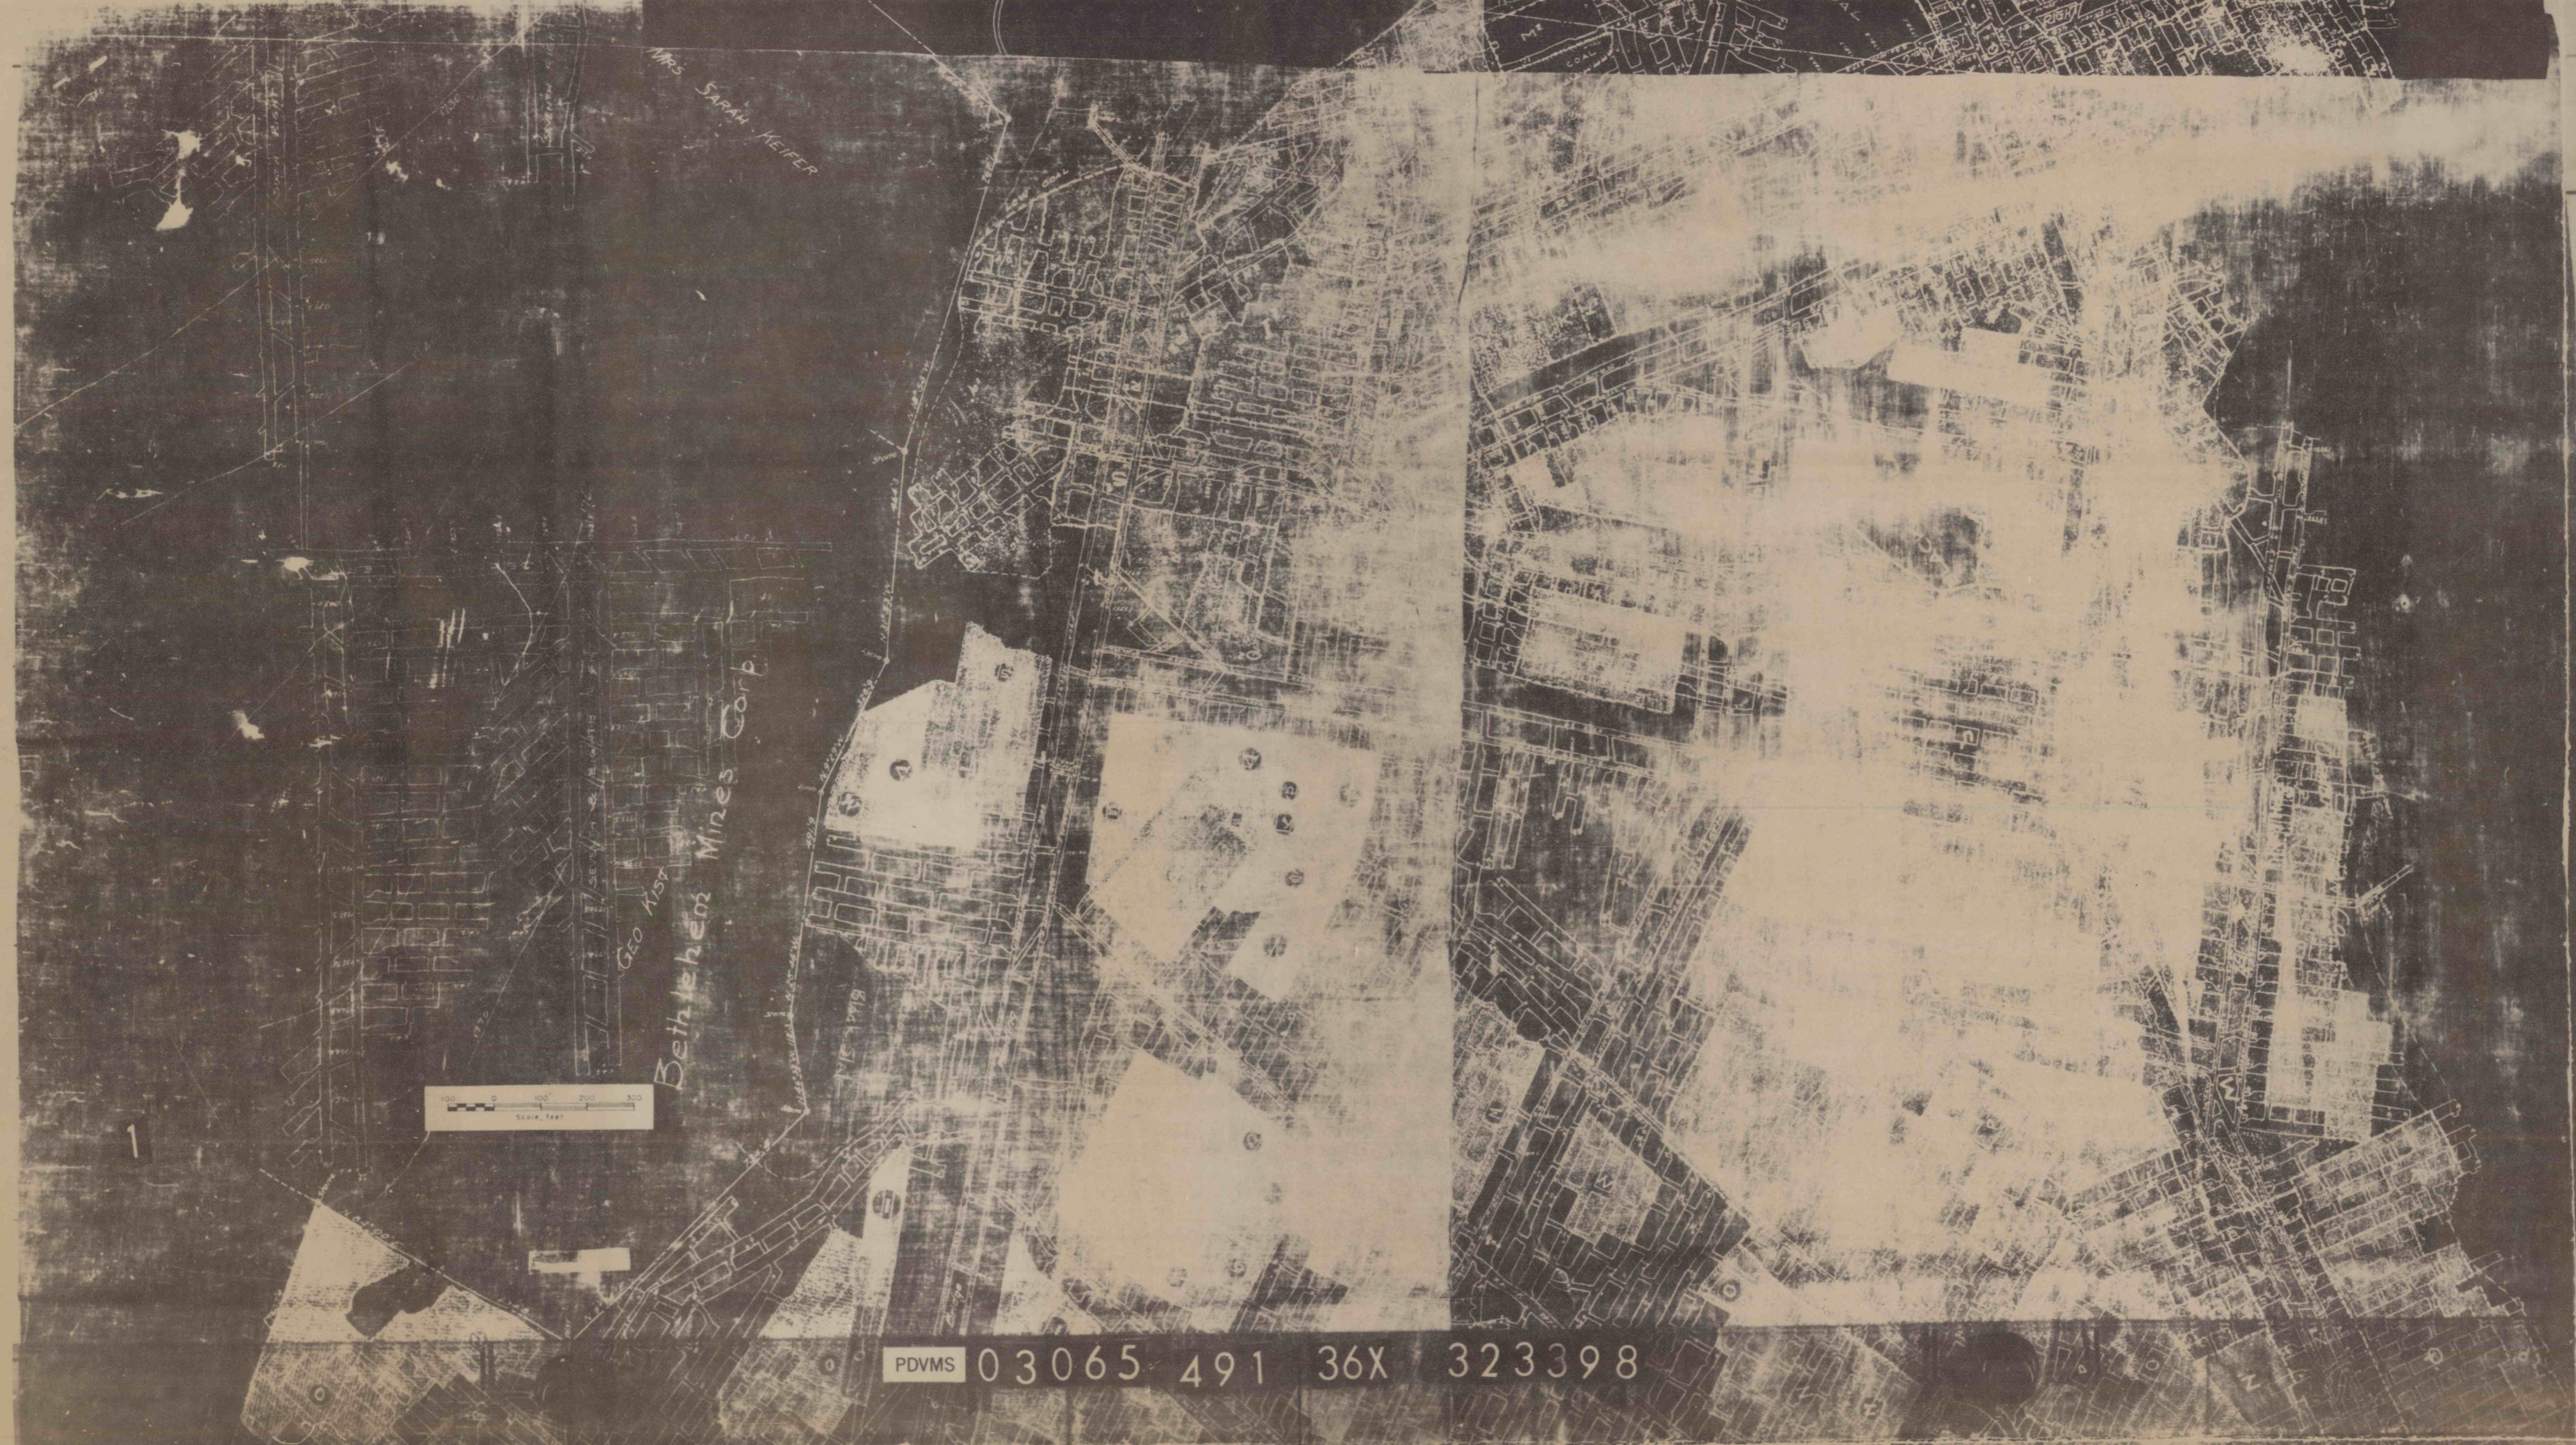

PDVMS 03065 491 36X 323398

71