


PLAN OF MINES

Price
Gallatin

STATE PARK LAND

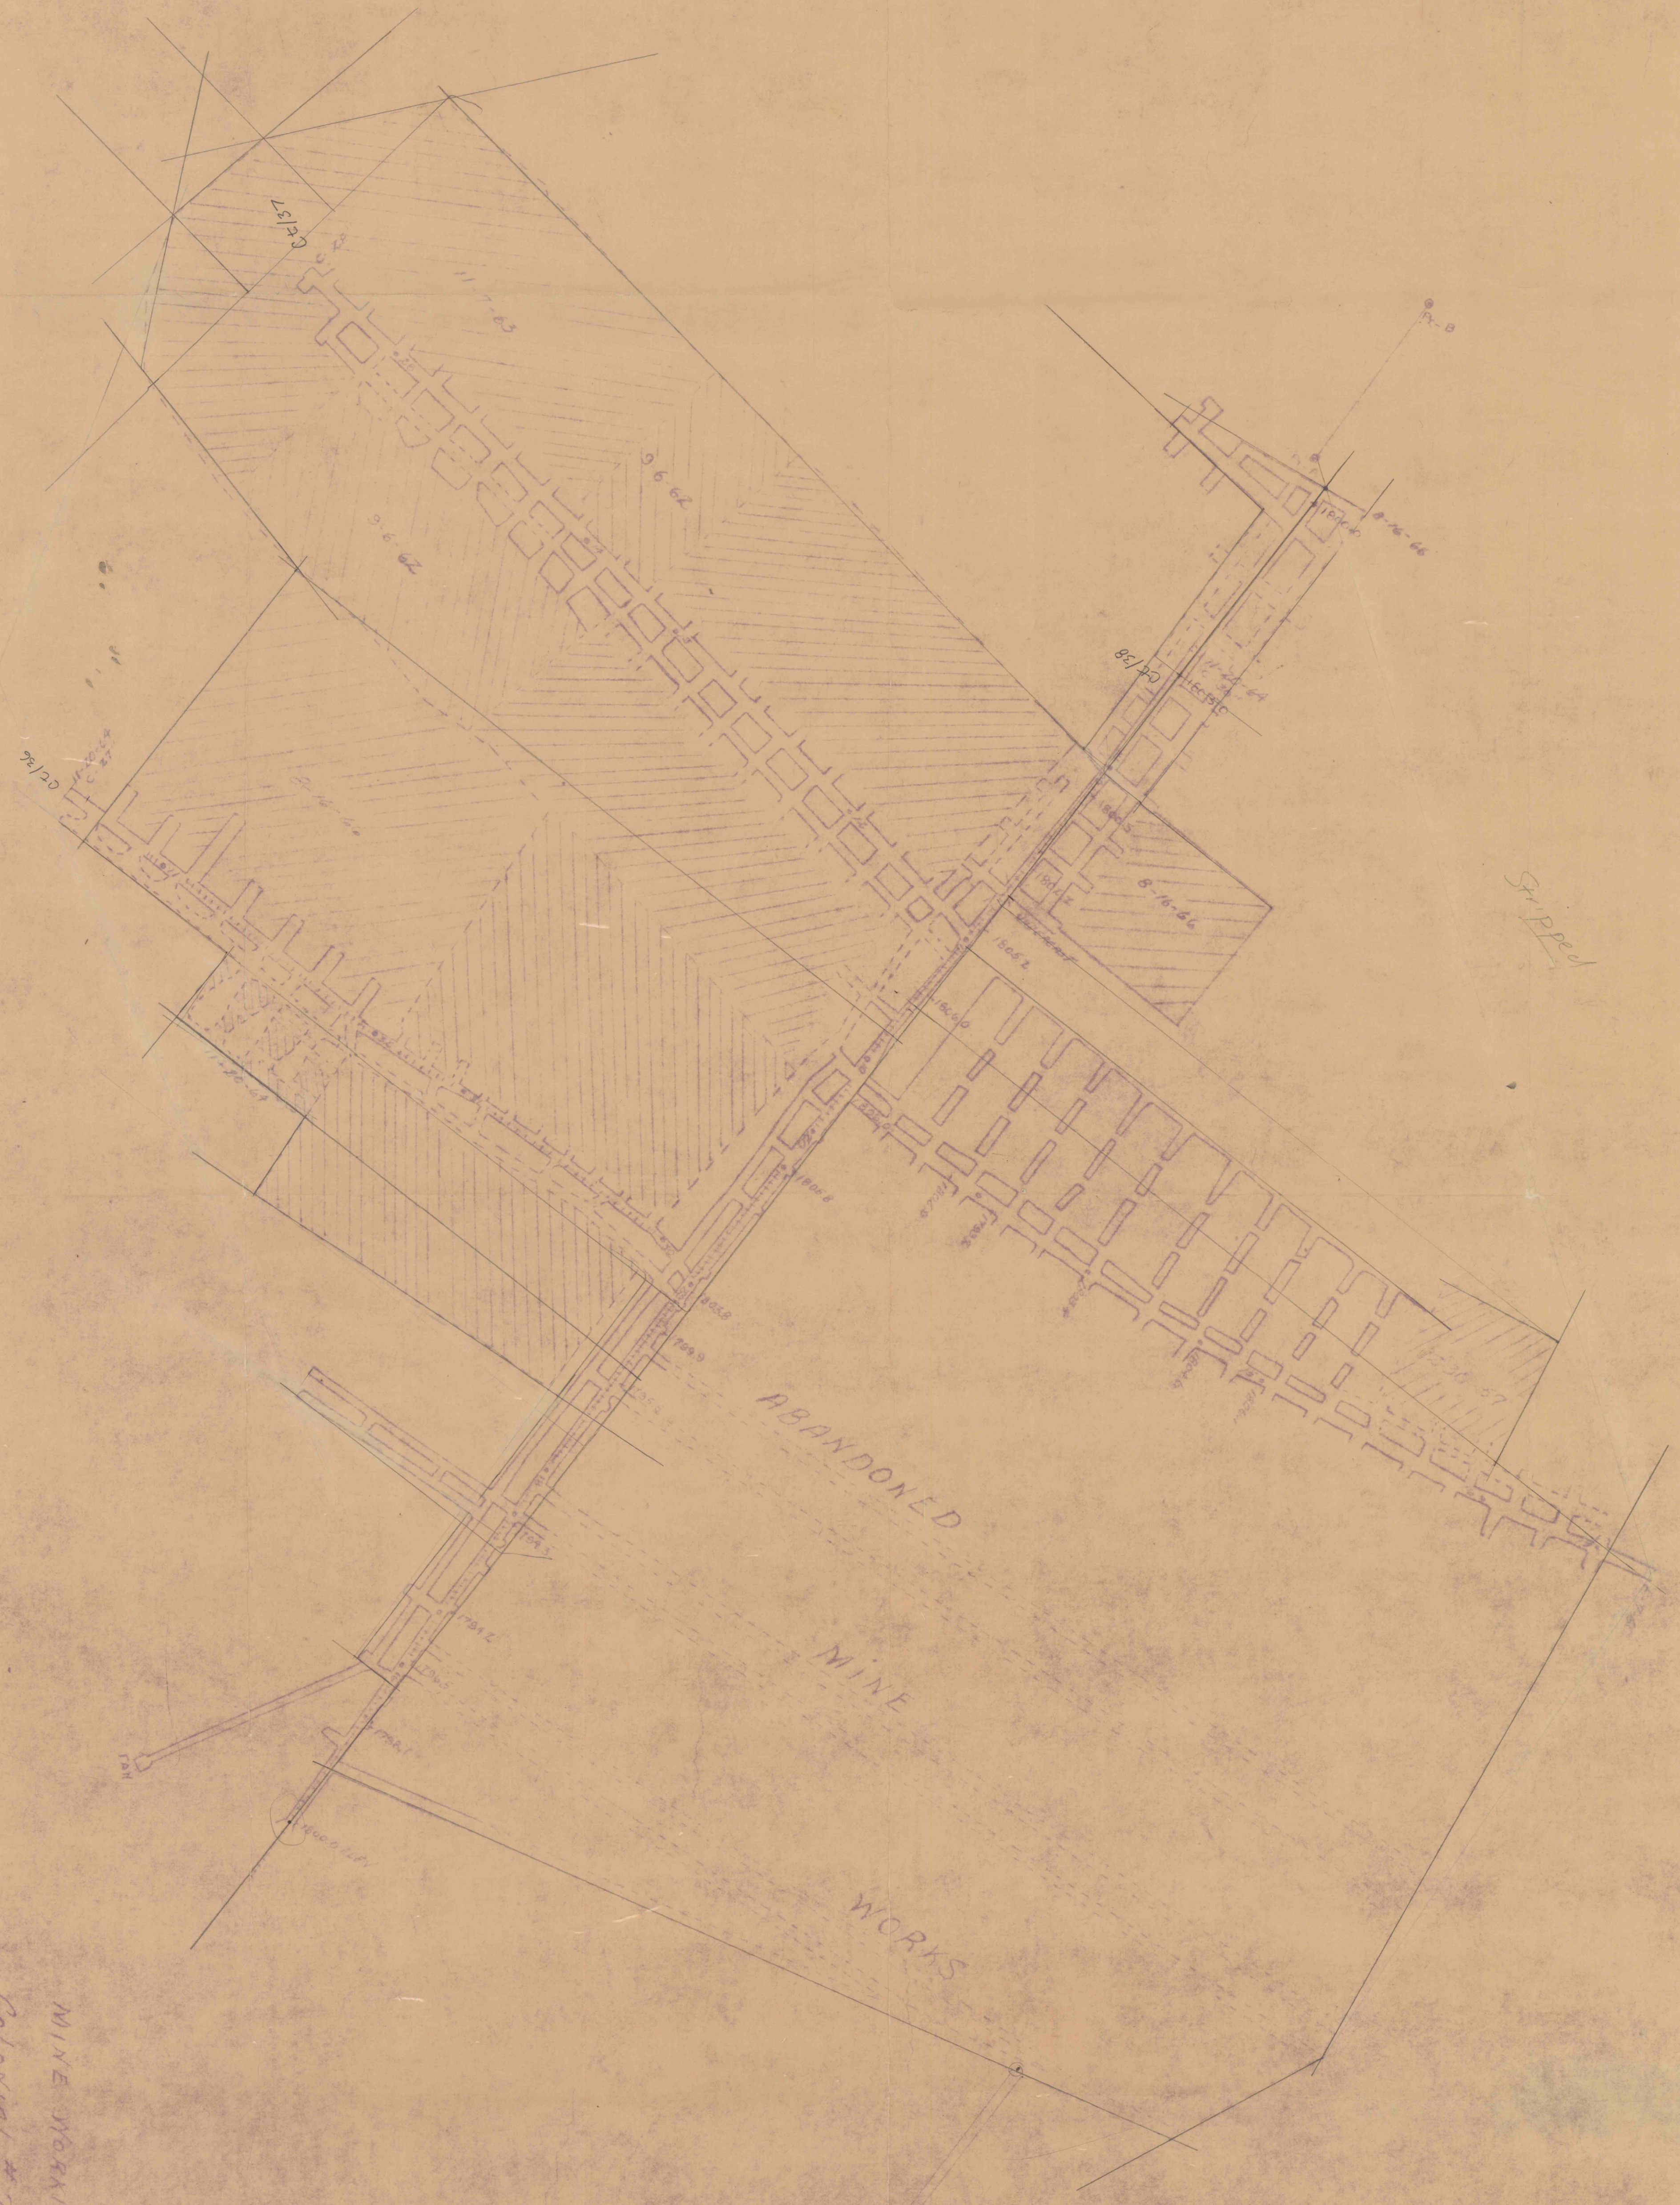

Striped

ABANDONED
MINE
WORKS

MINE WORKINGS OF C. AND O. CAL. CO. "E" SEAM
 COLONIAL #7 MINE
 SCALE 1" = 100' MAP FROM T. 8. N. 6. E.