


14TH CAMBRIDGE FUEL
SEAM MINE NO. 1
CARROLL TWP.
BERIA COUNTY PA.
N 1954
SCALE 1 IN. = 100 FT.
Map by G. A. ...

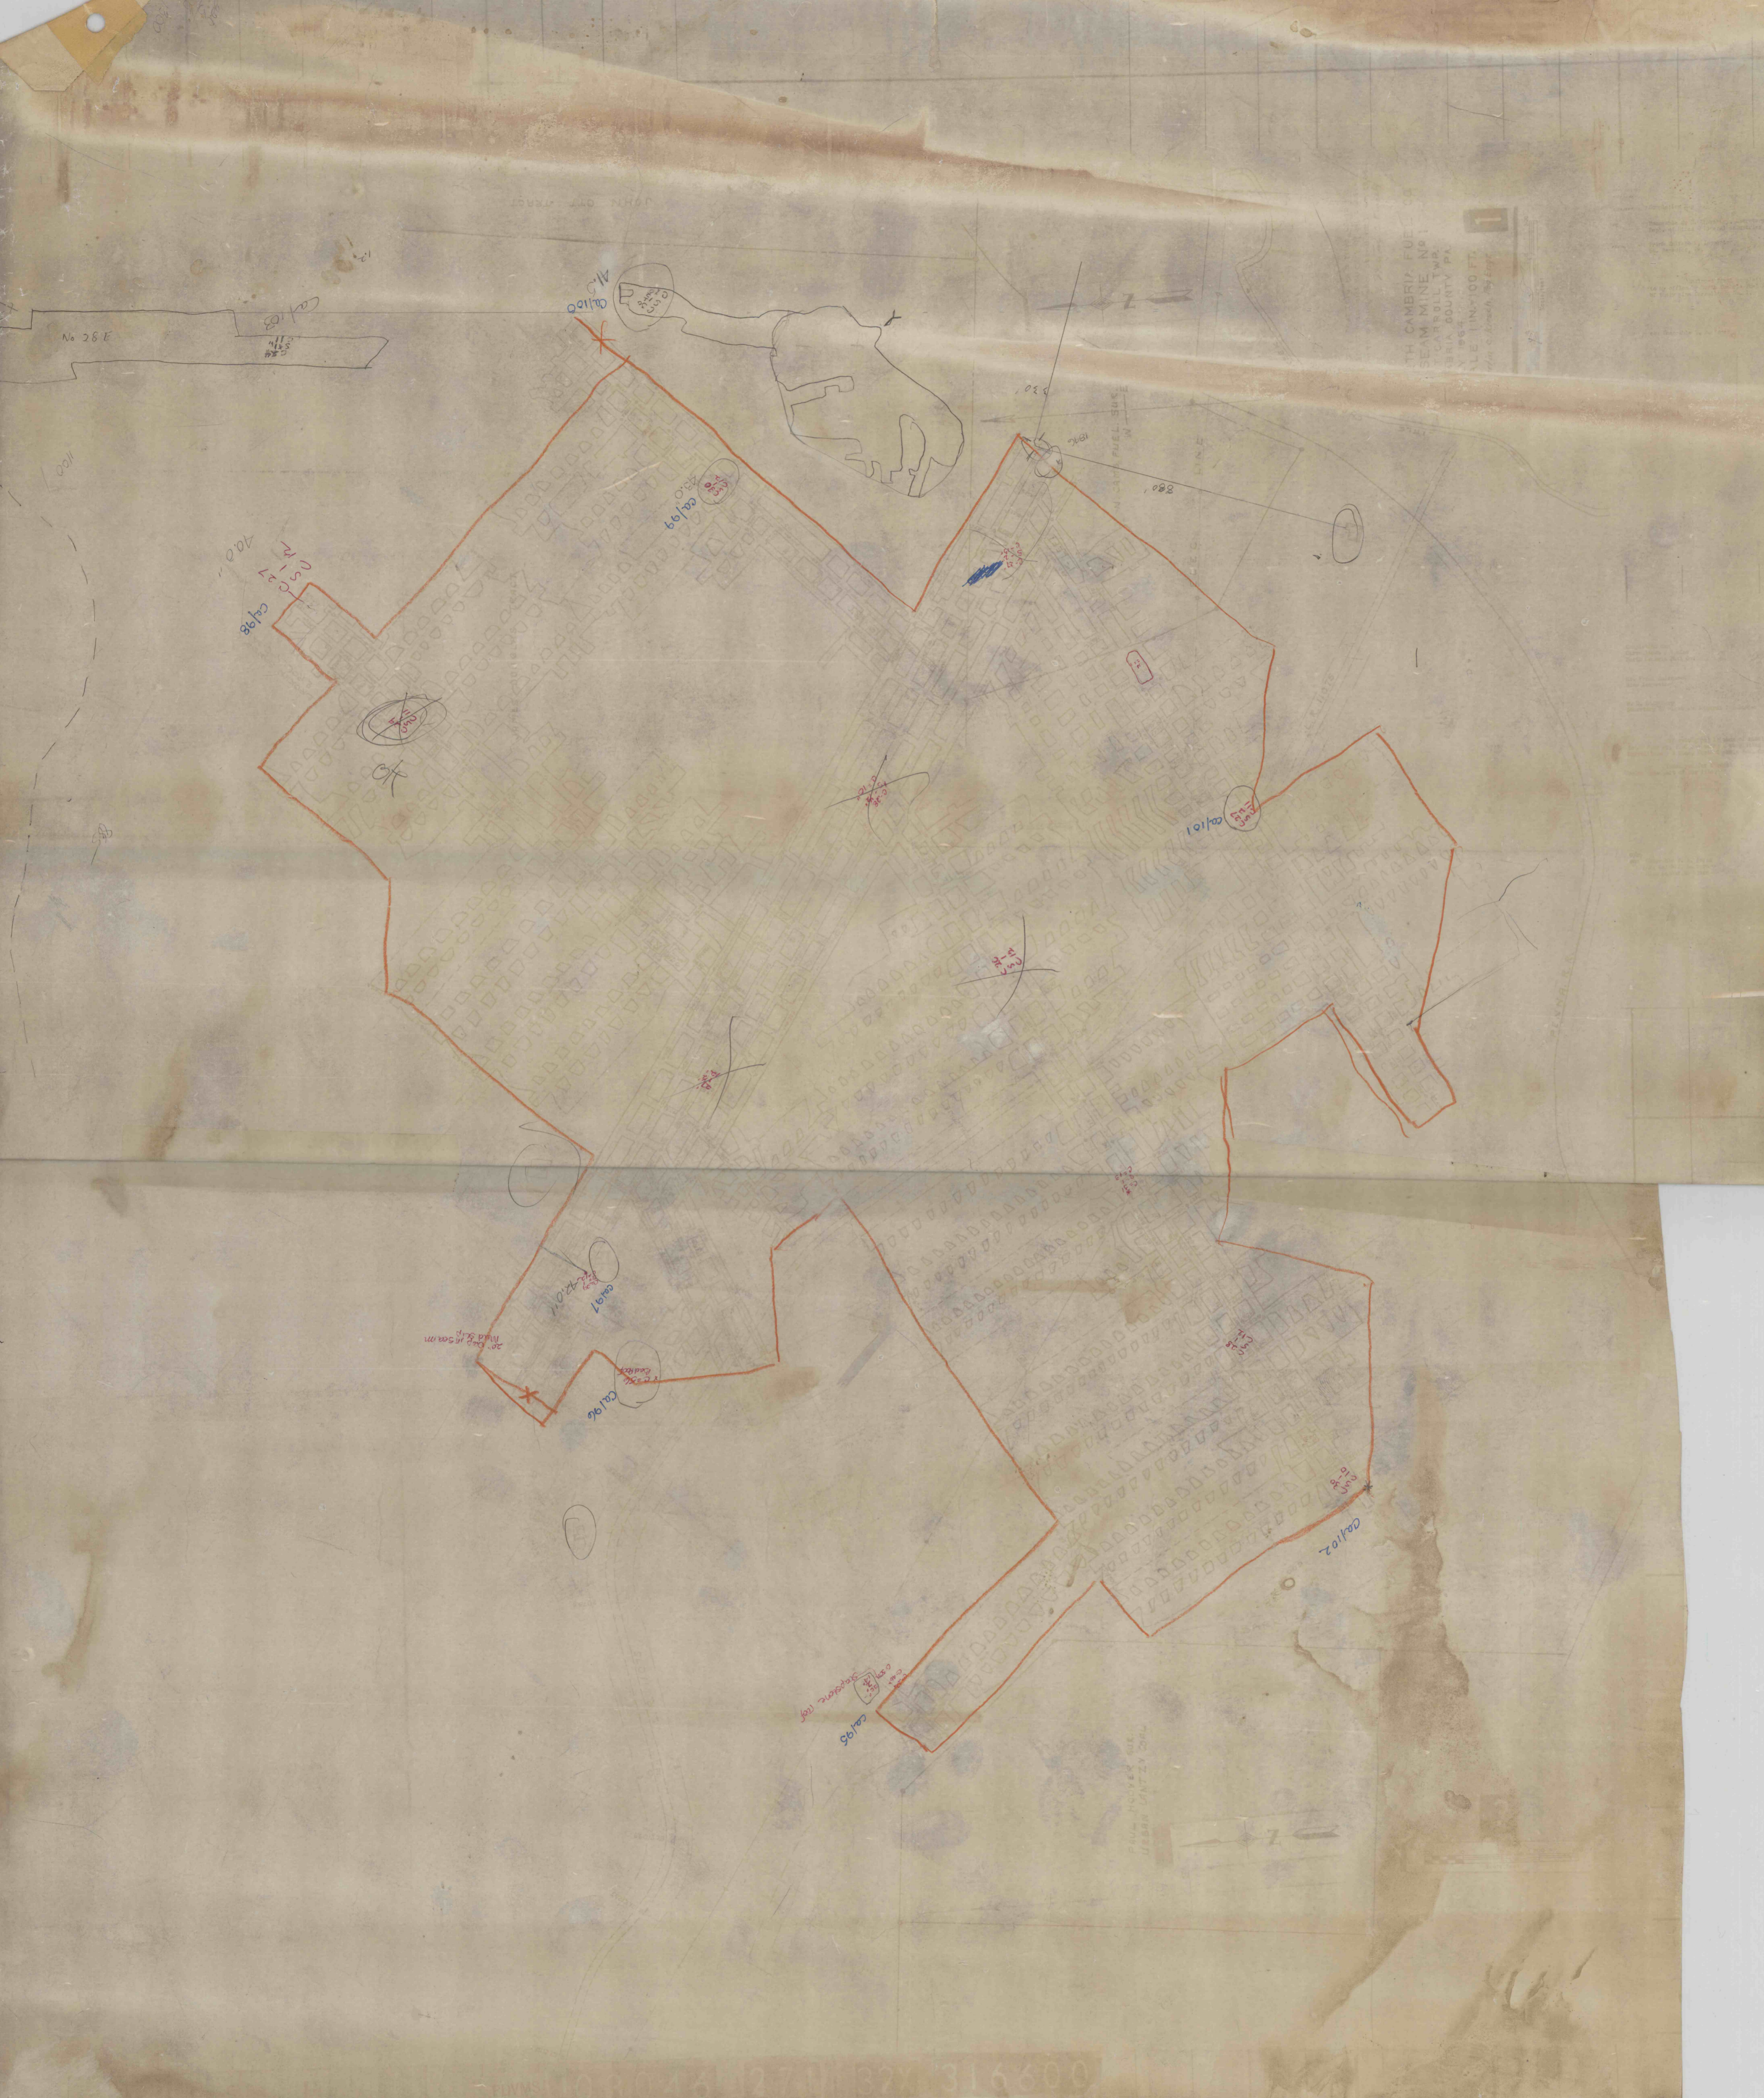

No 28 E

OS
N
100'
CAL 98

CAL 100

CAL 99

CAL 101

CAL 97

CAL 96

CAL 102

CAL 95
Separate ref.

20' Dip in Seam
Toward S.W.

OK