


171-92

LOCUS BED-FIELD

**C. PRIME SEAM**  
**MOXHAM COAL Co**  
 SHOWING MINING OPERATIONS OF  
**Thermal Mine No. 3**  
 Situate in  
 17TH WARD, JOHNSTOWN, PA.  
 Scale: 100' = 1" J. S. & Co., Feb. 2, 1917.  
 Civil & Mining Engineers  
 Johnstown, Pa.

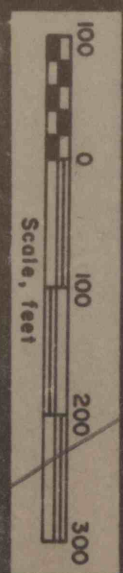

INDEX TO SURVEYS

Letter	Date	Surveyed by	Plotted by

03009 7 22X 302870