
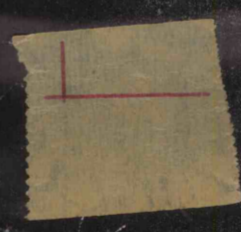
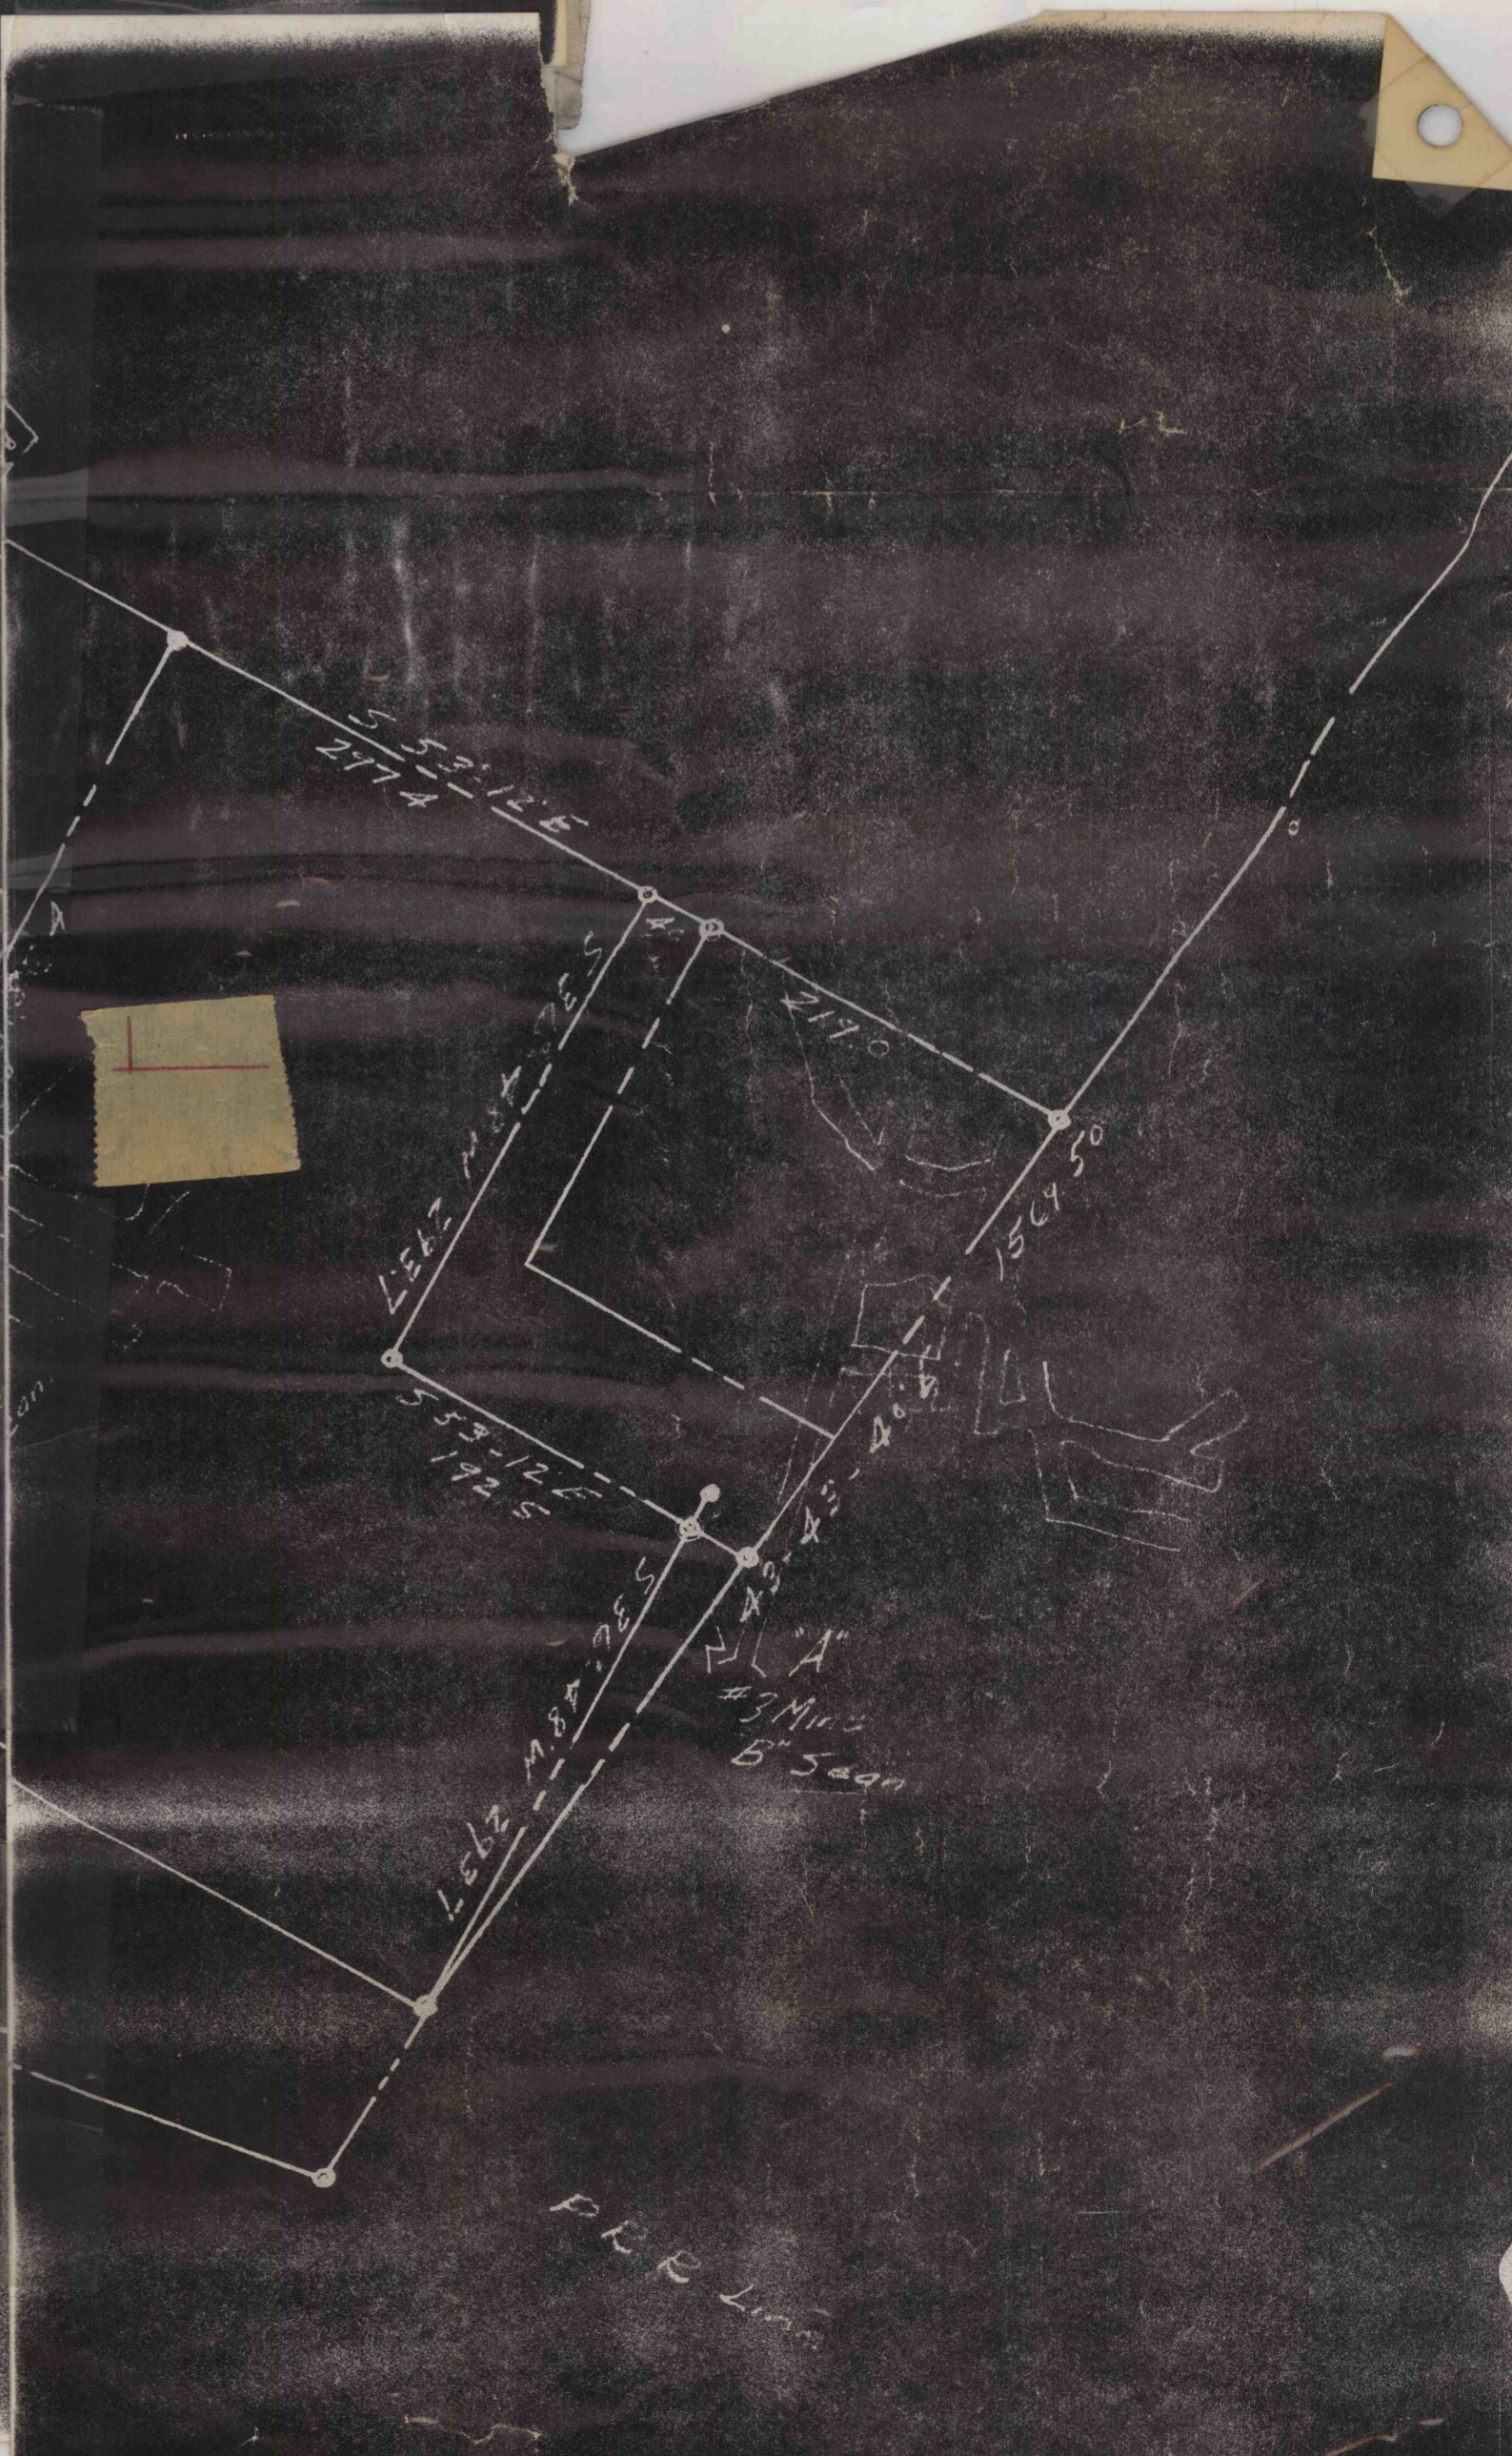
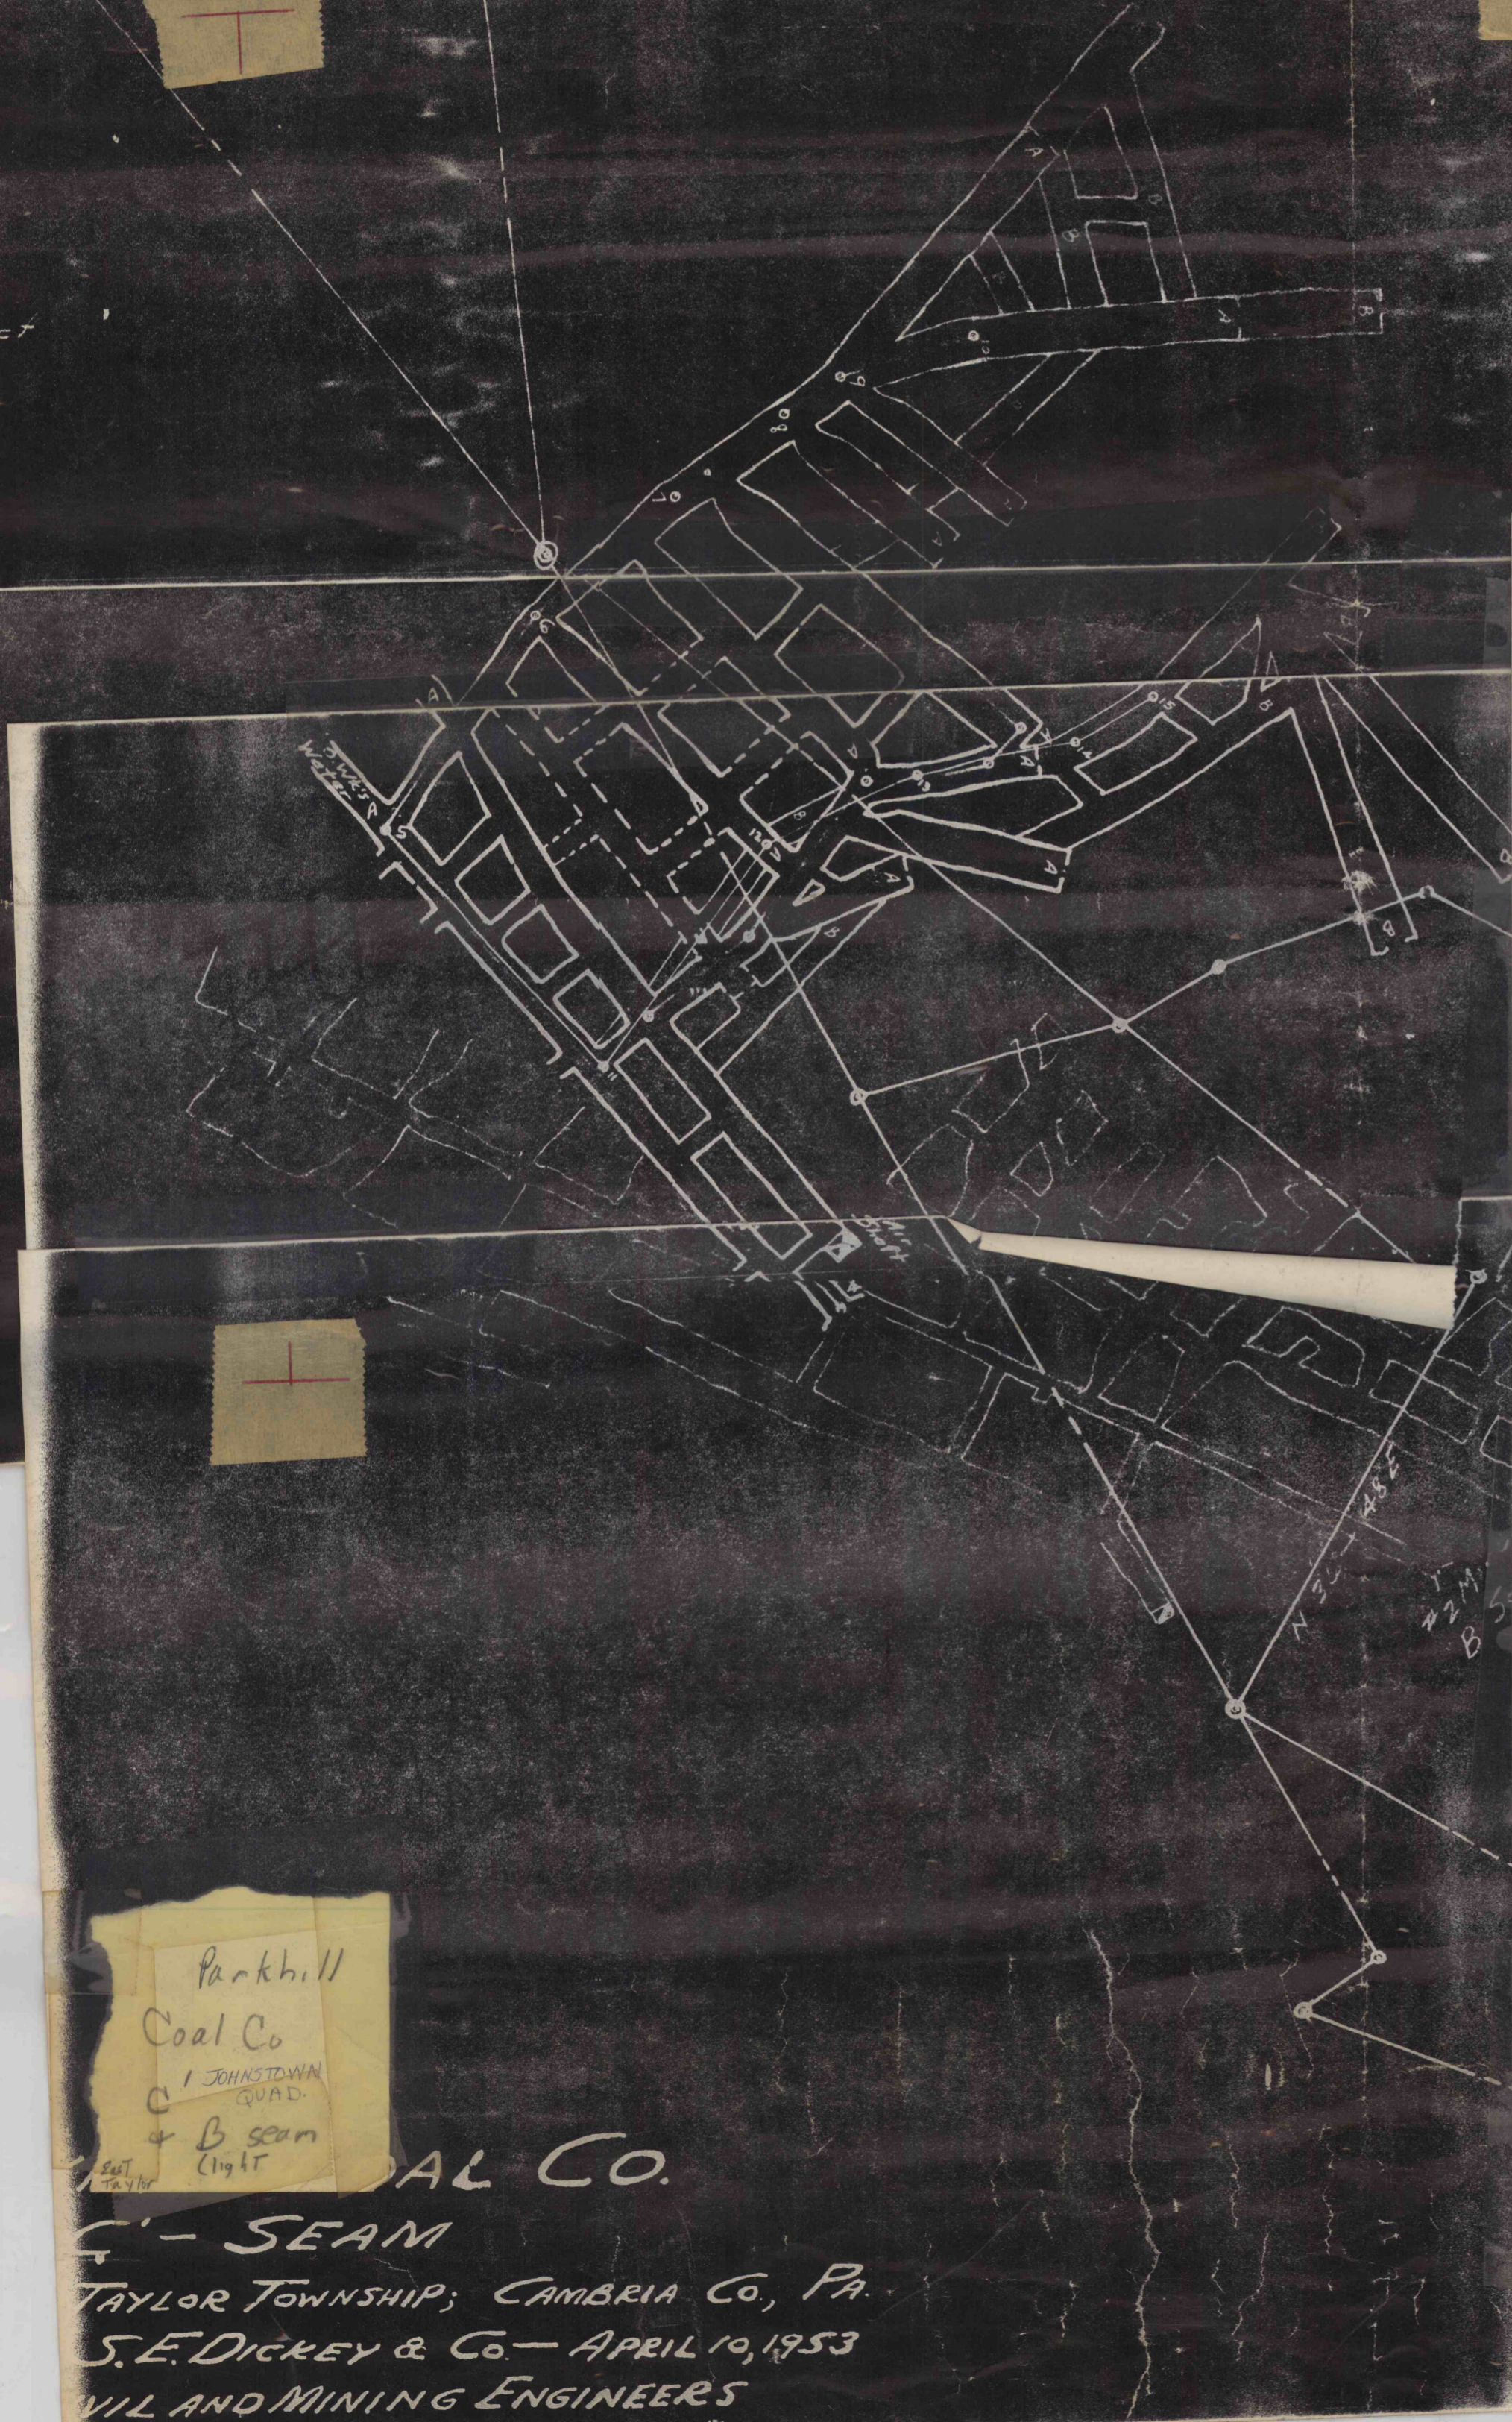


Cambria Iron Co. Tract
92.52 Acres

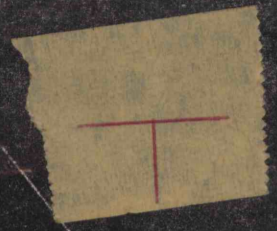

Parkhill
Coal Co
1 JOHNSTOWN
QUAD.
C
& B seam
light

COAL CO.
G' - SEAM
TAYLOR TOWNSHIP; CAMBRIA CO., PA.
S. E. DICKEY & CO. - APRIL 10, 1953
CIVIL AND MINING ENGINEERS