

PART OF
 DYSSERT & LAUGHMAN TRACT
 35.33 TRACT ACRES

ELEV. 1666

STRIKE N 28° E

DISCHARGE POINT AT JAMESTOWN
 ELEV. TOP W.B.H. 1666
 ELEV. BOT. W.B.H. 1225
 ELEV. TOP OF SONMAN'S KIEL W.B.H. @ Portage
 1613.3

BEAR ROCK COAL CO.
 ROCK HEADING COLLIERY

EXHIBIT "A"
 POWER B.H.


EXHIBIT NO. 2
 D.D.M. 1
 Elev. Surface 18
 Elev. Coal 17

BENS CREEK SHAFT
 WORKINGS

SCALE 1"=100'

MAP SHOWING
 THE WORKINGS OF HUGHES NO. 2 SLOPE
 IN PART OF THE DYSSERT & LAUGHMAN TRACT
 OPERATED BY HWZ COAL COMPANY
 PORTAGE TOWNSHIP, CAMBRIA COUNTY, PENNSYLVANIA
 SCALE 1"=100'
 WORKINGS TO Jan. 31, 1967

LEGEND
 BOUNDARIES OF SURFACE ———
 MINING OPERATIONS COMPLETED None
 PROPOSED WORK UNDER PERMIT ———
 PROPOSED WORK NEXT SIX MONTHS ——— 3-15-69 to 9-15-69
 PERMIT No. 232-1

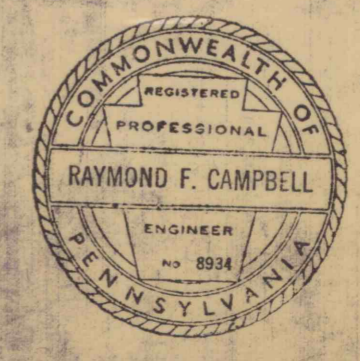

HUGHES NO. 2
 SLOPE. 164 EL. 1861.94