

MINING COMPLETED

MINING COMPLETED

MINING COMPLETED

MINING COMPLETED


CLEARFIELD BIT. COAL CORP. FEE

STRENGTH BARRIER

Moss Creek

EARL PERSHIN FEE

CARL E. GRAY FEE

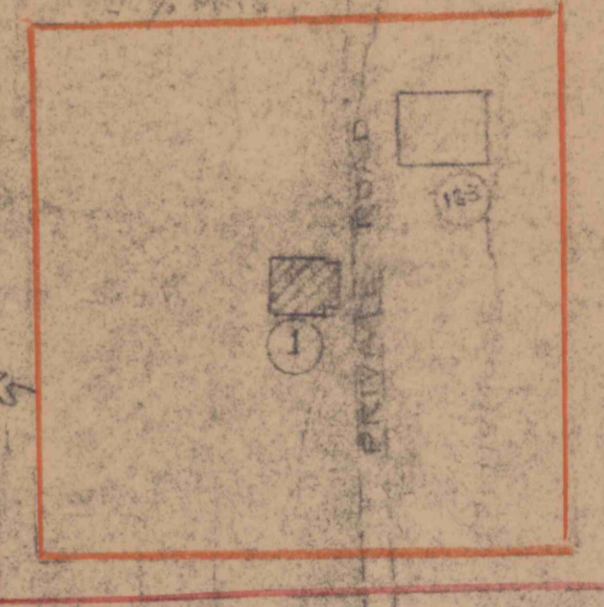

Railroad Spike & Macadam Road Note of Pg. 4 Vol. 219

NORTH SCALE 1 IN. = 100 FT.

LEGEND
IMPOUNDED WATER AREA OUTLINED IN GREEN
SURFACE SUPPORT AREA

FED. NO. 3600839

BARR COAL CORP'N
PERMIT #3721 FROM #6
MOSS CREEK #3
BARR COAL CORP'N
SITUATE IN
BARR TWP CAMBRIA CO
GREEN TWP INDIANA CO
MAY 1, 1923

LEGEND:
SURFACE SUPPORT AREA IN RED
PROJECTED MINING AREA
FROM MAY 1, 1971 TO NOV 1, 1971 IN BROWN

North C. Kirkland
Springer, Pa.

D.P.H. #1593
SURFACE 1512.00
18' EL. 1497.00

D.P.H. #1593
SURFACE 1512.00
18' EL. 1497.00