



SONMAN No. 2 "B" SEAM MINE

WASHINGTON TOWNSHIP


GAMBRIA COUNTY PA.


SCALE 1"=100'


REVISED 6-30-1967

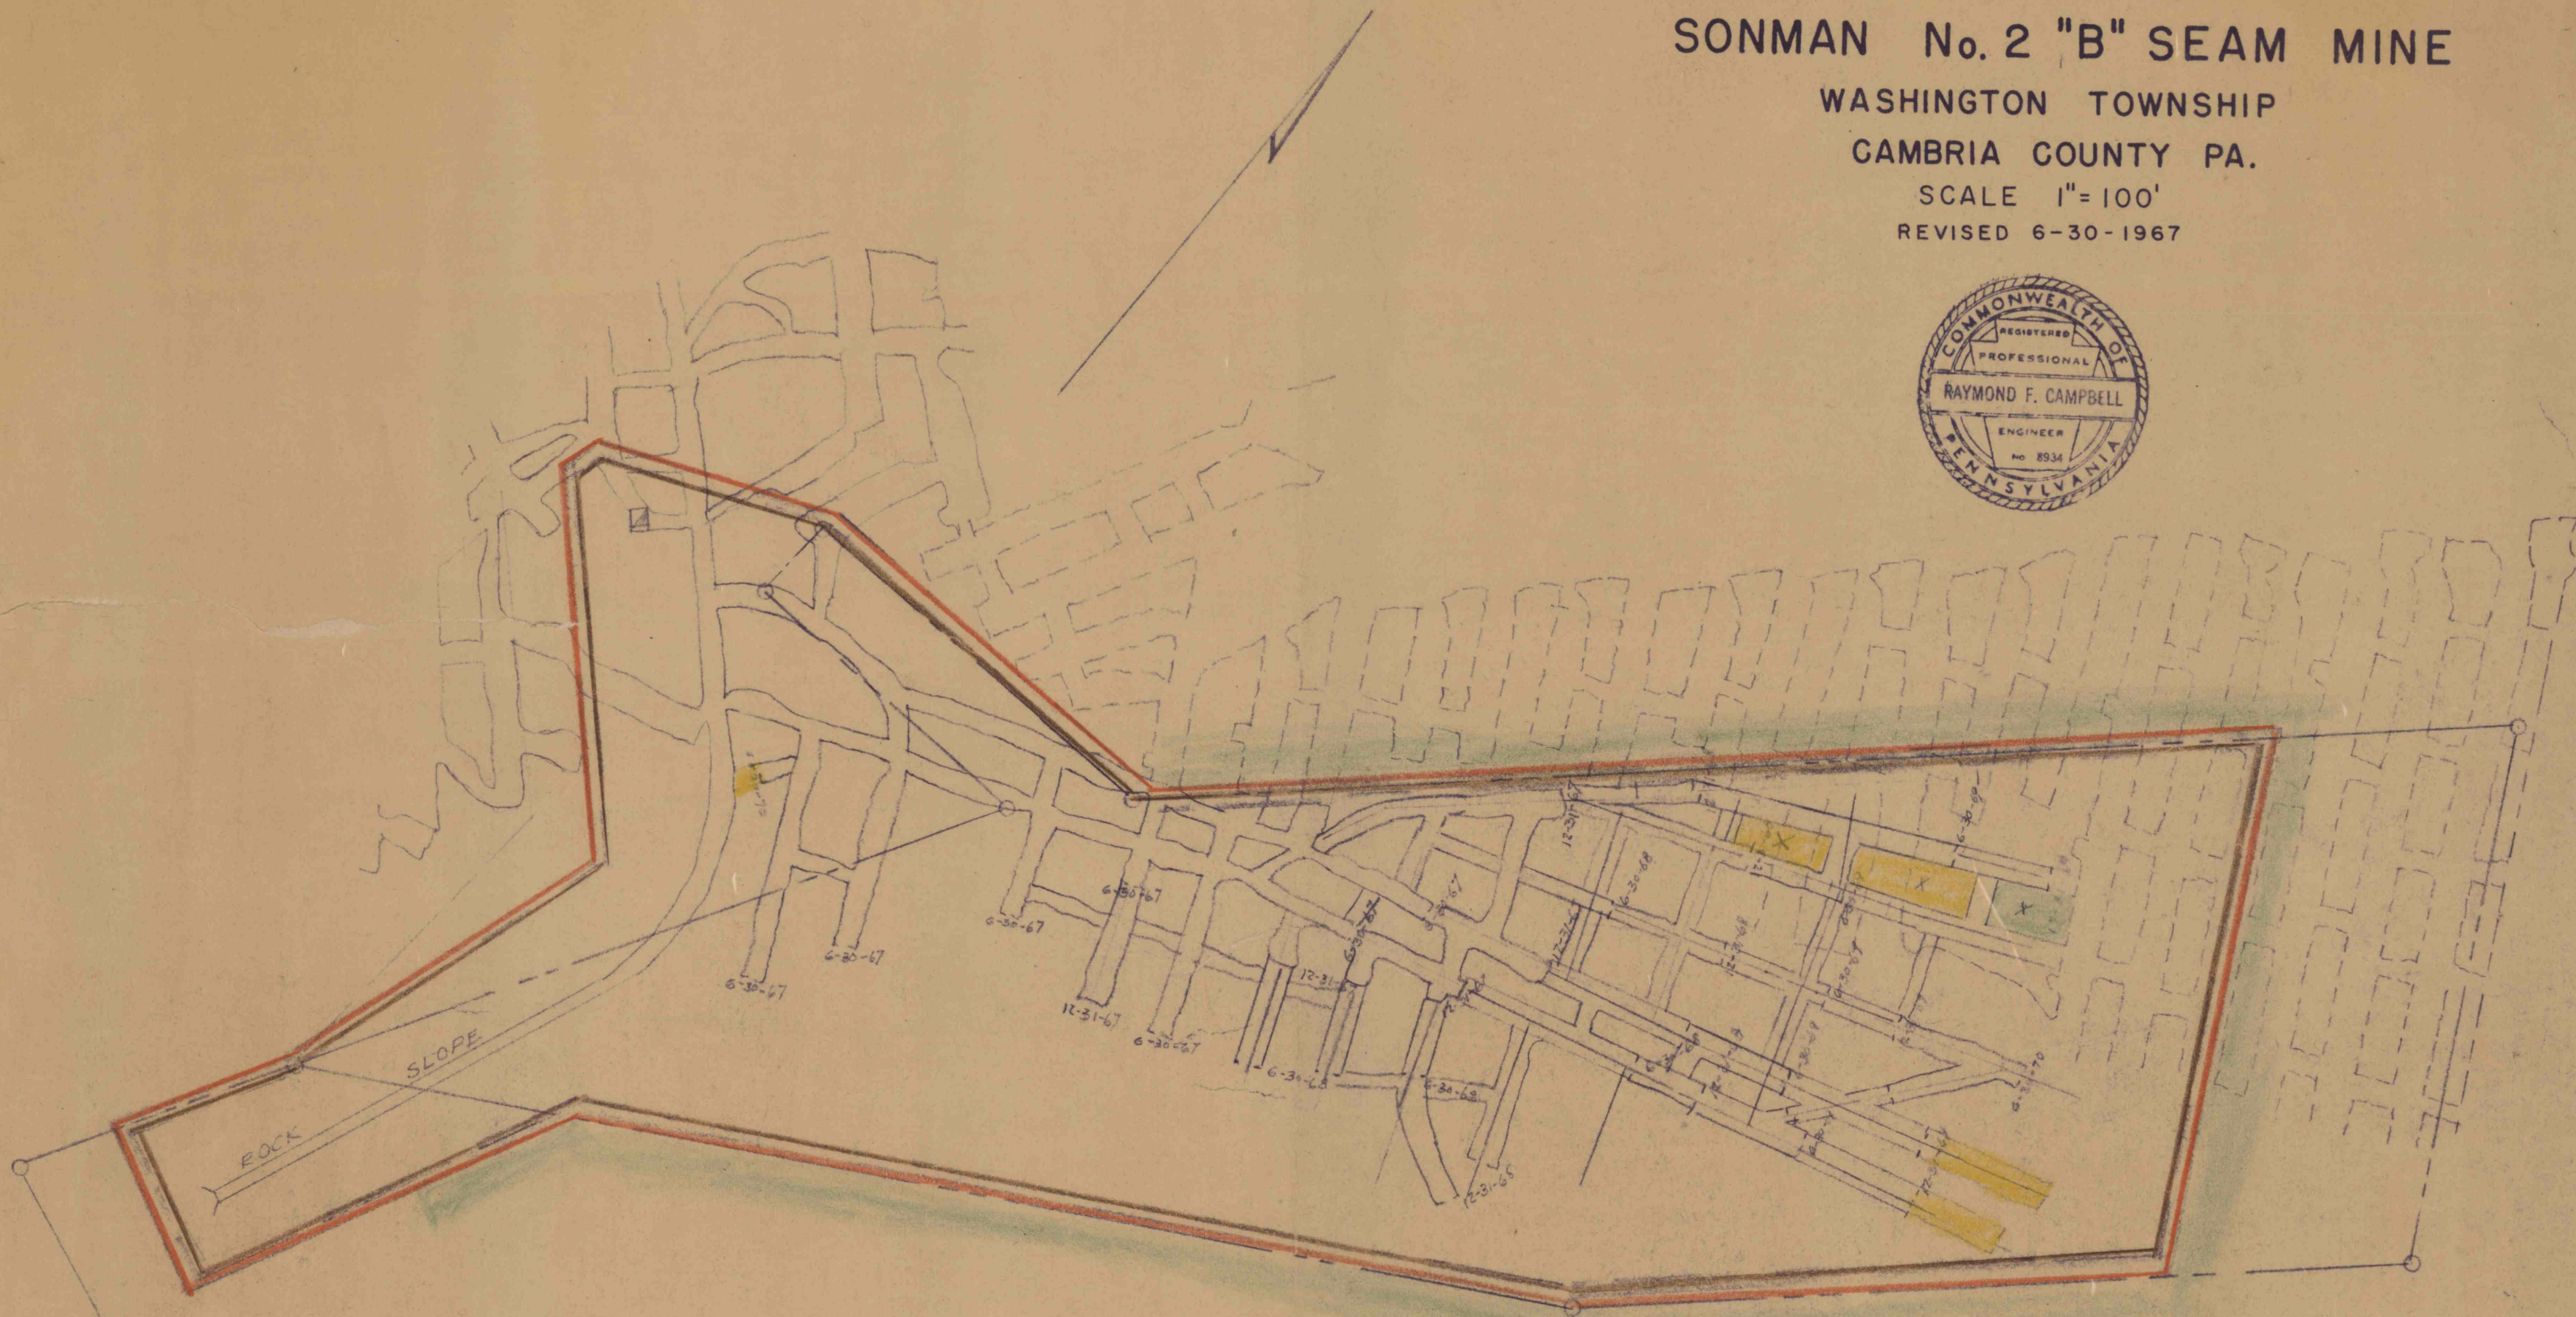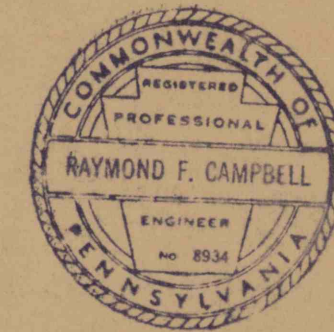


LEGEND

BOUNDARIES OF SURFACE 

MINING OPERATIONS COMPLETED 

PROPOSED OPERATIONS UNDER PERMIT 

PROPOSED WORK NEXT SIX MONTHS  12-31-70

PERMIT No. 286-1