
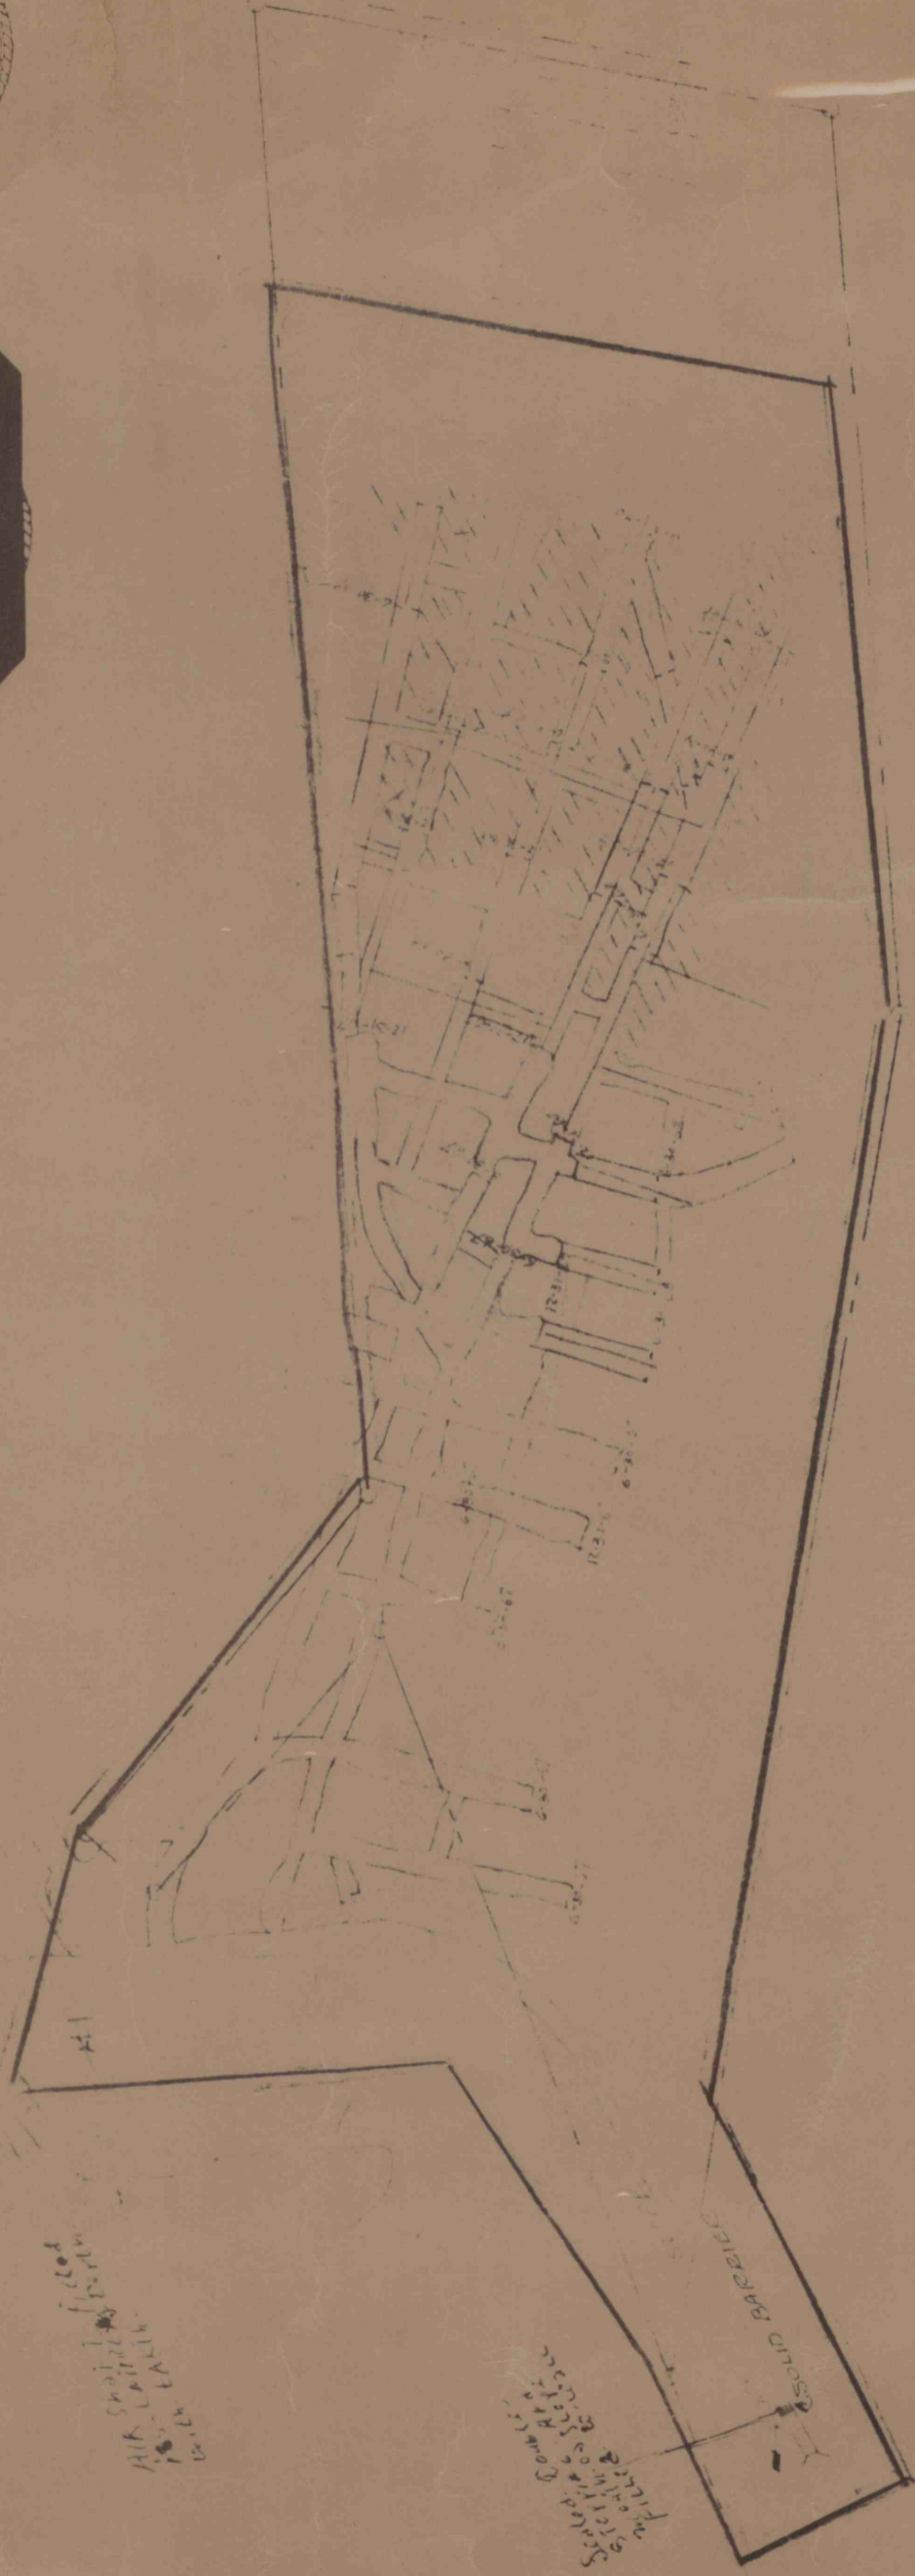


SONMAN No. 2 "B" SEAM MINE

WASHINGTON TOWNSHIP
CAMBRIA COUNTY PA.

SCALE 1" = 100'
REVISED 6-30-1967

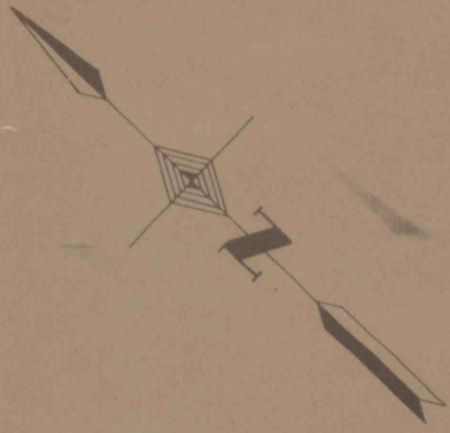

LEGEND

BOUNDARIES OF SURFACE

MINING OPERATIONS COMPLETED

PROPOSED OPERATIONS UNDER PERMIT

PROPOSED WORK NEXT SIX MONTHS

PERMIT No. 286-1

FINAL 3-5-71



PDVMS

03055

169

18X

319376

Now 1" = 125'

216