


T

L

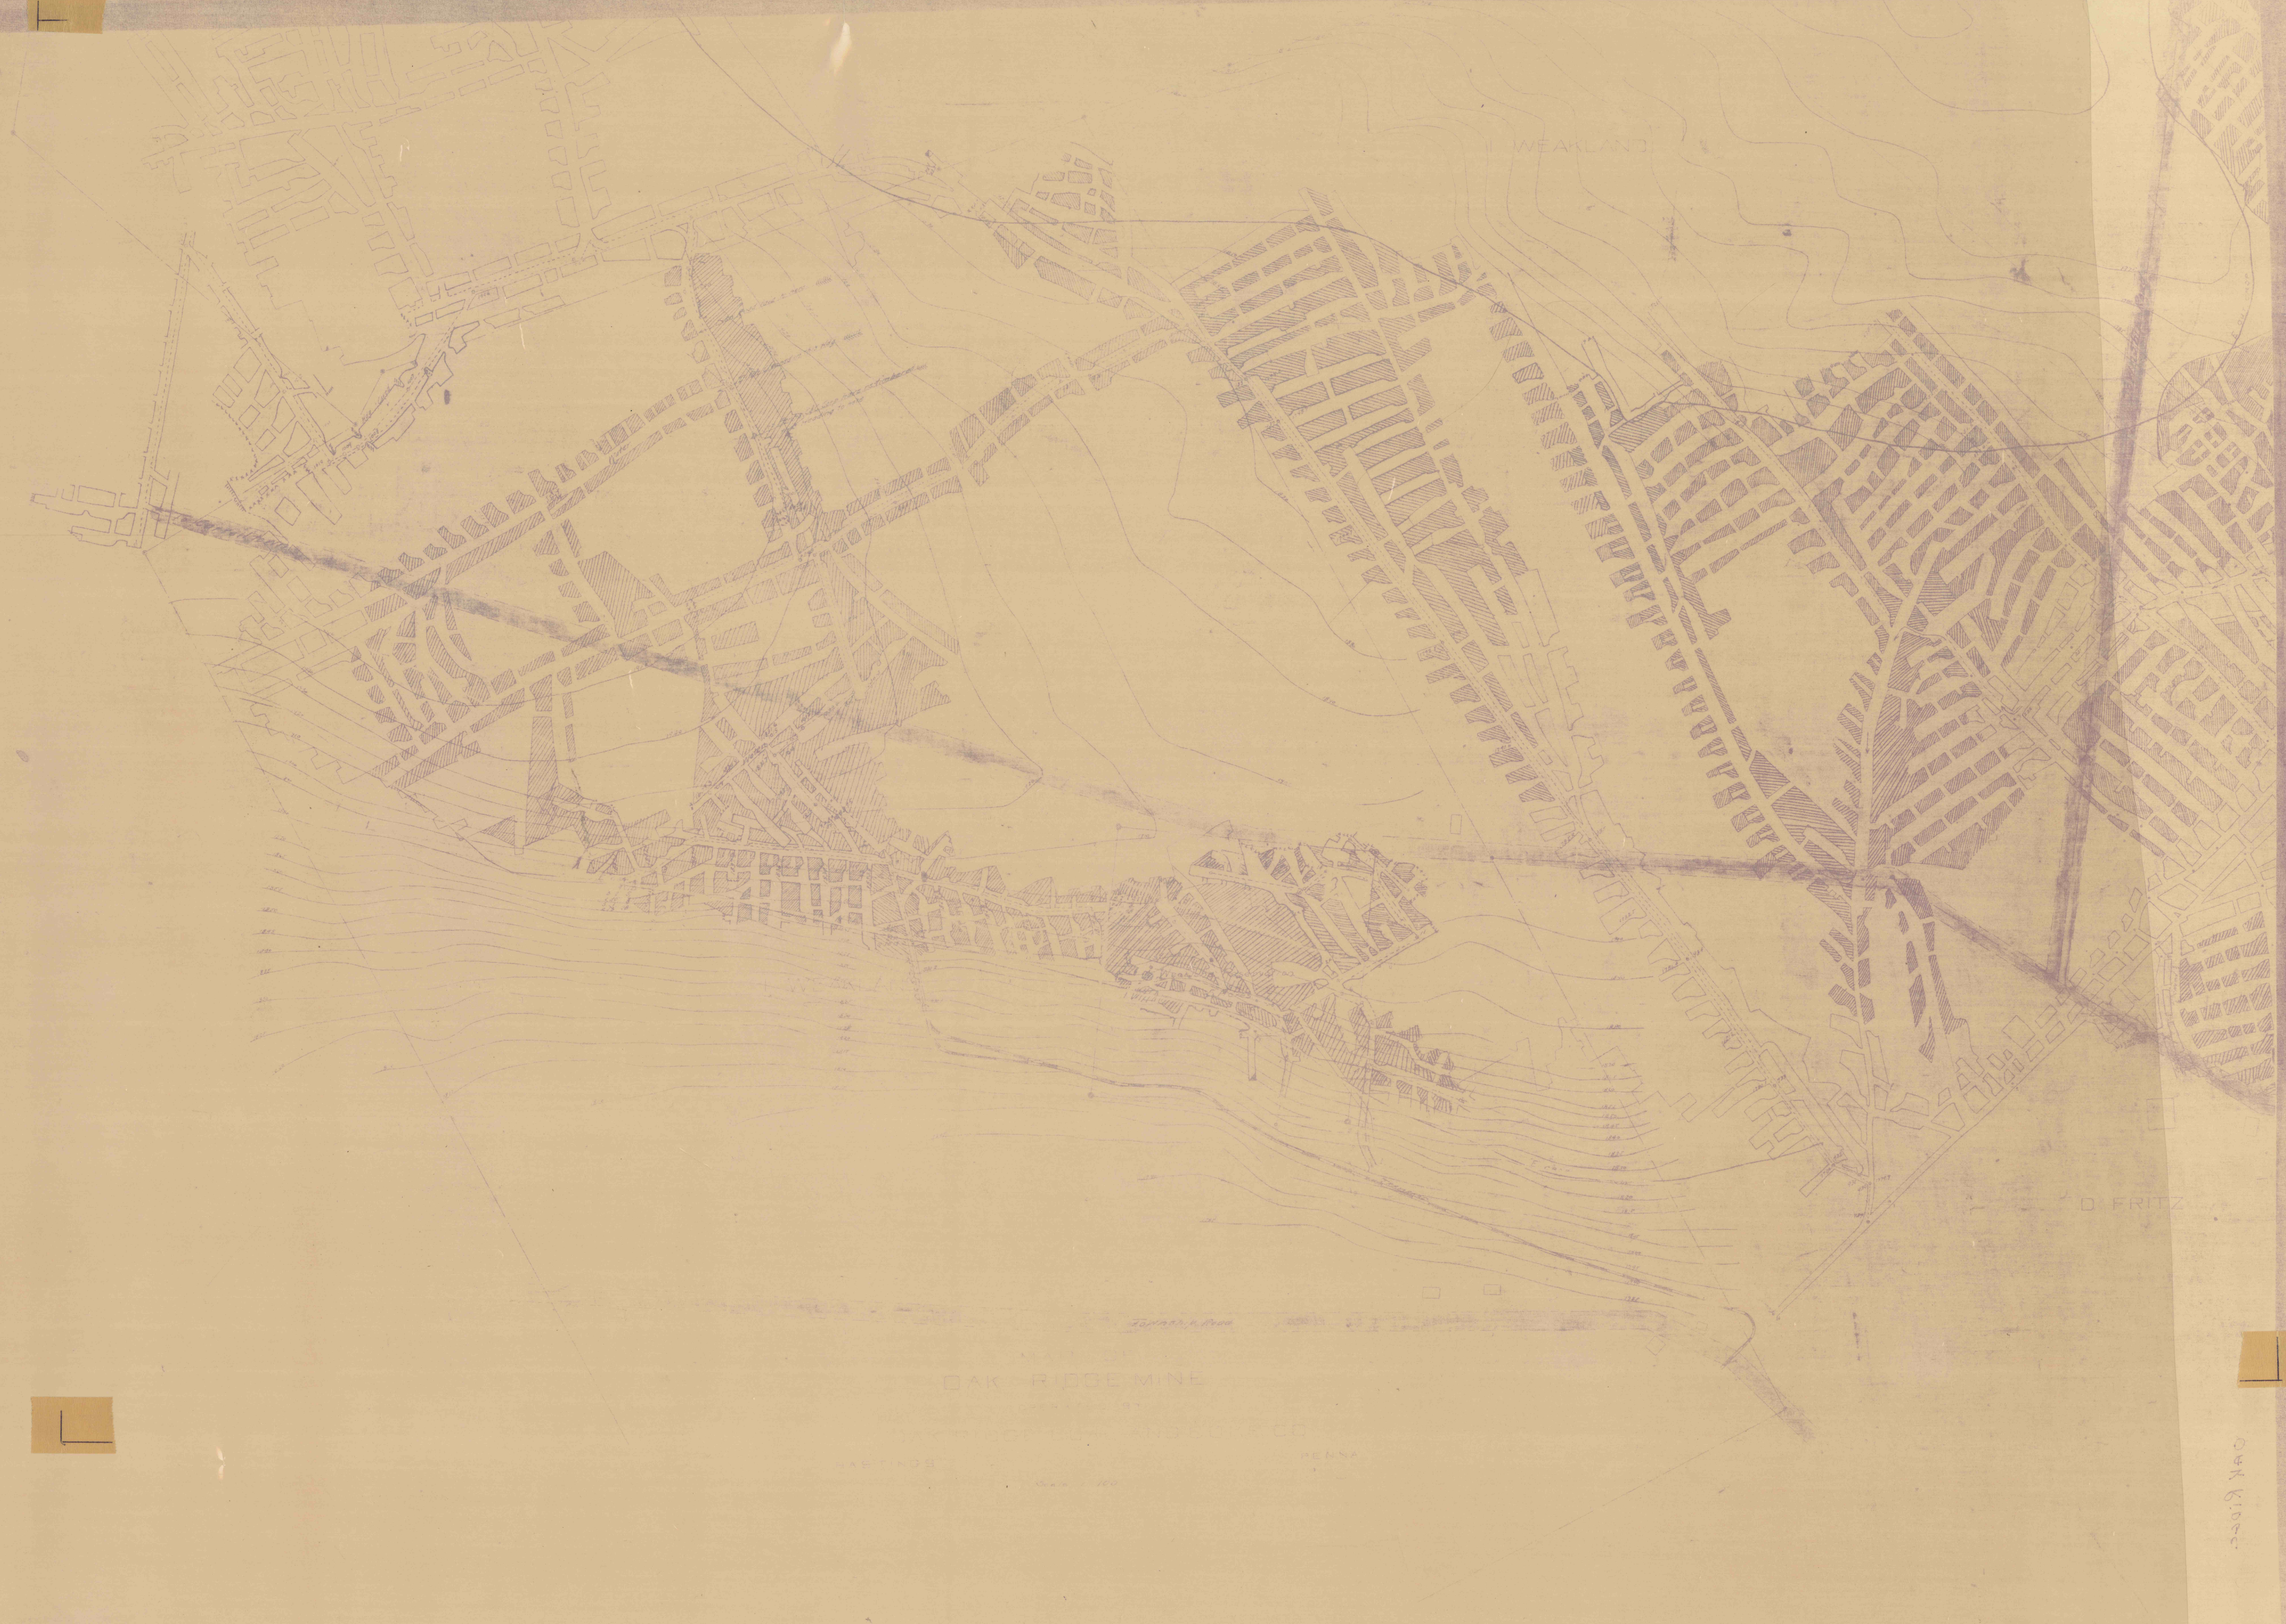

WEAKLAND

OAK RIDGE MINE

W. H. H. AND CO. CO.

MARTINSBURG

PENNA.

D. FRITZ

OAK RIDGE