


3

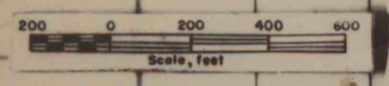

INLAND STEEL COAL COMPANY
LANCASHIRE NO 25 MINE
BARR TWP. CAMBRIA COUNTY, PA.
SCALE: 1"=200' SURVEY DATE 6-30-80
 PROTECTED STRUCTURES
 BOUNDARY OF MINE
 MINING COMPLETED AREA
 6 MONTH MINE OUTLINE
 FROM 7-1-80 TO 1-1-81

THOMAS GRIFFITH HEIRS
32000 A.

PETER PARRISH
78.68 A.

THOMAS GRIFFITH HEIRS
115.39 A.

THOMAS GRIFFITH HEIRS
41.46 A.

JOHN RAGLEY
284.13 A.

MARGARET EGER
293.66 A.

MARGARET EGER
293.66 A.

HENRY KRUMENACKER
69.15 A.

H. J. KRUMENACKER
280.33 A.

MARGARET EGER
96.47 A.

SPANGLER RESERVOIR

