


RECEIVED



JAN 30 1929 AM

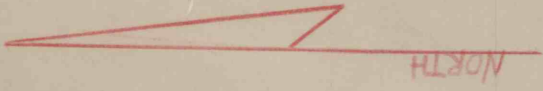

Mined since map posted-
Oct. - 3486
Nov. - 3191
Dec. - 3100 Approximate
9777 Gro. Tons.

Bad Roof
No coal.

All coal between red
line and crop taken
out.

Referred to as
red line.

ADAM HAAS

GEORGE SEMELSBERGER

88A67P
4A8P-Res
84A.59P

Photograph from map of Miller
Run Mine. July 3, 1912.
by Chas. E. Schlicher, Engr.
Scale 1" - 100'
Approx. scale of photograph, 1" - 200'

(A)	Worked out to 10/1/1928	- 6.25 Acres	26.25 Acs.
	" " , Oct., Nov., Dec.	- 2.00 "	8.25 "
(B)	Remaining	-	18.00 "
			3.90 "
	Total Remaining	-	21.90 "

3.90 Acs.
(B)

285