


LINCOLN MINE
LINCOLN COAL CO
OPERATORS
 NANTY-GLENN
 Scale - 1" = 200'
 Old workings
 Property

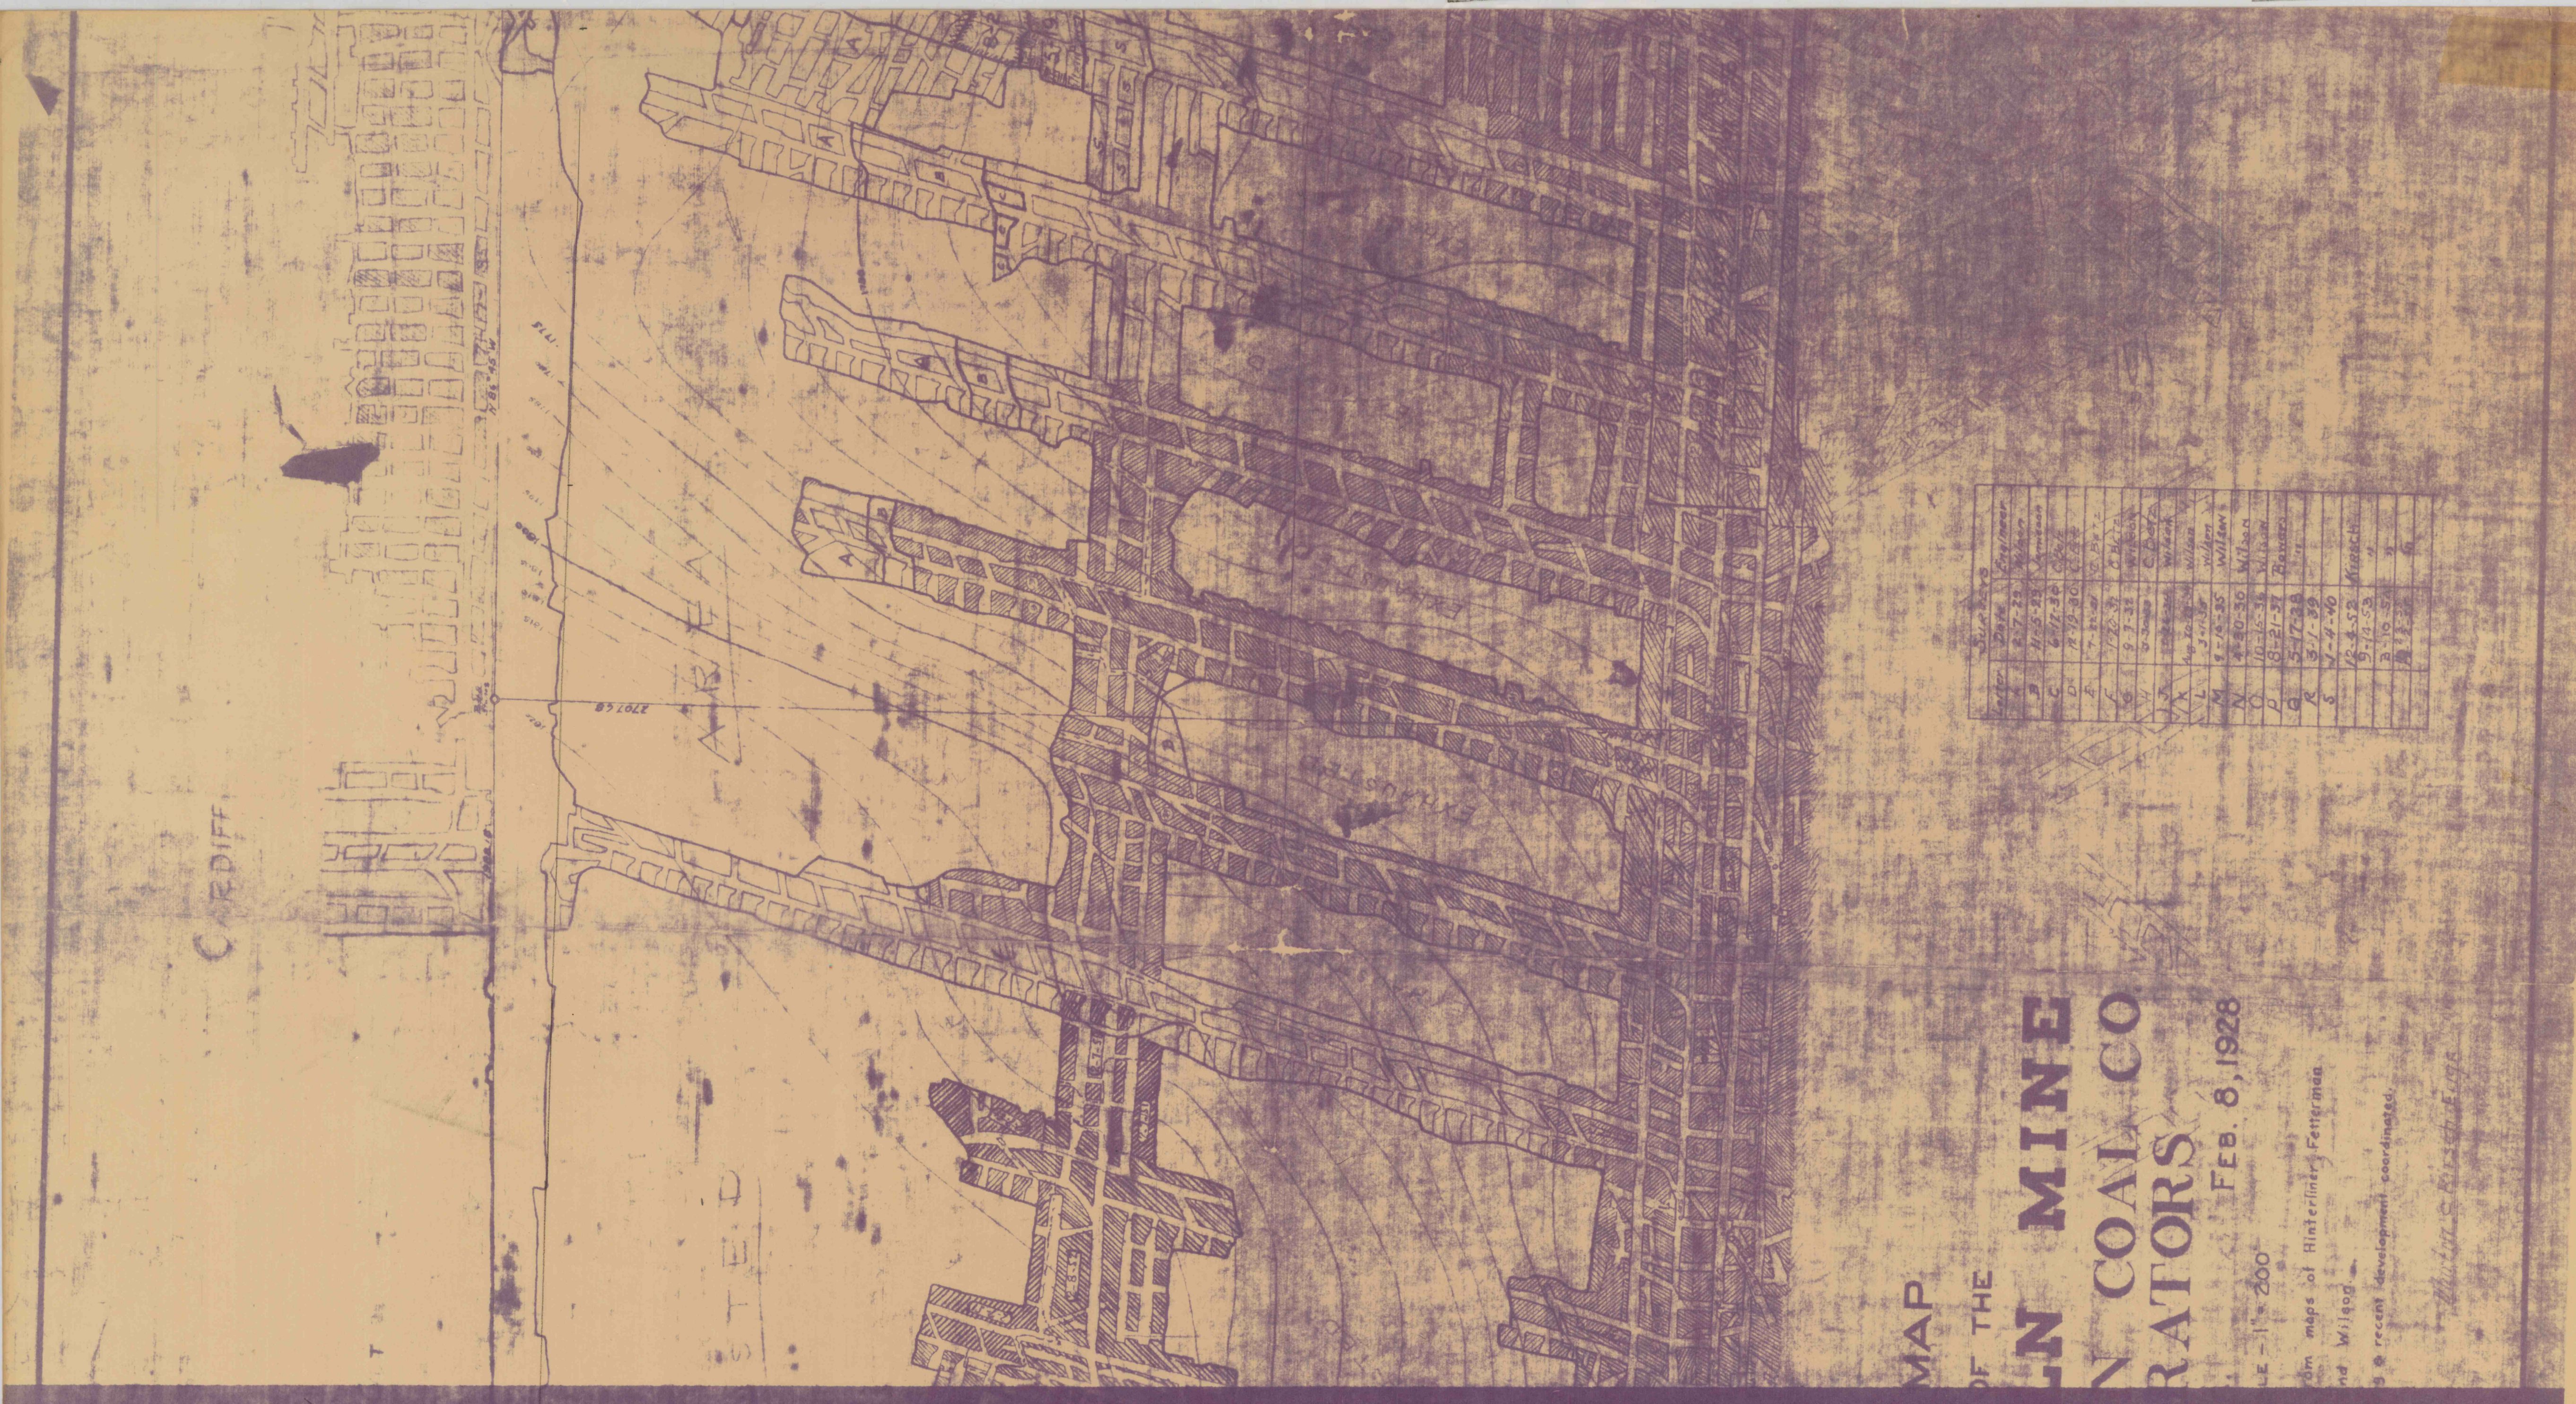

MAP OF THE
LINCOLN MINE
LINCOLN COAL CO
OPERATORS
 FEB. 8, 1928
 Scale - 1" = 200'
 Old maps of Rinterim's Ferry area
 per Wilson
 Recent development workings
 W. S. Patch-Fuge


209