


MINED OUT No 9 MINE

WILLIAM BARTON NOW
PA. GAME COMMISSION


SURFACE - STATE GAME COMMISSION
COAL HIRAM SWANK'S SONS

1"=400'

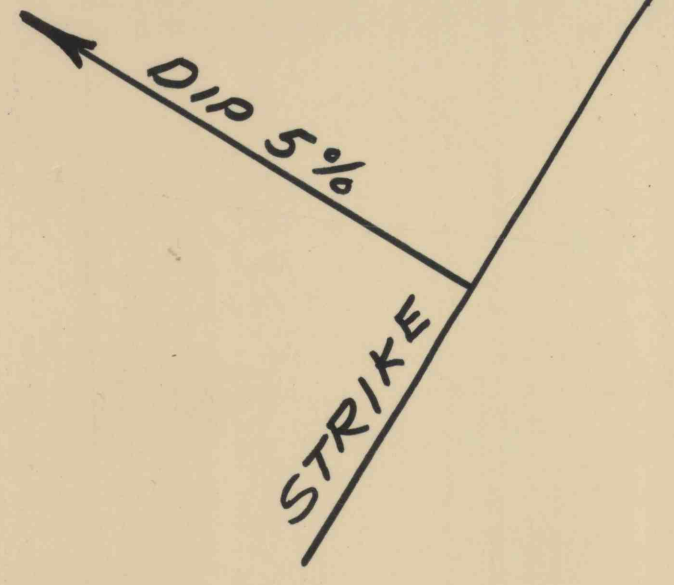


1/4 MILE
HEN RUN

LEWIS WOLF
No 10 MINE

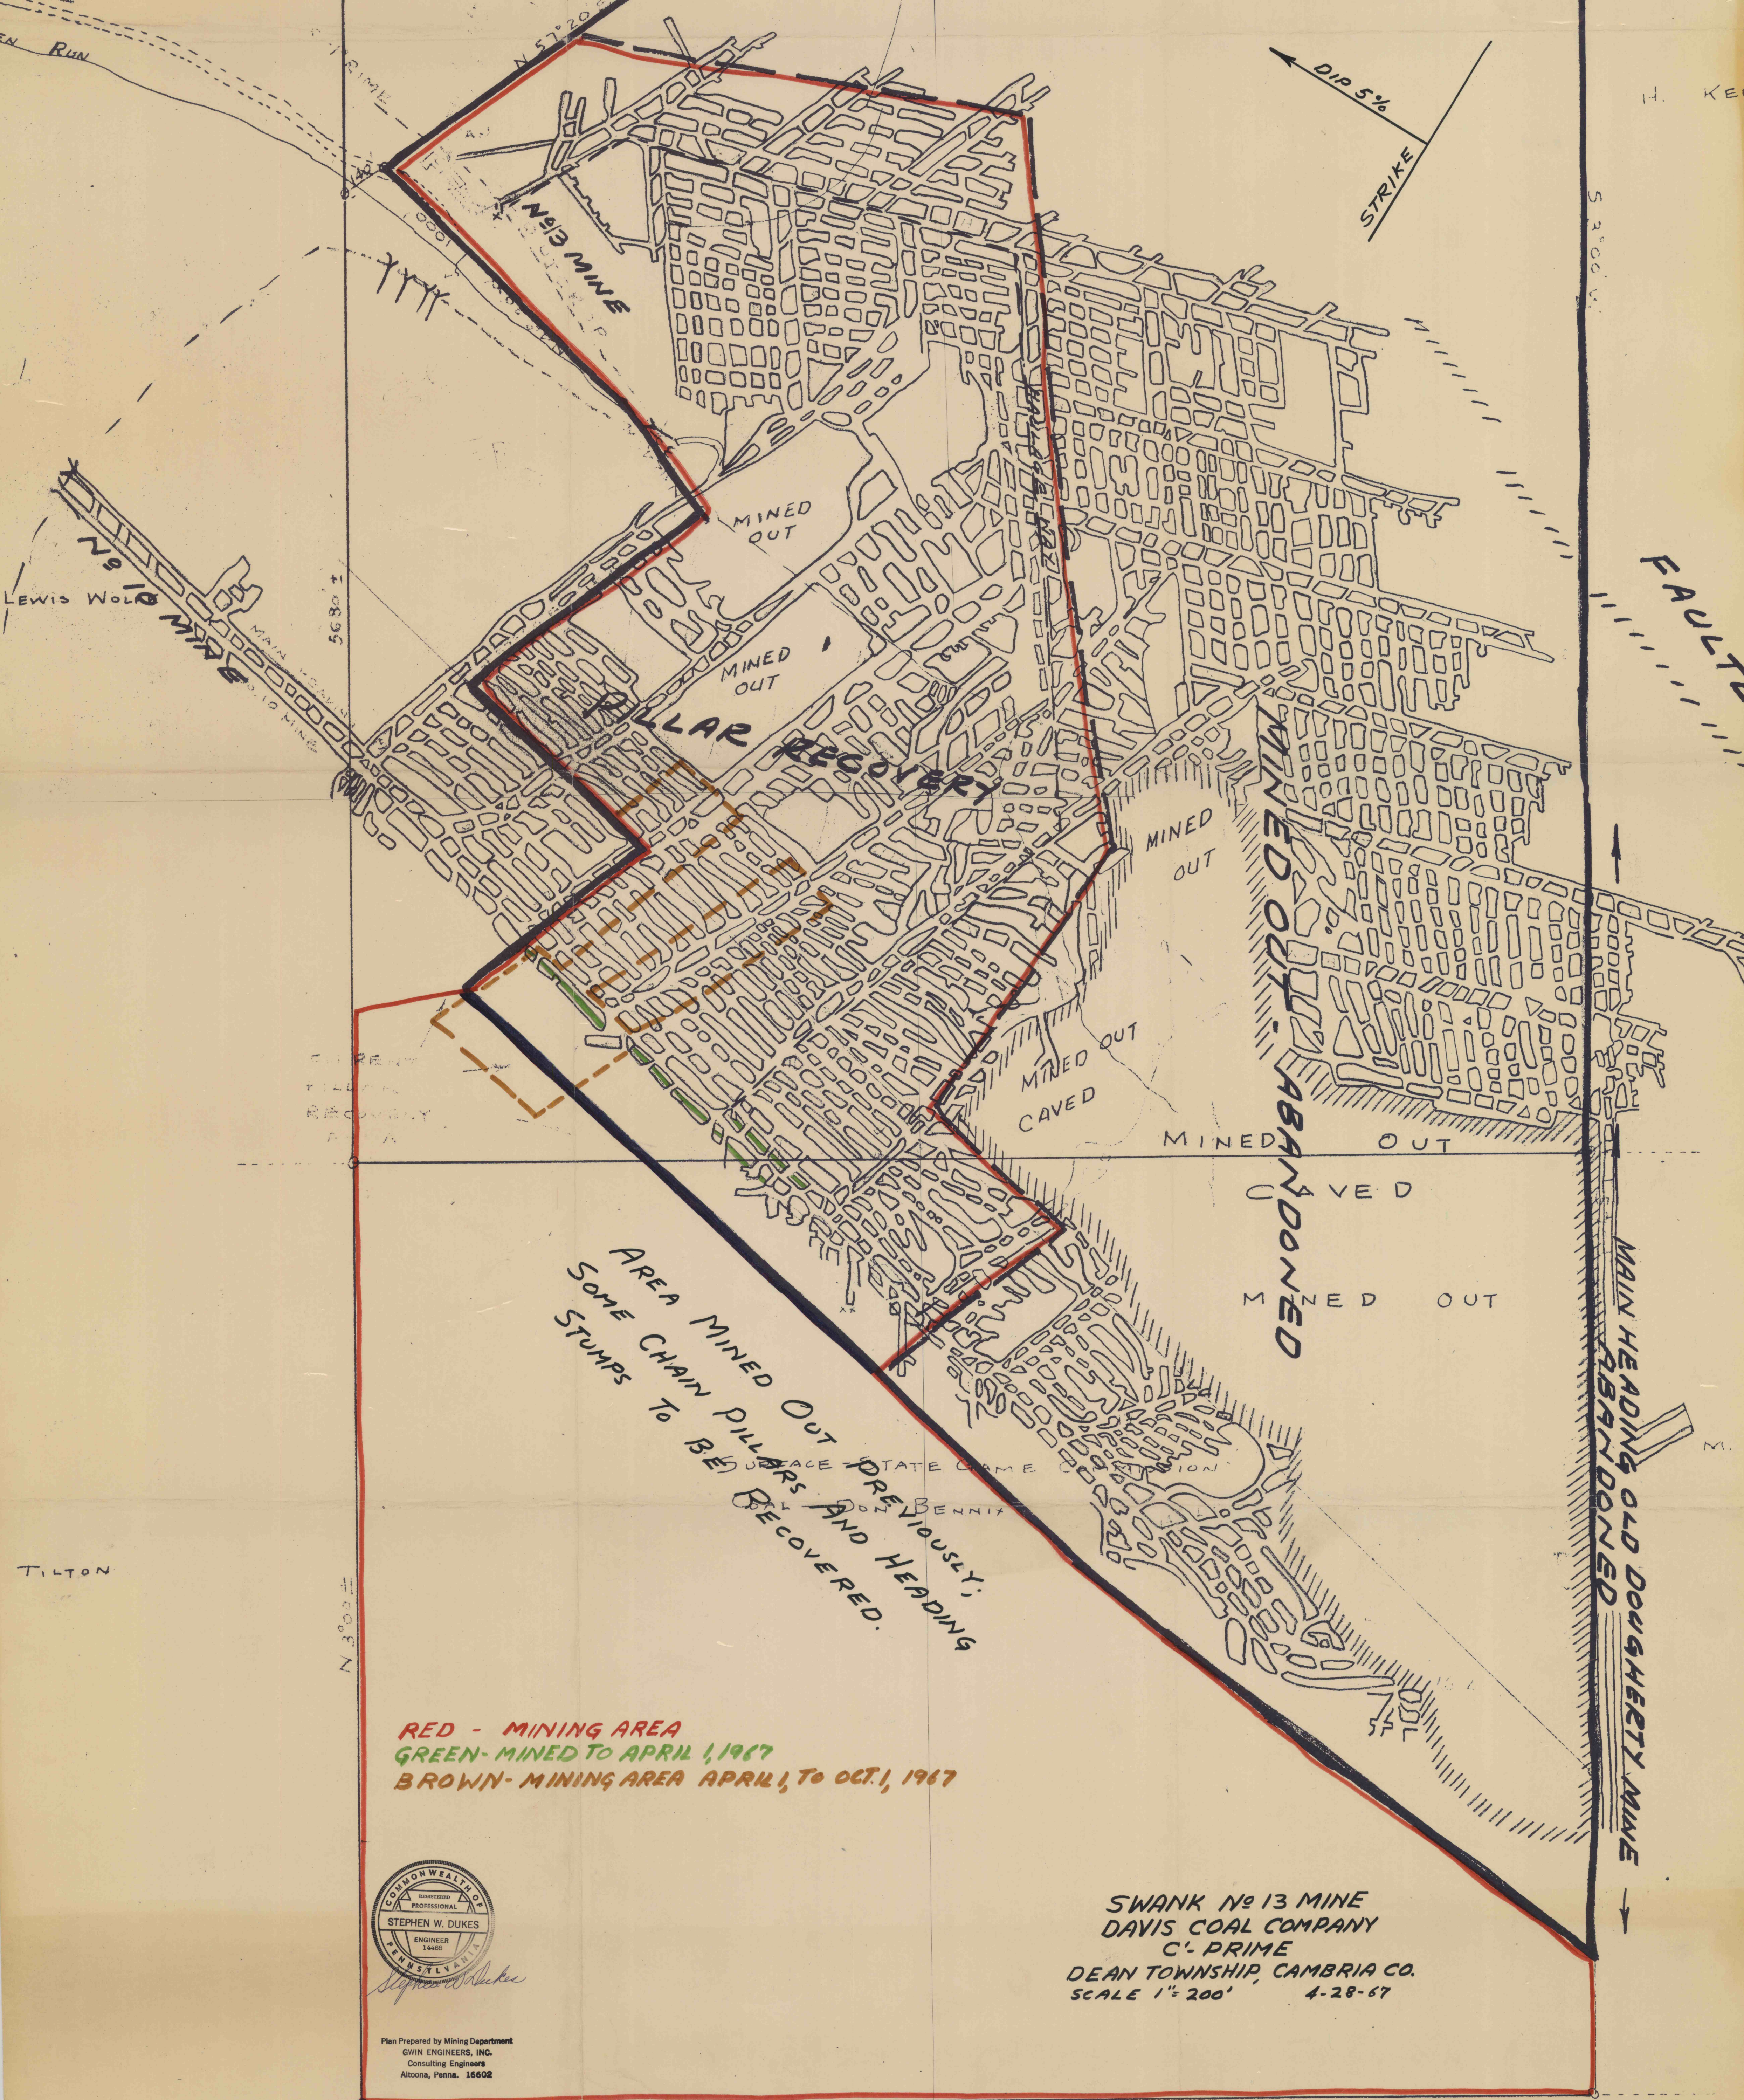

AREA MINED OUT PREVIOUSLY,
SOME CHAIN PILLARS AND HEADING
STUMPS TO BE RECOVERED.

RED - MINING AREA
GREEN - MINED TO APRIL 1, 1967
BROWN - MINING AREA APRIL 1, TO OCT. 1, 1967

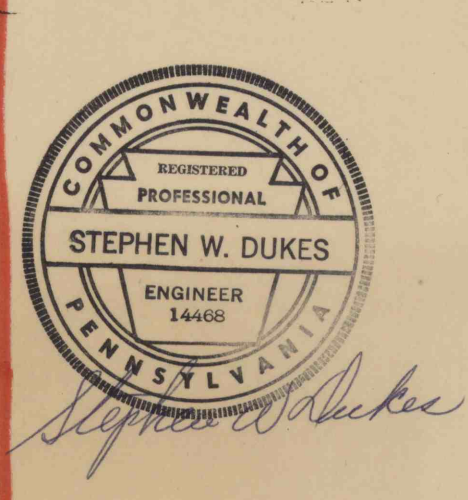

Plan Prepared by Mining Department
GWIN ENGINEERS, INC.
Consulting Engineers
Altoona, Penna. 16602

SWANK No 13 MINE
DAVIS COAL COMPANY
C. PRIME
DEAN TOWNSHIP, CAMBRIA CO.
SCALE 1"=200' 4-28-67