

LEGEND

- BOUNDARIES OF SURFACE ———
- MINING OPERATIONS COMPLETED ———
- PROPOSED OPERATIONS UNDER PERMIT ———
- PROPOSED WORK NEXT SIX MONTHS ———
- PERMIT No. 287-1

# STANDARD No. 2 "B" SEAM MINE


WASHINGTON & CRESSON TOWNSHIPS  
CAMBRIA COUNTY PA.

SCALE 1" = 200'  
REVISED 6-30-1967



L. D. HUGHES - SURFACE  
C. A. HUGHES & CO. & L. D. HUGHES - COAL

PAT. BRADLEY EST.

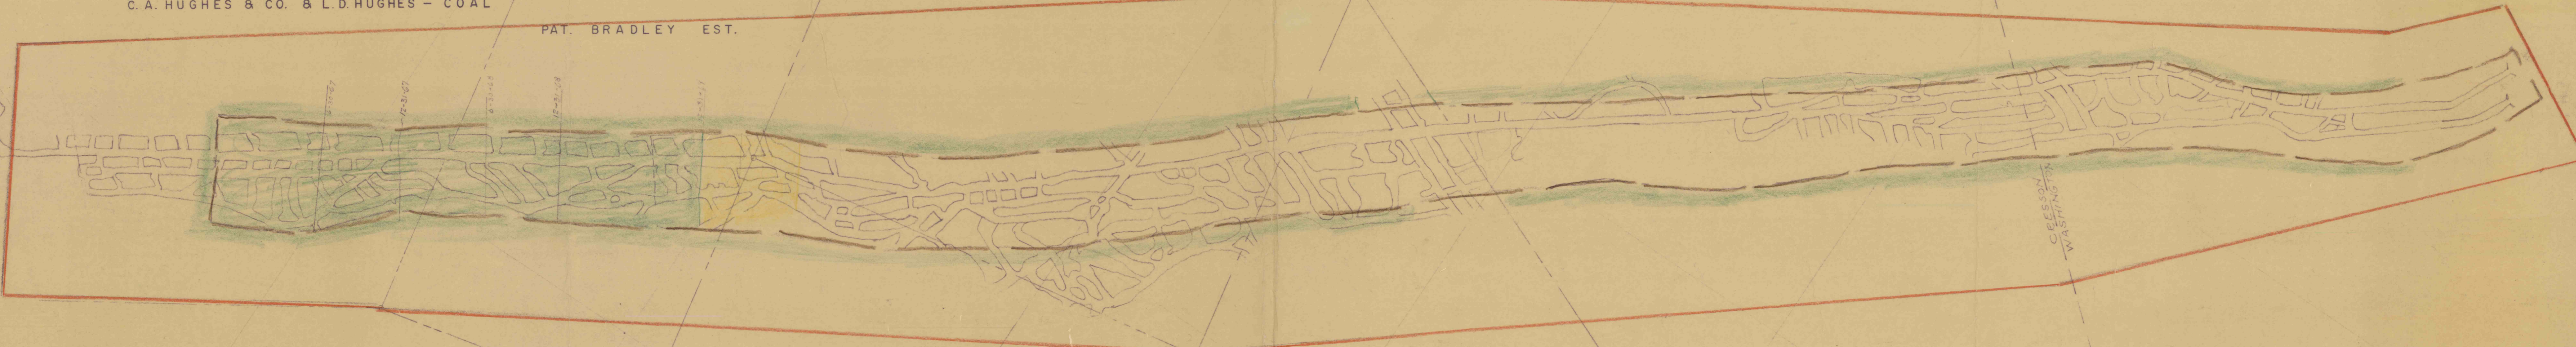

254