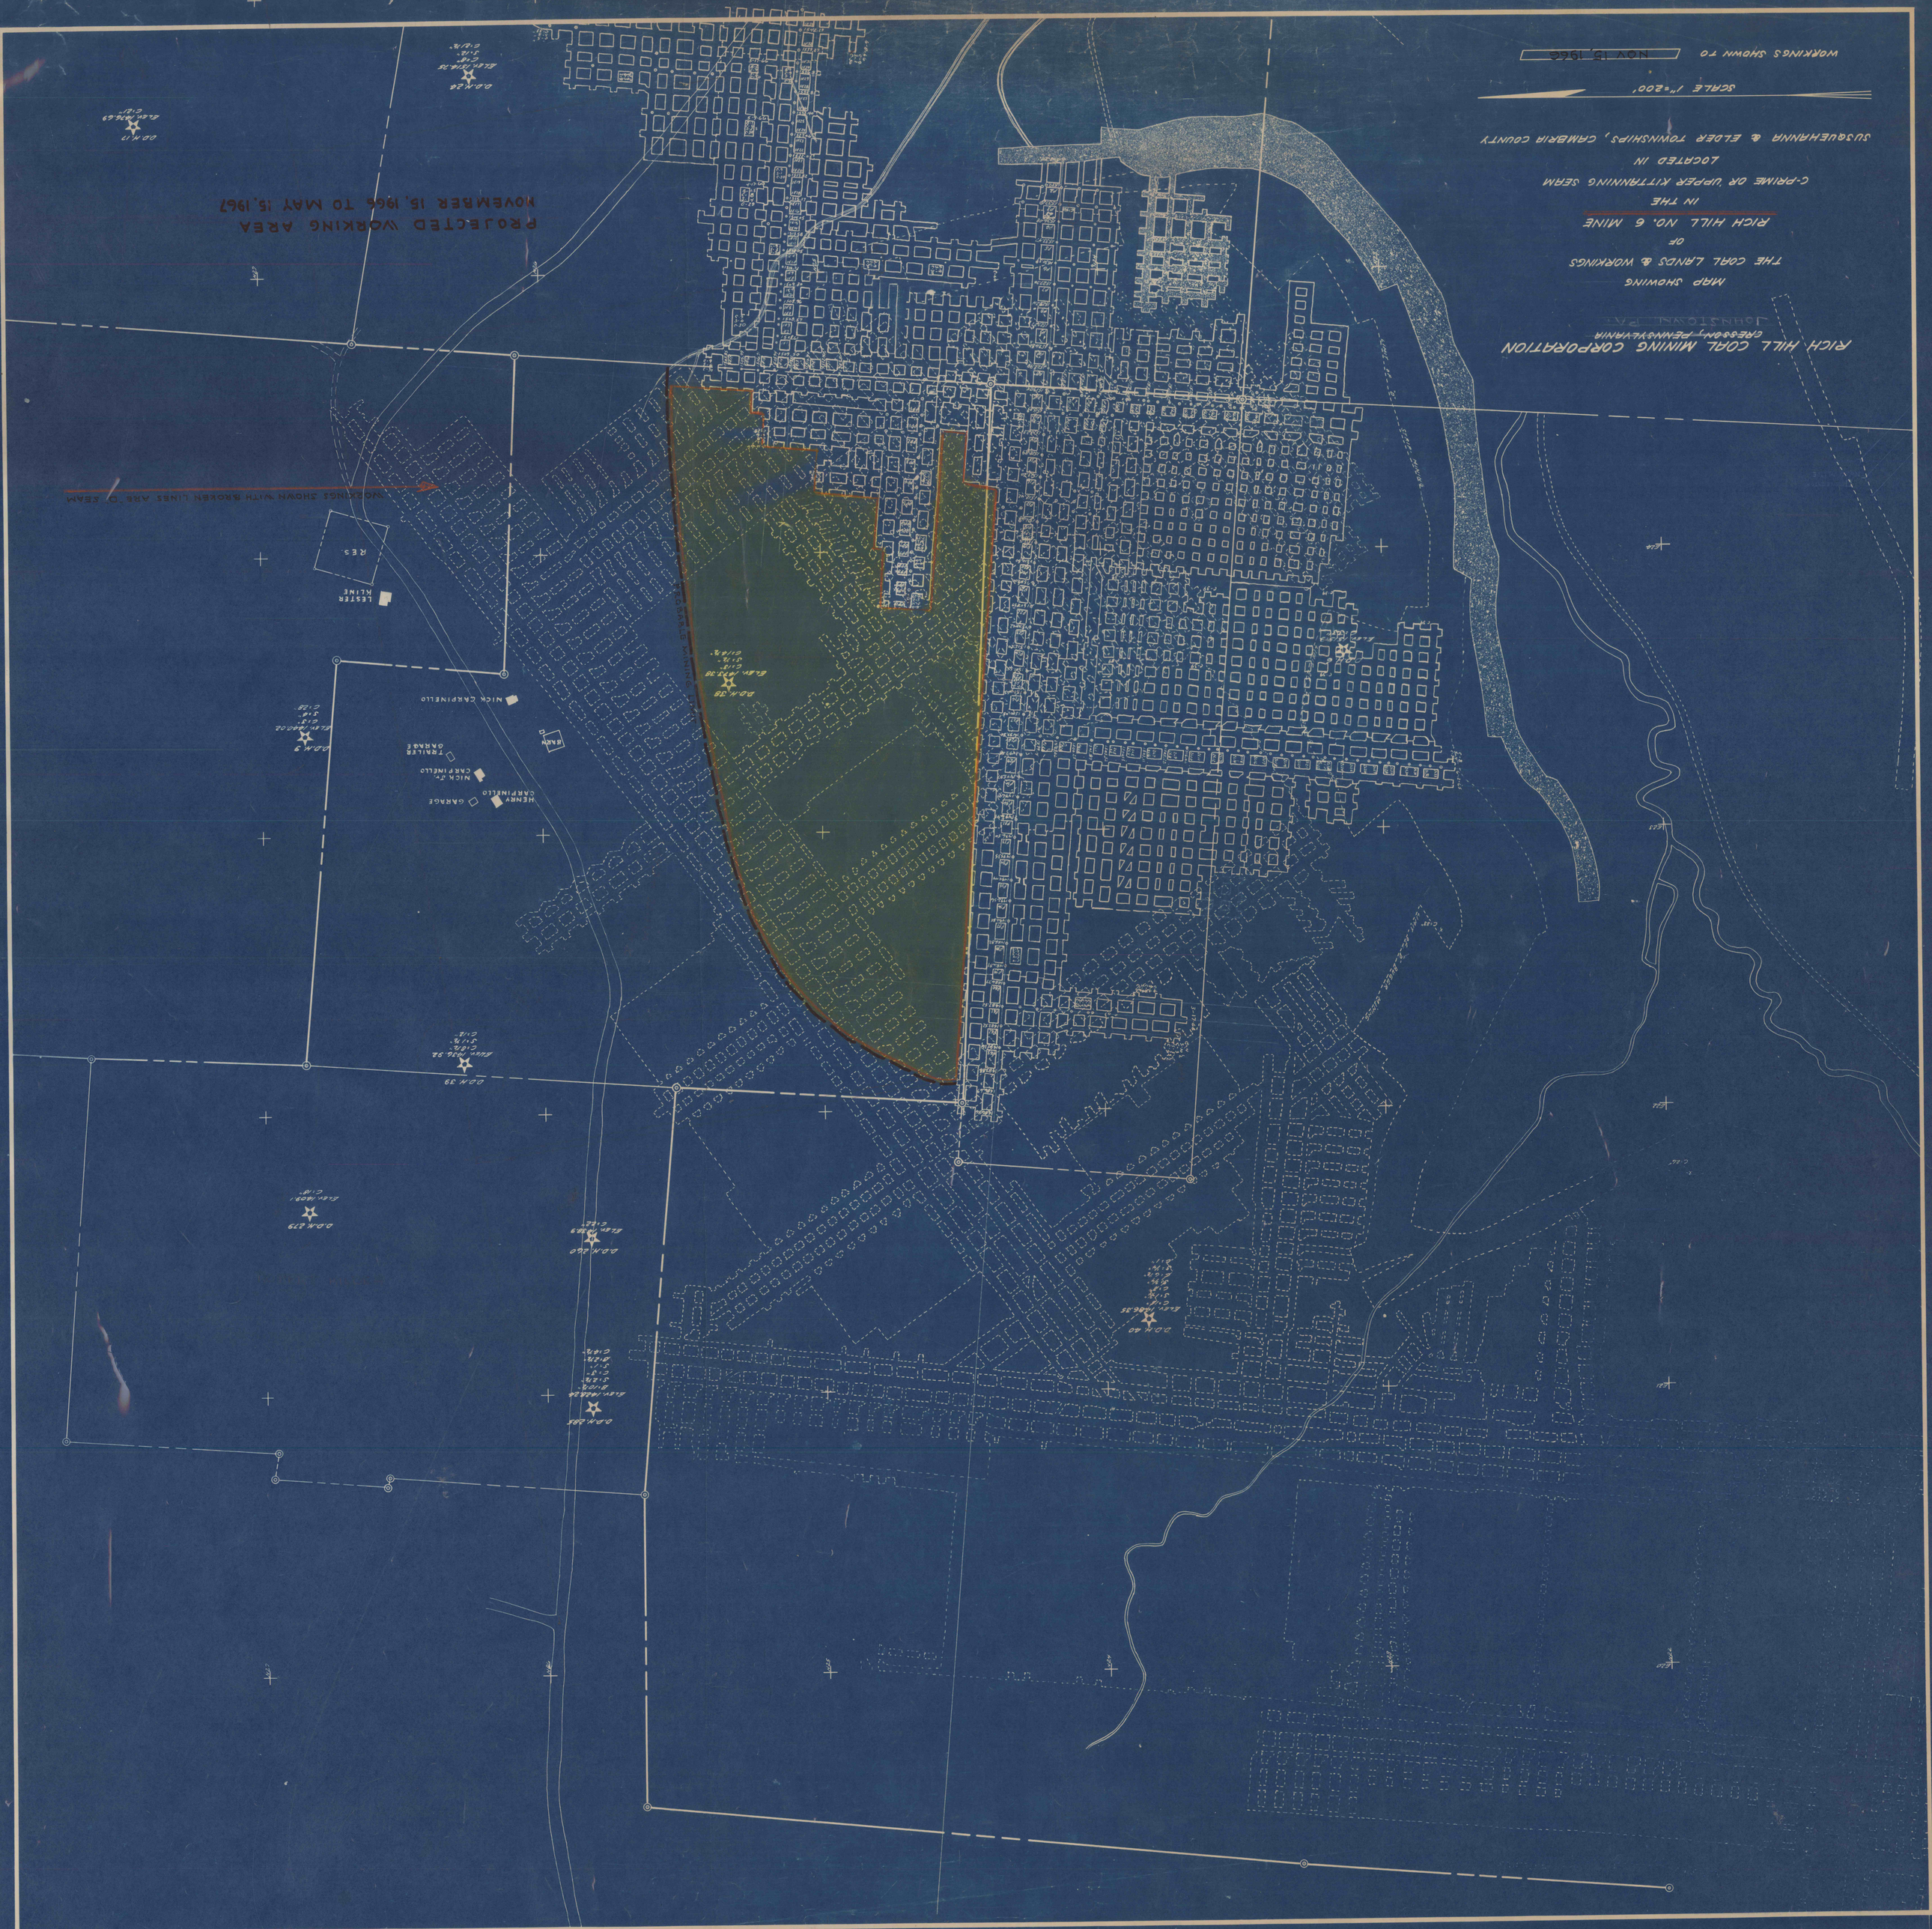
RICH HILL COAL MINING CORPORATION
CRESSON, PENNSYLVANIA
JOHNSTOWN, PA.
MAP SHOWING
THE COAL LANDS & WORKINGS
OF
RICH HILL NO. 6 MINE
IN THE
C-PRIME OR UPPER KITTANNING SEAM
LOCATED IN
SUSQUEHANNA & ELDER TOWNSHIPS, CAMBRIA COUNTY
SCALE 1"=200'
WORKINGS SHOWN TO
PROJECTED WORKING AREA
NOVEMBER 15, 1966 TO MAY 15, 1967
WORKINGS SHOWN WITH BROKEN LINES ARE 'D' SEAM
RES.
LESTER KLINE
NICK CARPINELLO
BARN
TRAILER GARAGE
NICK JR. CARPINELLO
HENRY CARPINELLO
GARAGE
D.D.H. 39
D.D.H. 38
D.D.H. 40
D.D.H. 279
D.D.H. 260
D.D.H. 285