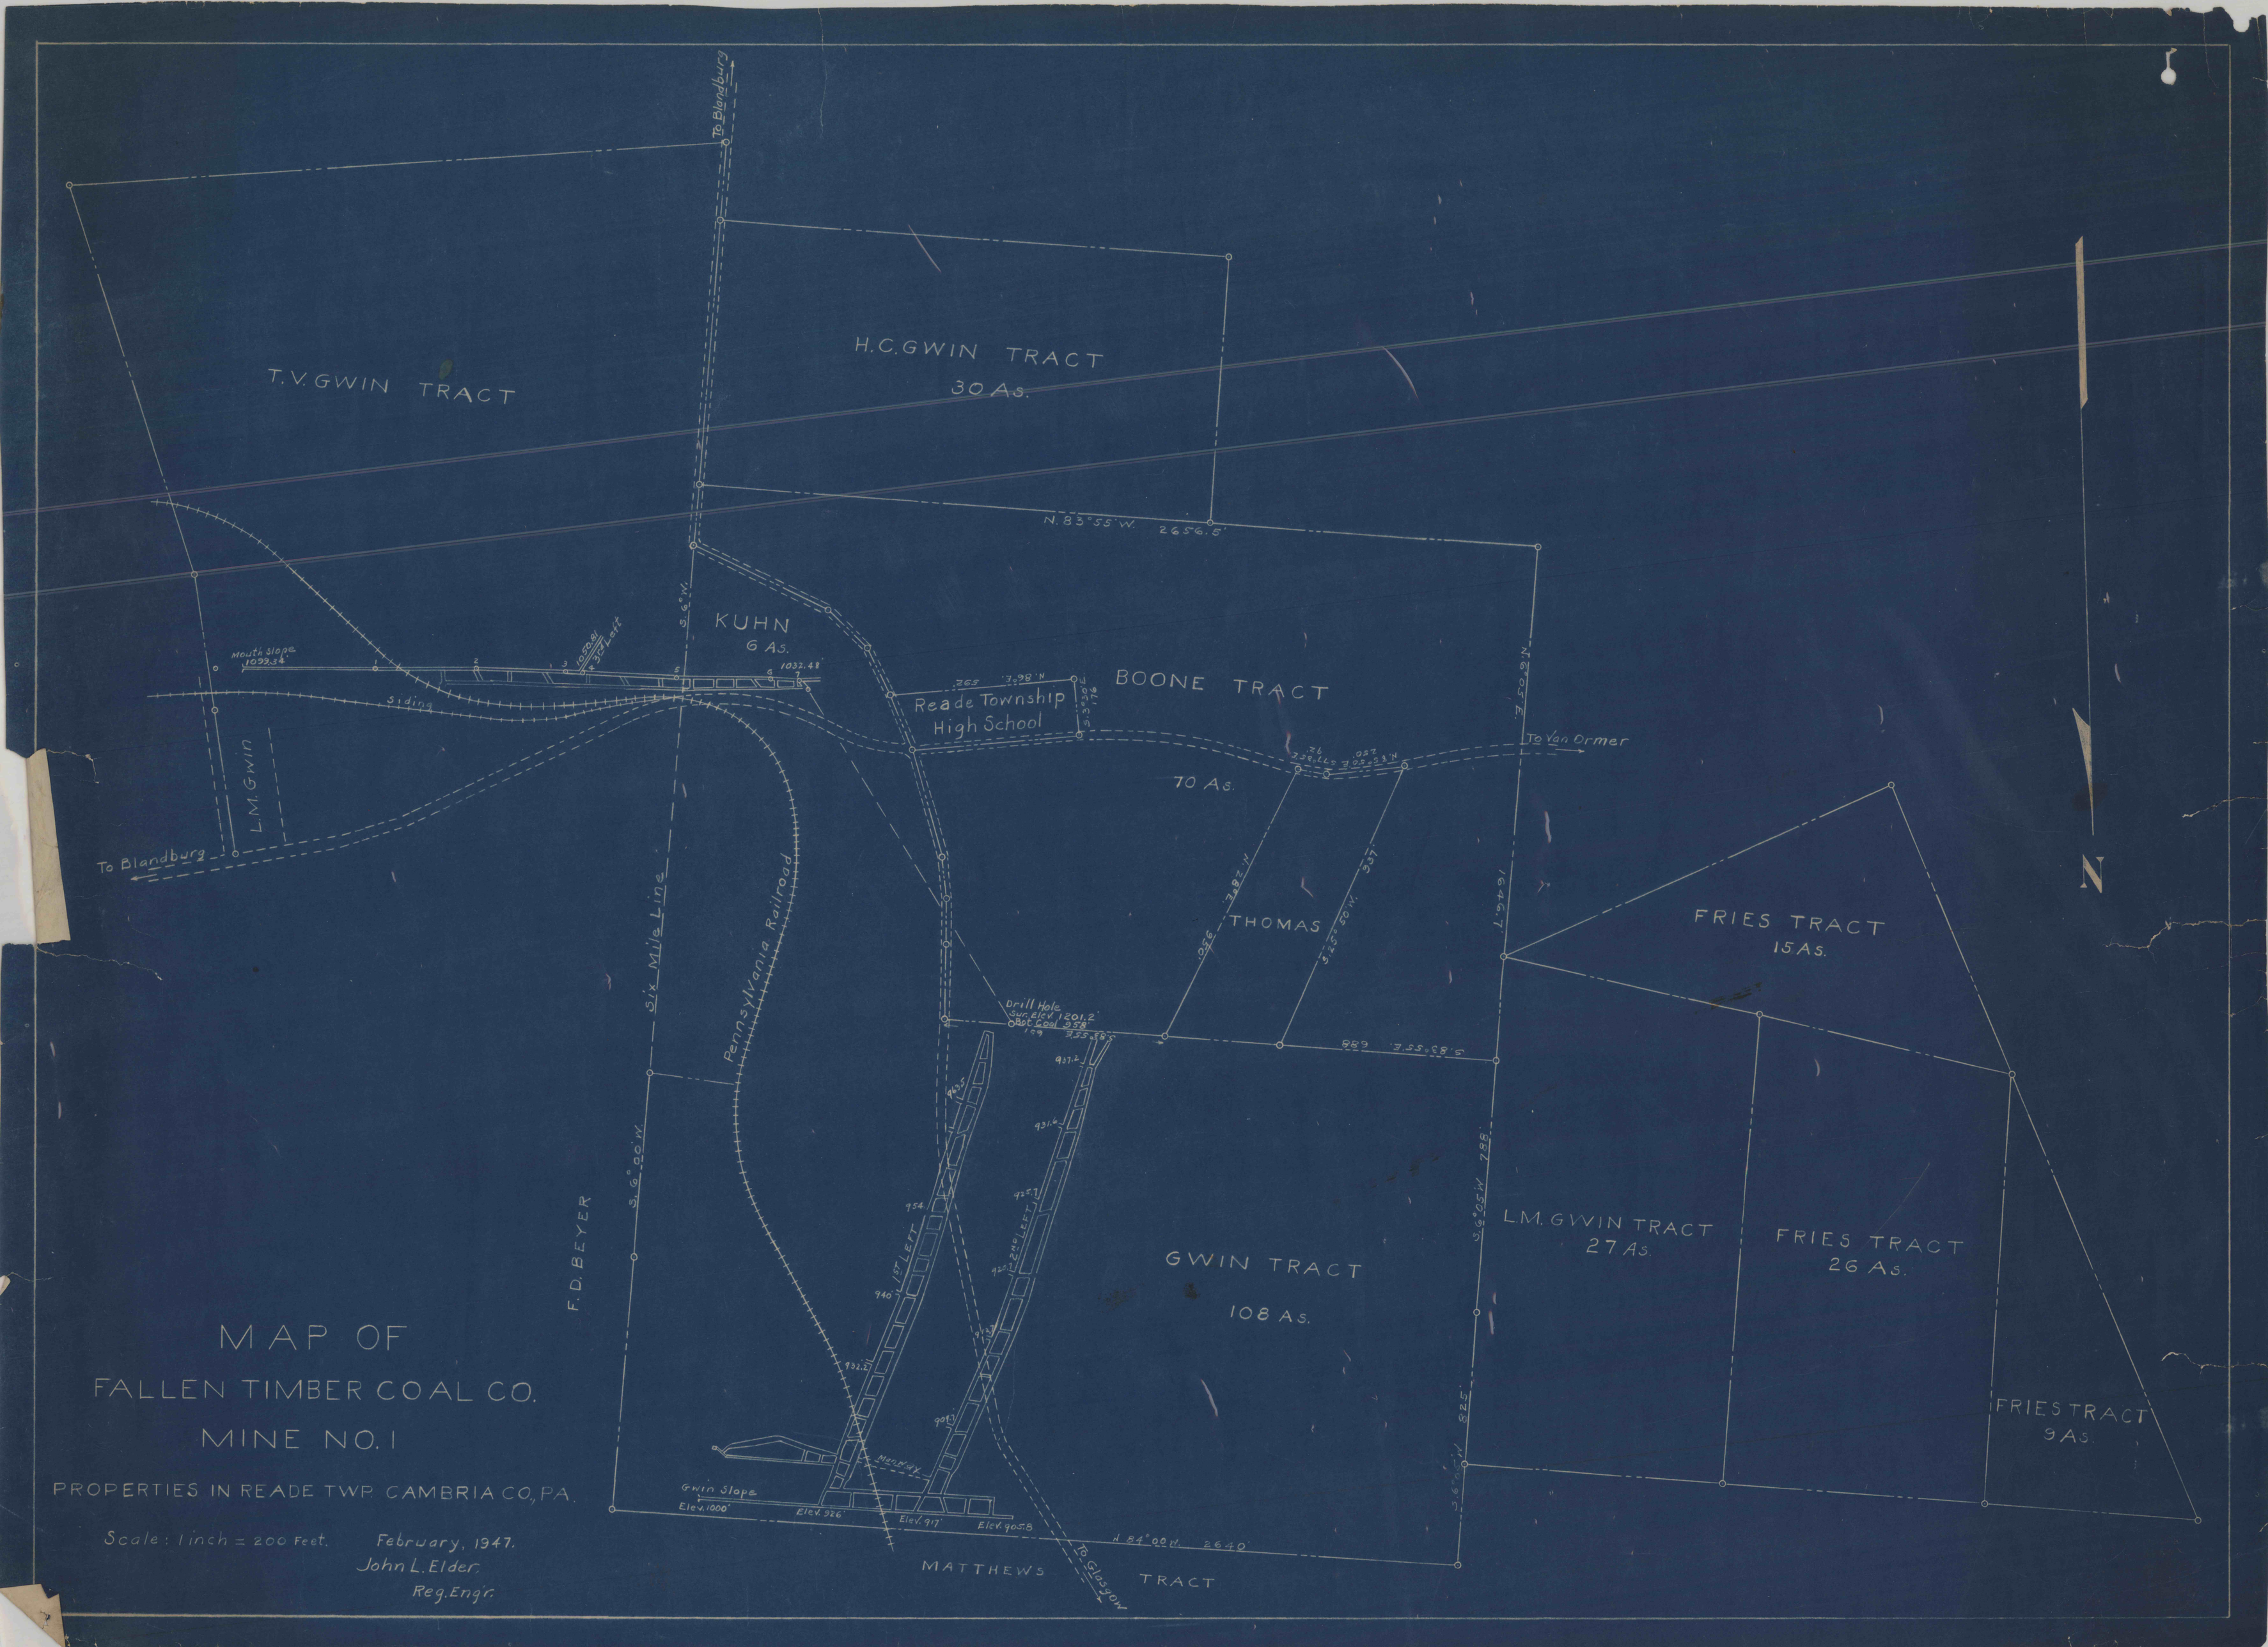

MAP OF
FALLEN TIMBER COAL CO.
MINE NO. 1

PROPERTIES IN READE TWP. CAMBRIA CO., PA.

Scale: 1 inch = 200 Feet.

February, 1947.
John L. Elder.
Reg. Eng'r.