

THOMAS EGER

HENRY EGER

FELIX SHORT

ANN REFFNER

JAMES DICK

JACOB Z


REED COAL MNG. CO.

MINE NO. 1

BAKERTON PA.

MADE FROM REDUCTION OF BASE MAP 11-12-23 BY T. W. MORRIS

SCALE 1" = 200'

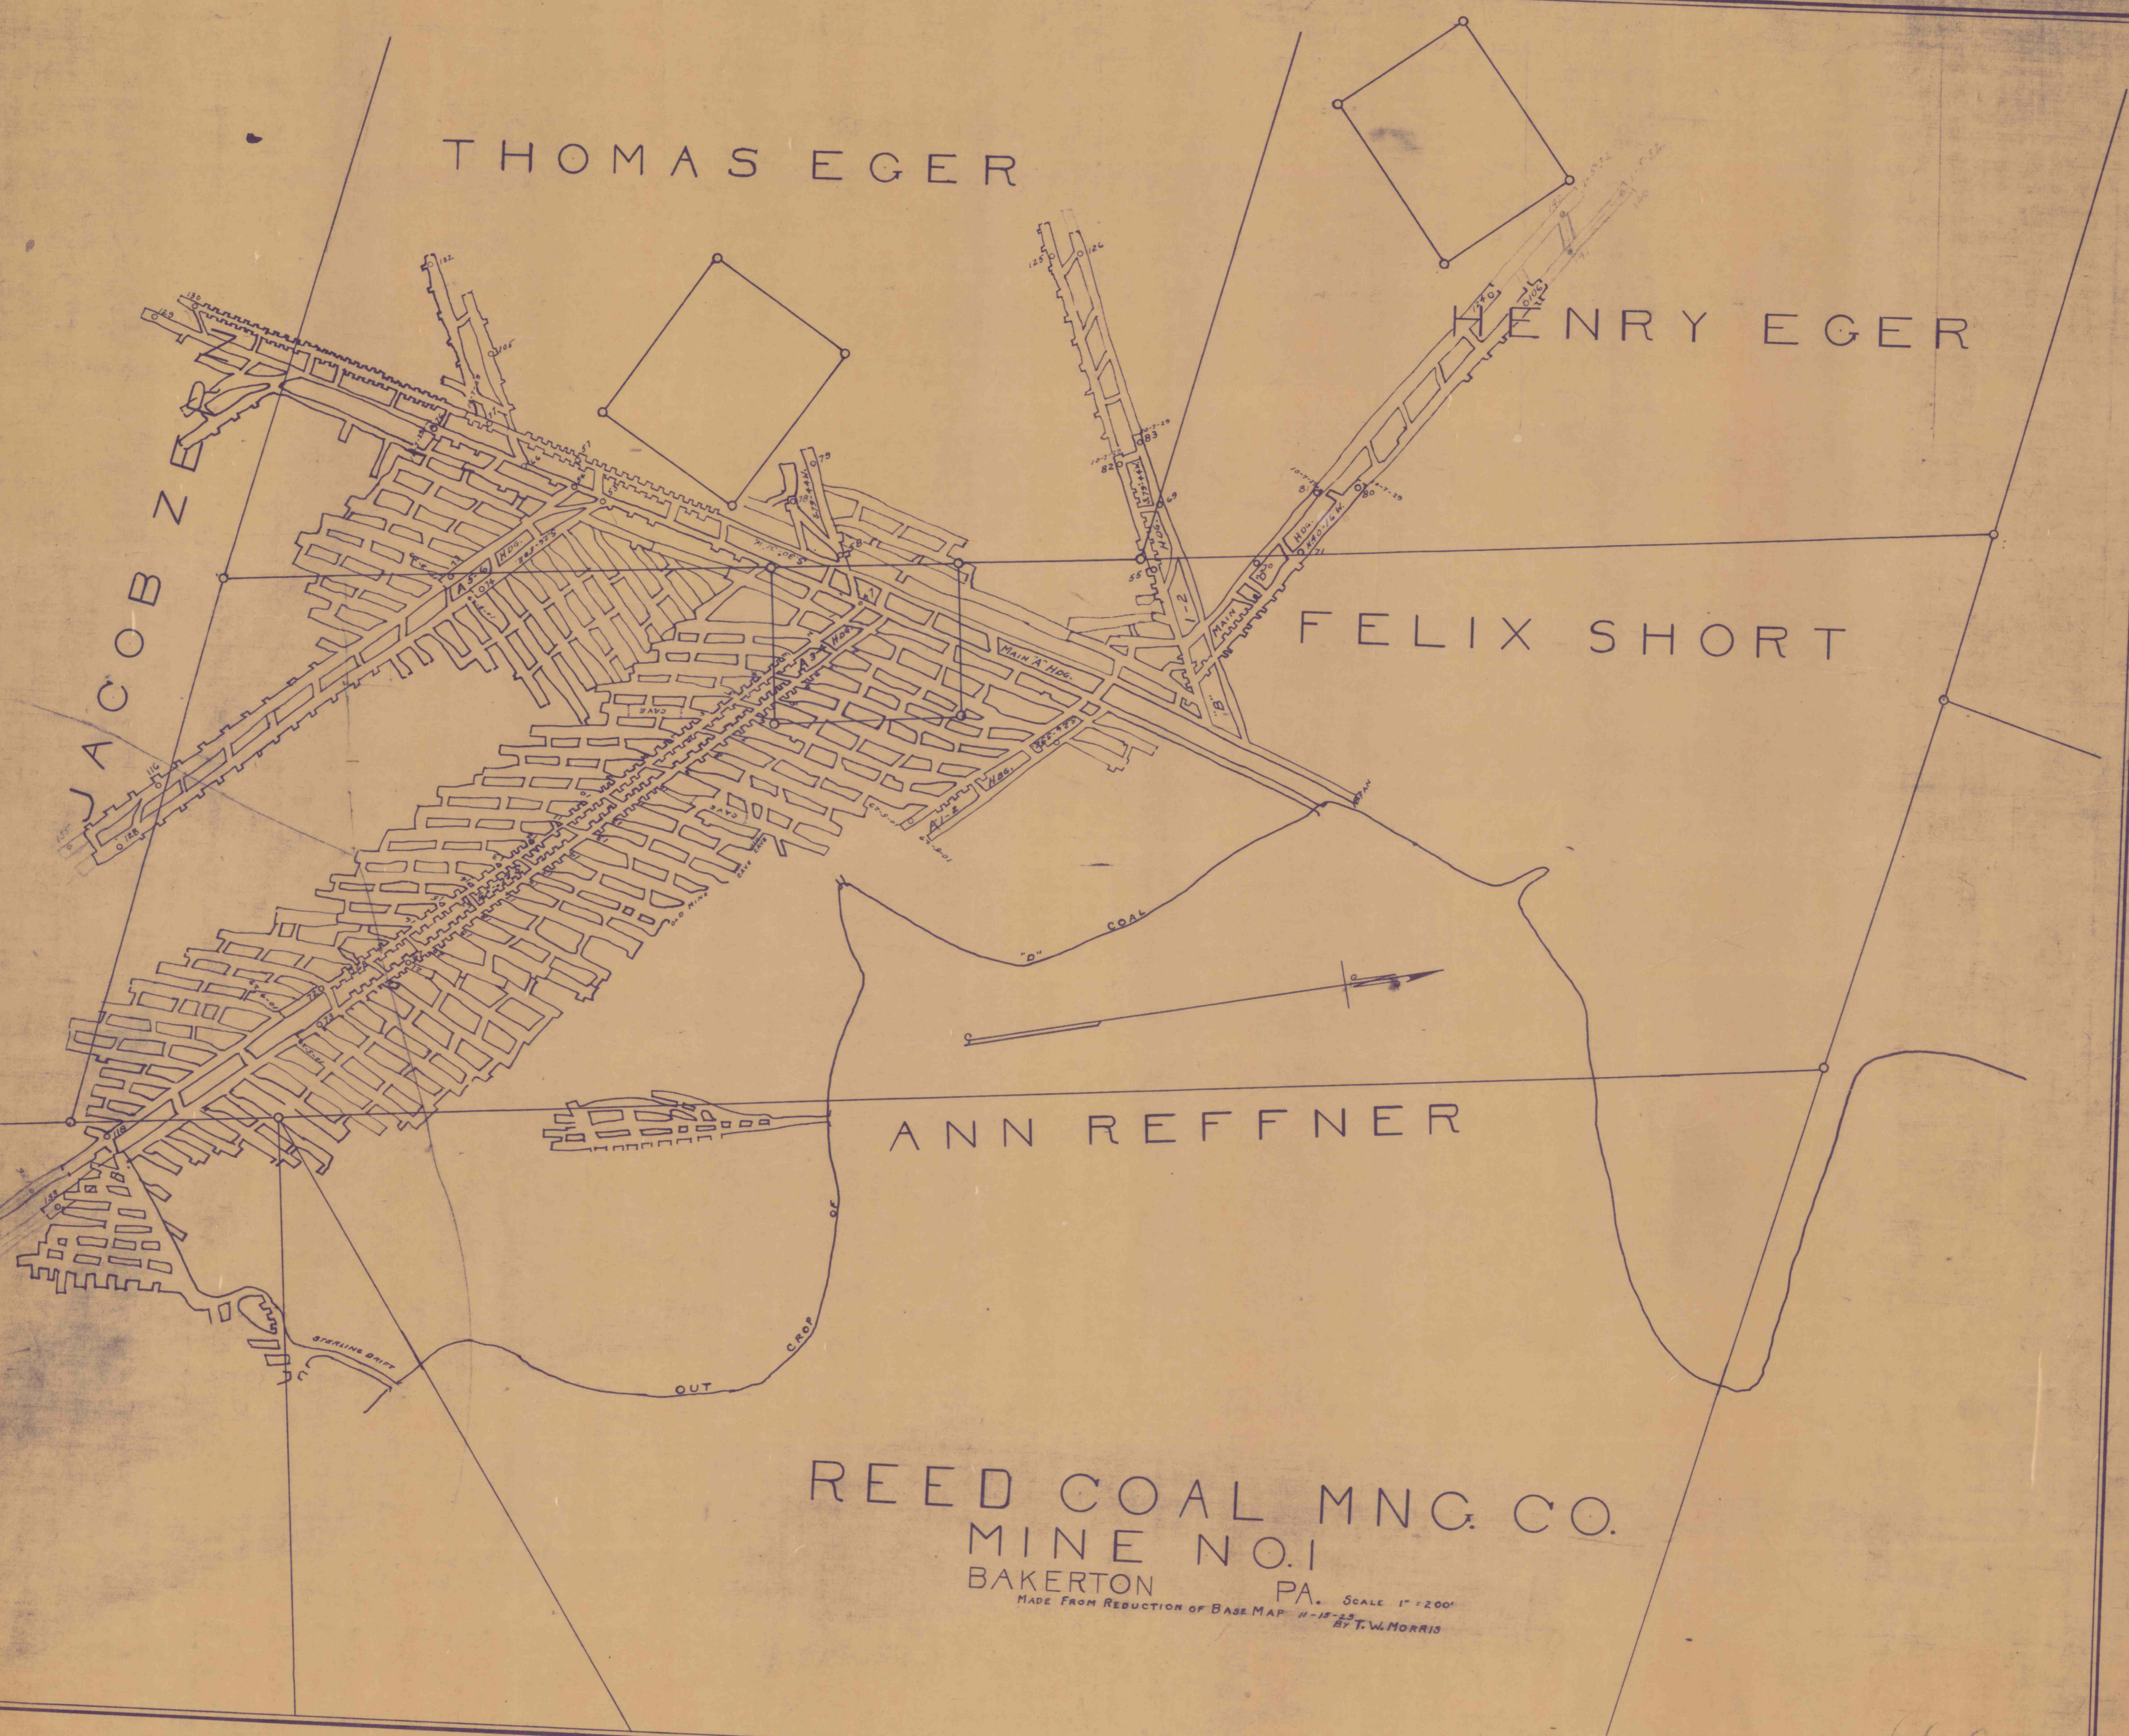

66C