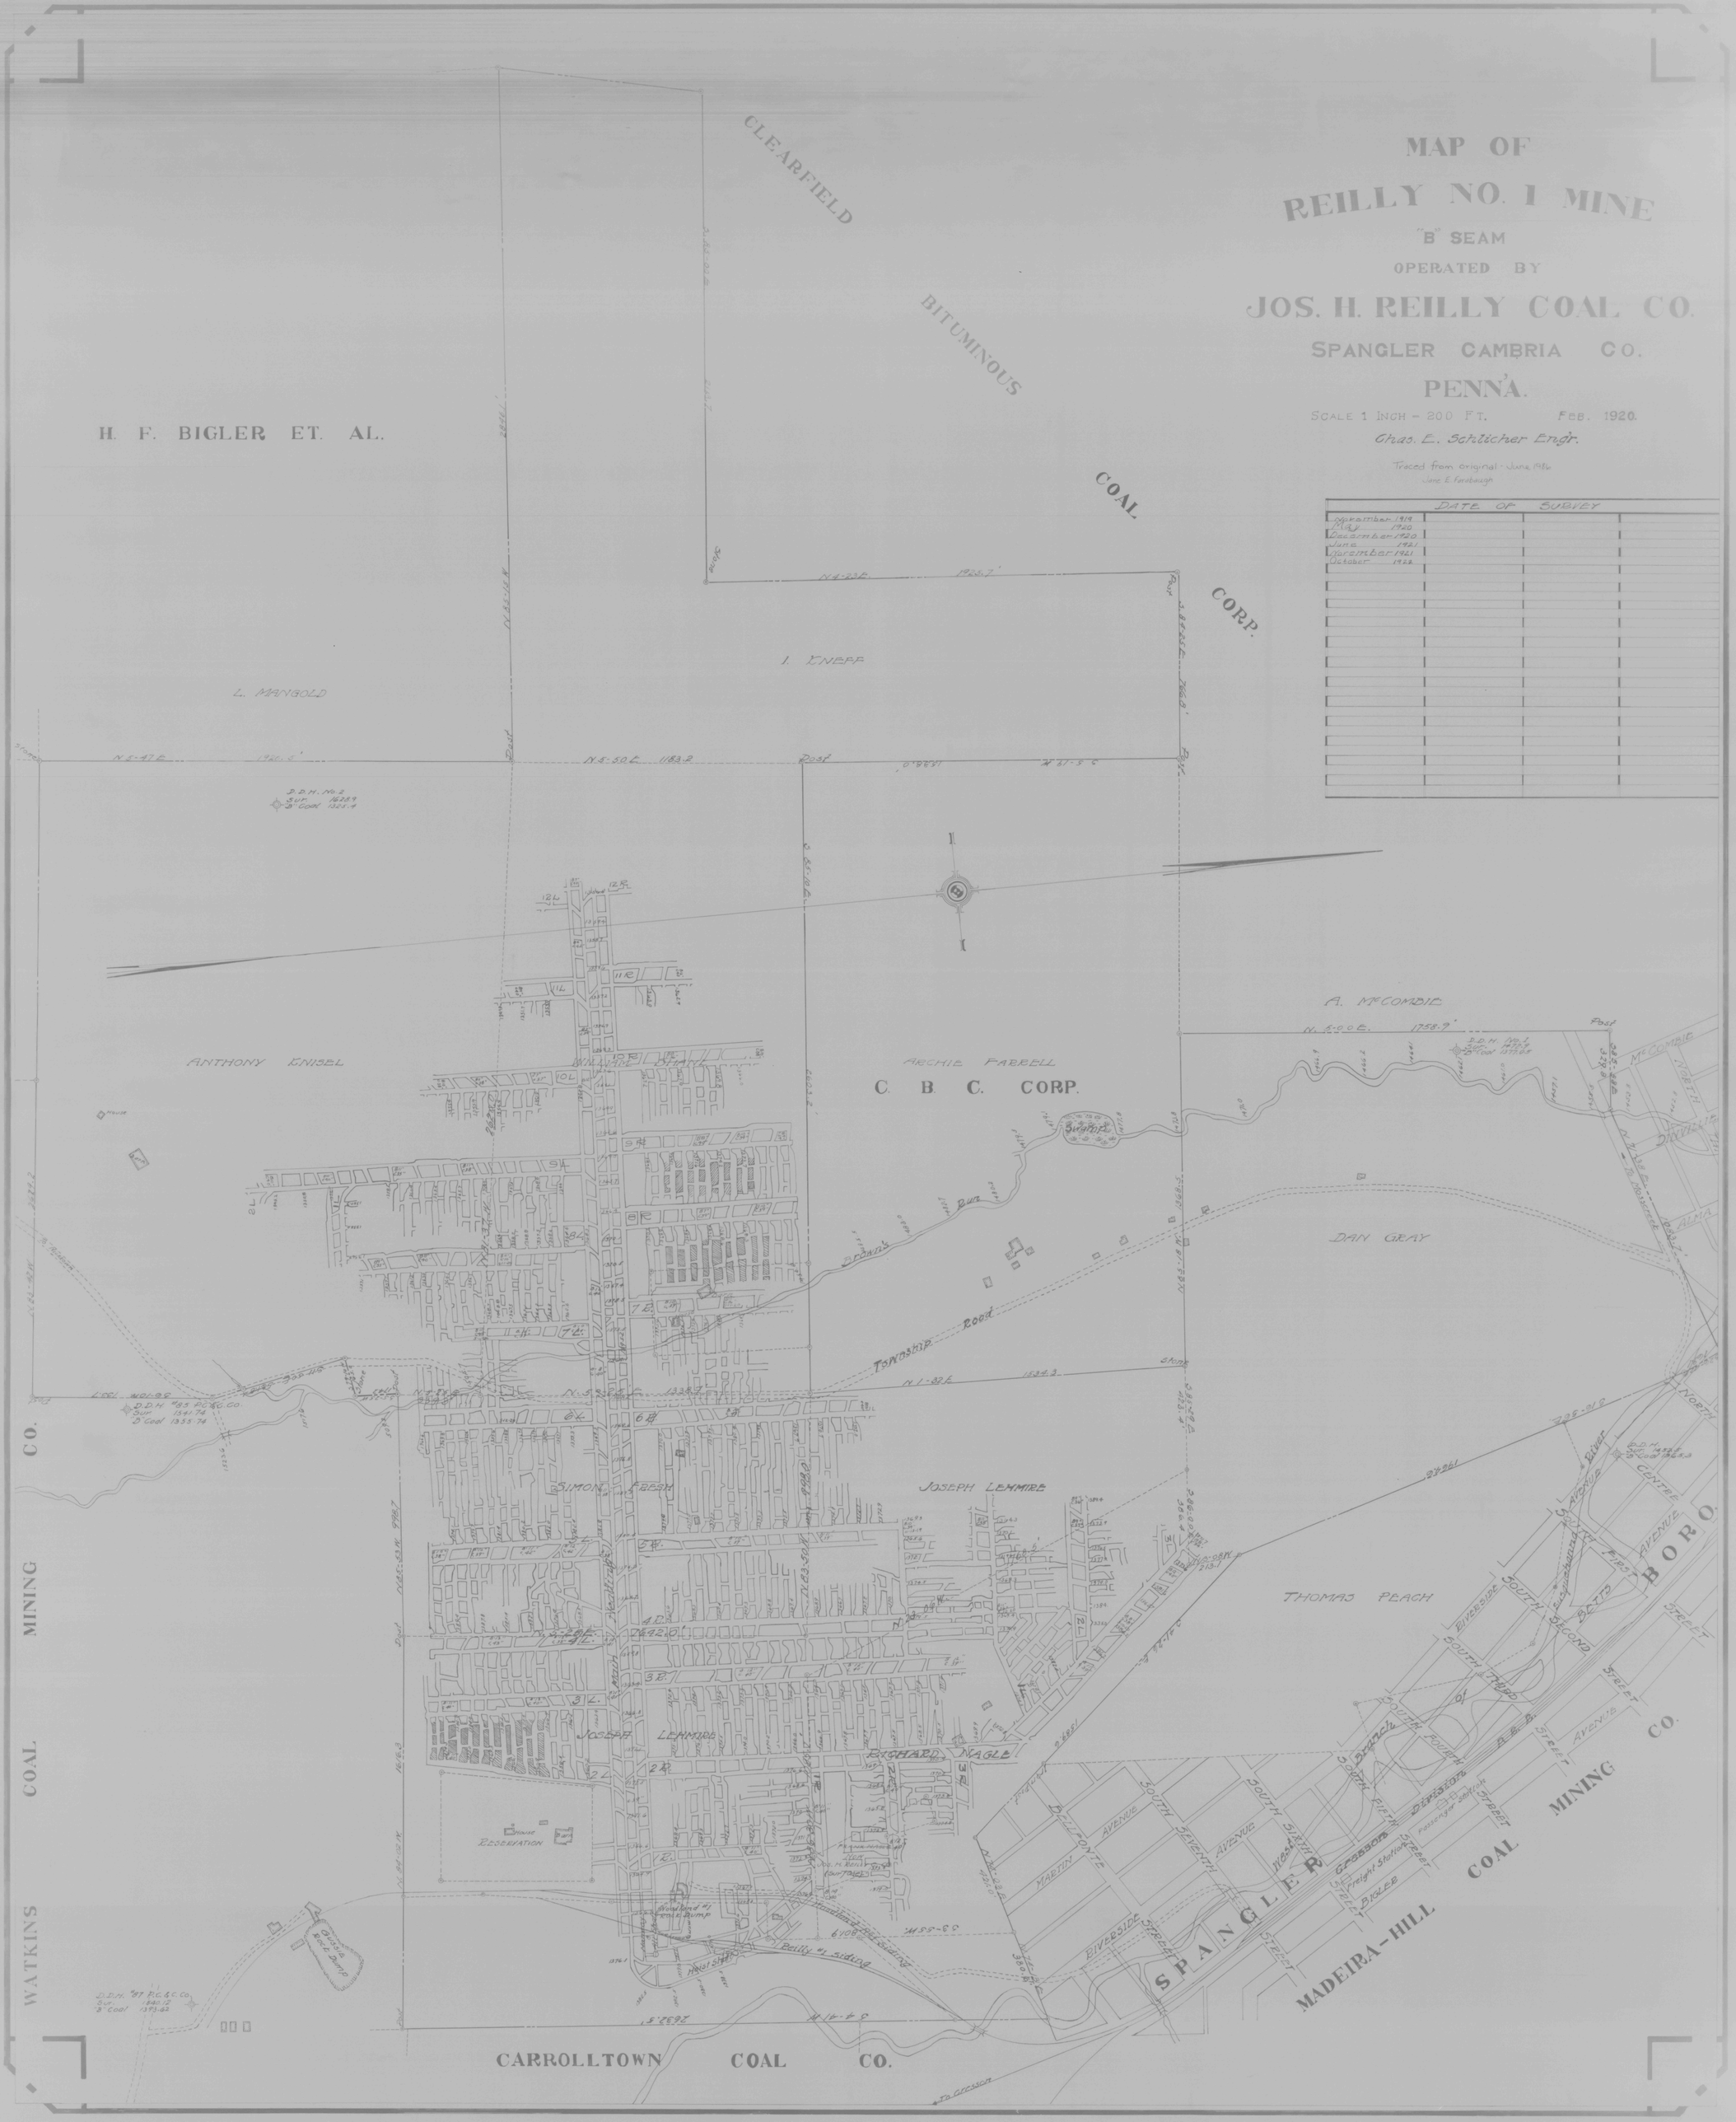
MAP OF
REILLY NO. 1 MINE
"B" SEAM
OPERATED BY
JOS. H. REILLY COAL CO.
SPANGLER CAMBRIA CO.
PENNA.
SCALE 1 INCH = 200 FT.
FEB. 1920.
Chas. E. Schlicher Engr.
Traced from original - June 1986
Jane E. Farabaugh
DATE OF SURVEY
November 1919
May 1920
December 1920
June 1921
November 1921
October 1922
CLEARFIELD
BITUMINOUS
COAL
CORP.
H. F. BIGLER ET. AL.
L. MANGOLD
I. KNEFF
A. McCOMBIE
ANTHONY KNISEL
WILLIAM SHANE
ARCHIE FARRELL
C. B. C. CORP.
DAN GRAY
Township Road
SIMON FRESH
JOSEPH LEHMIRE
THOMAS PEACH
RICHARD NAGLE
RESERVATION
SPANGLER BORO.
MADEIRA-HILL COAL MINING CO.
WATKINS COAL MINING CO.
CARROLLTOWN COAL CO.