






PROPERTY LINE
CONTINGENT MINING
SUPPORT AREA
PROTECTED STRUCTURES
MINING COMPLETED AREA

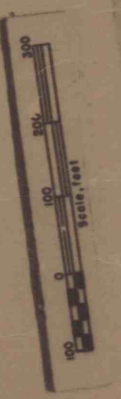

MAP
SHOWING
"B" SEAM WORKINGS
W. H. MILLER COAL CO. PENNA.
REAR TWP. CAMBRIA CO. PENNA.
SCALE: 1" = 100' J.L. SHARPED P.E. ENG.



ASABODDLE HOLE MAP
W. H. MILLER COAL COMPANY
REAR TWP. CAMBRIA CO.
SCALE: 1" = 200' J.L. SHARPED P.E. ENG.
DATE: 11/15/1918

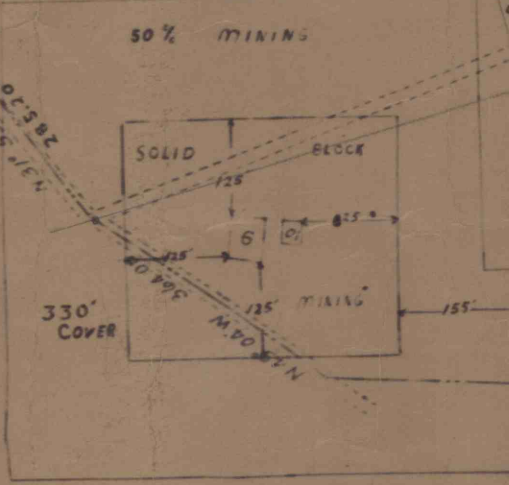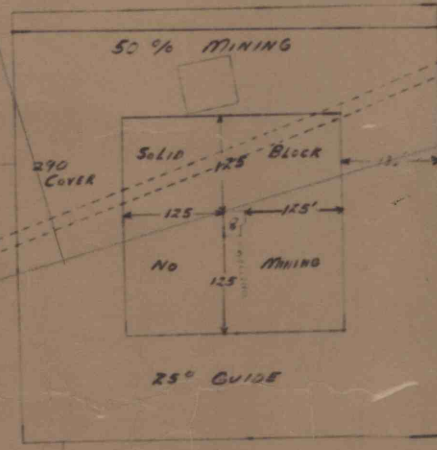



