


SHOEMAKER COAL MINING CO.  
MAP SHOWING WORKINGS OF THE  
WASHINGTON TWP. CAMBRIA CO. PA.  
SCALE 1"=400'

1"=400'

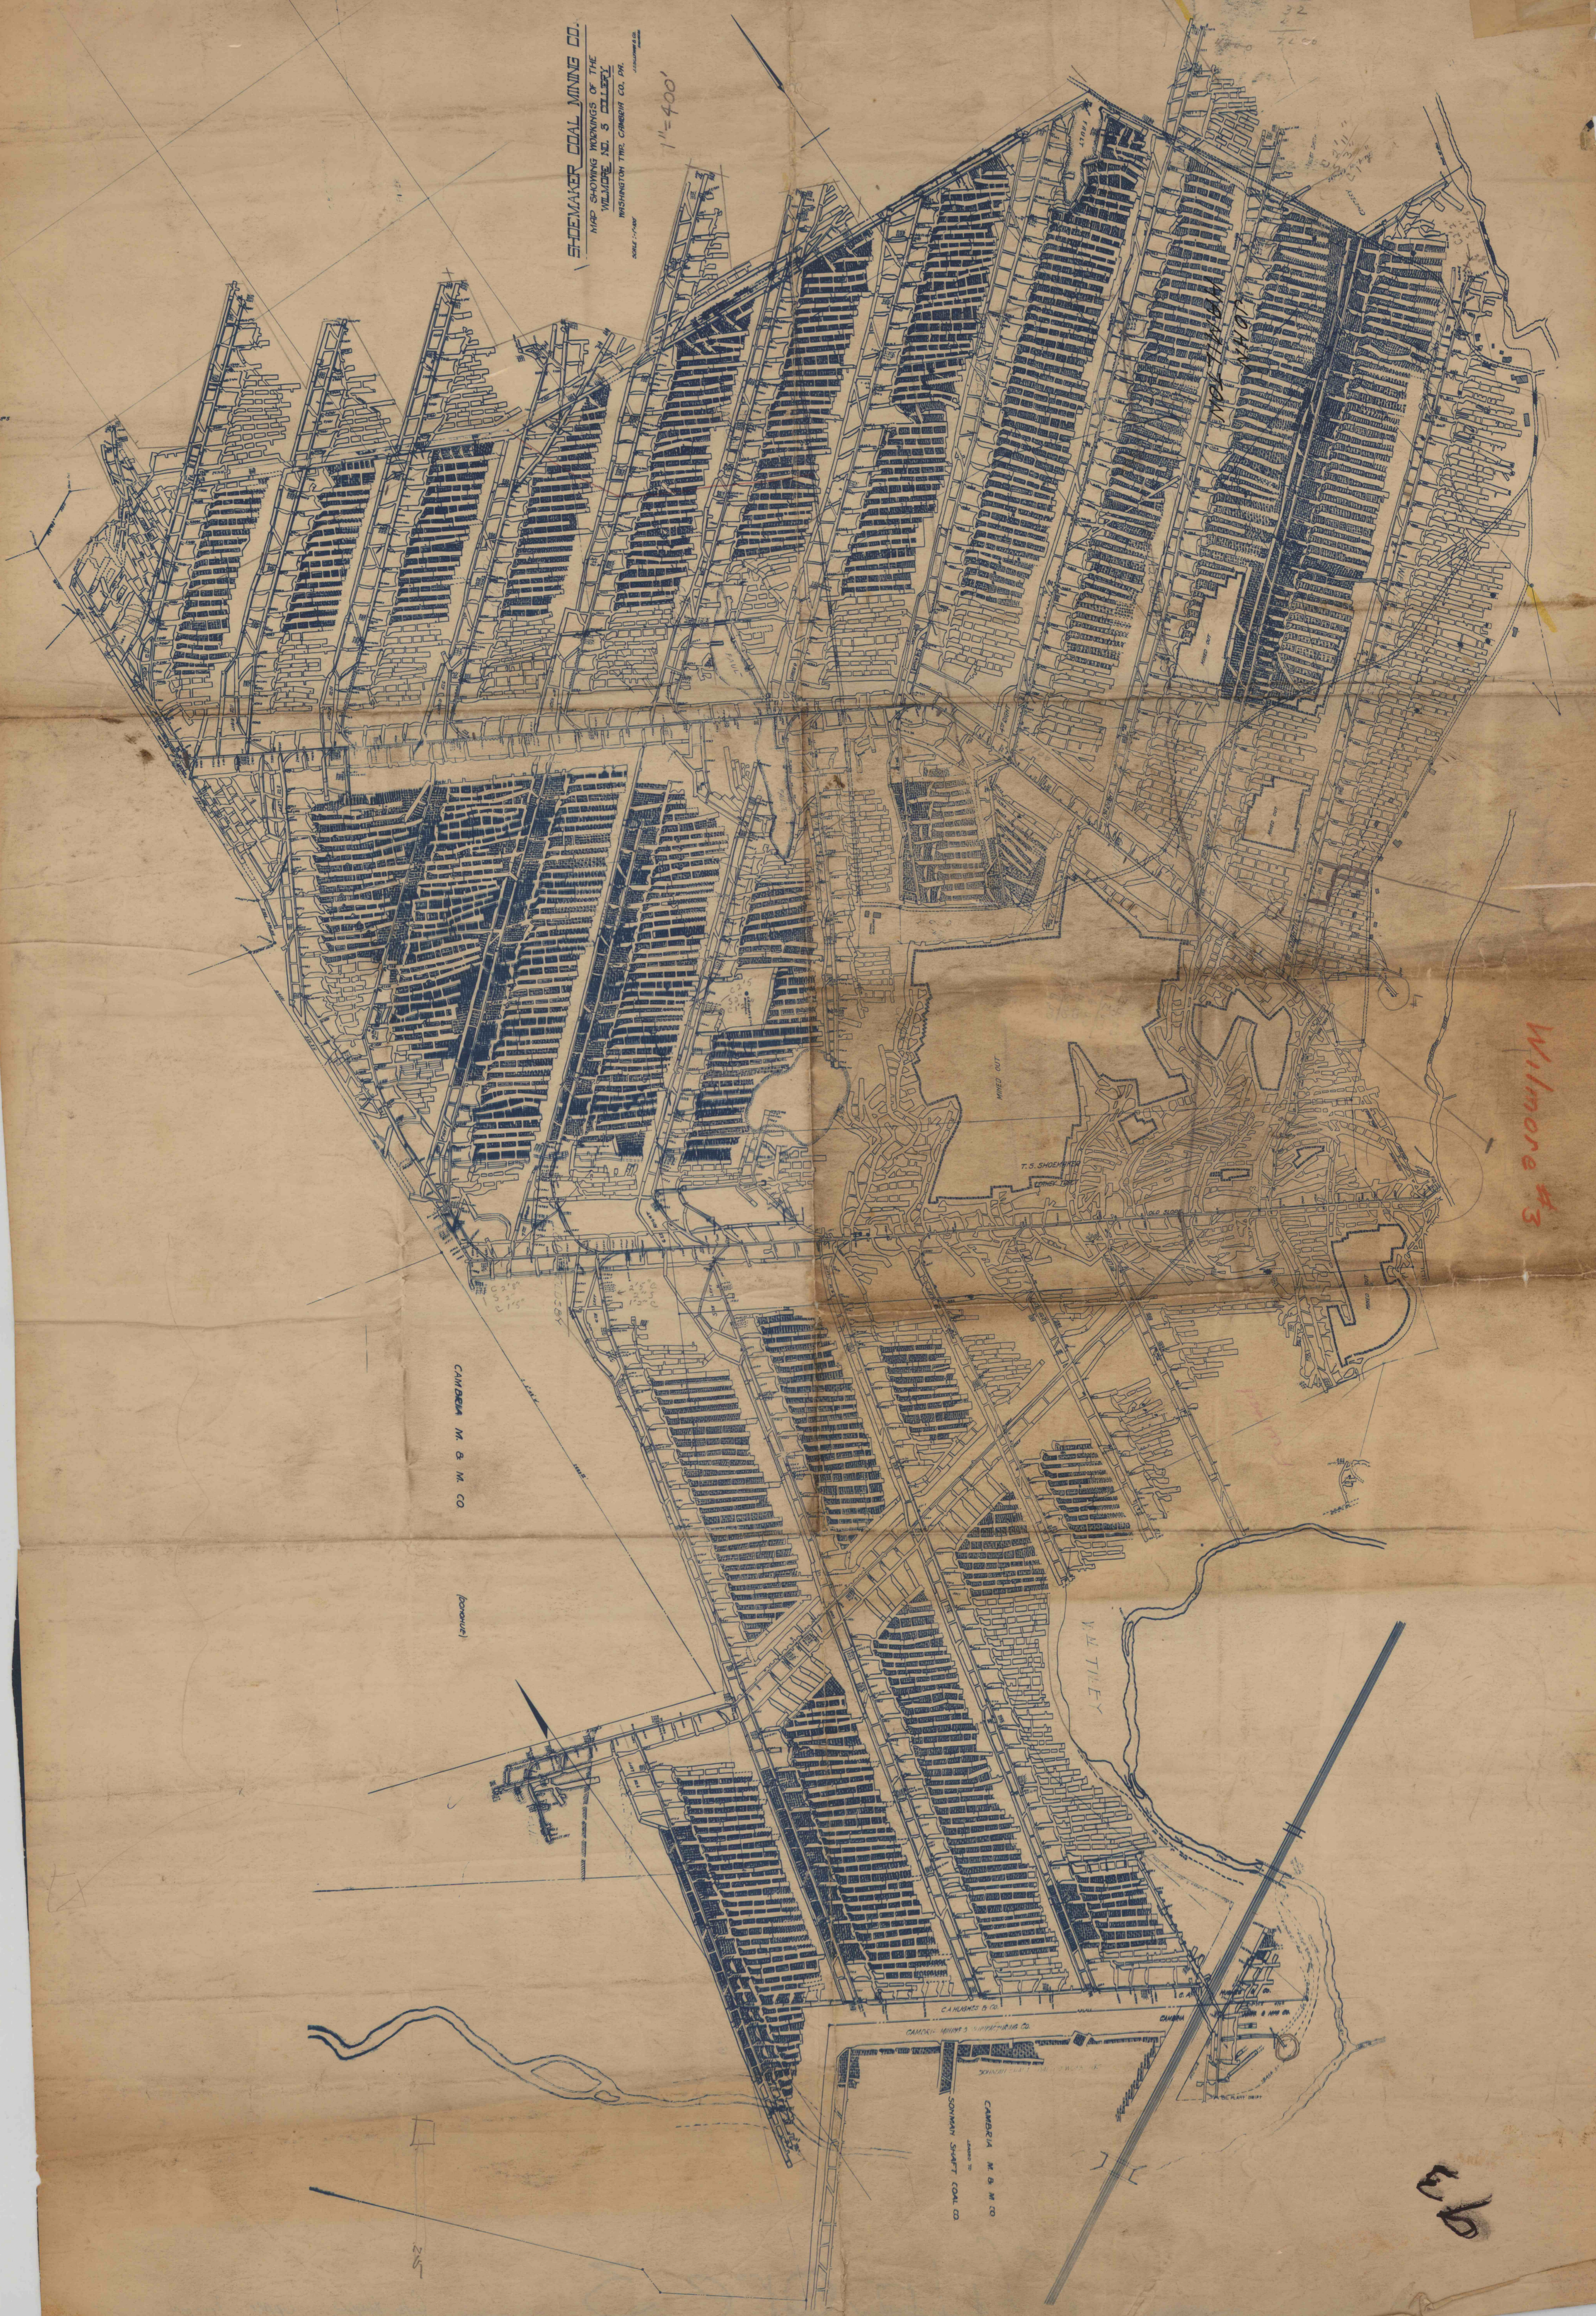

Wilmore #3

W.P.