

JAMES THOMPSON

JAMES MARTIN

**MINED OUT
No 9 MINE**

WILLIAM BARTON NOW
PA GAME COMMISSION

SURFACE-STATE GAME COMMISSION
LOALE HIRSH SWANK'S SONS

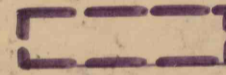

TO STATE HWY. REF. 53 3/4 MILE
HEN RUN

NEW PA GAME COMMISSION

LEWIS WOLF
SKIN OIL

DIP 52°
STRIKE

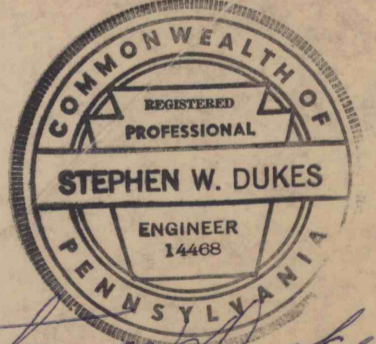
FAULTED AREA

-  Mining Area
Nov. 30, 1967 to
May. 30, 1968
-  Mined Out to
Nov. 30, 1967

MINED OUT PREVIOUSLY
FIRST MINING
NO AVAILABLE MAP
CHAIN PILLARS & HEADING STUMPS
RECOVERABLE

WILLIAM TILTON

EZEKIEL FARMER



Stephen W. Duker

PERMIT No 158-1
SWANK No 13 MINE

**DAVIS COAL CO.
C-PRIME**

DEPT. OF ENVIRONMENTAL PROTECTION
CAMBRIA CO., PA.
SCALE 1"=400'
8.10.1966

66-11-109