

MAP OF
 COAL LANDS OF
 OAK RIDGE CO., PA.
 CHARLES WEAVER & CO.
 1715 N. 10th St. P. A.


LEGEND

419.65 A	WEAVER COAL CO. LEASE
136.00 A.	ISAAC WEAKLAND LEASE
1.90 A	LANTZY & CLARK COAL CO. LEASE
257.42 A.	FEE
820.97 A.	TOTAL

OPENED FEB. 1919

1919	MINING
1920	"
1921	"
1922	"
1923	"
1924	"

John Bearen
 R. Eagle Coal

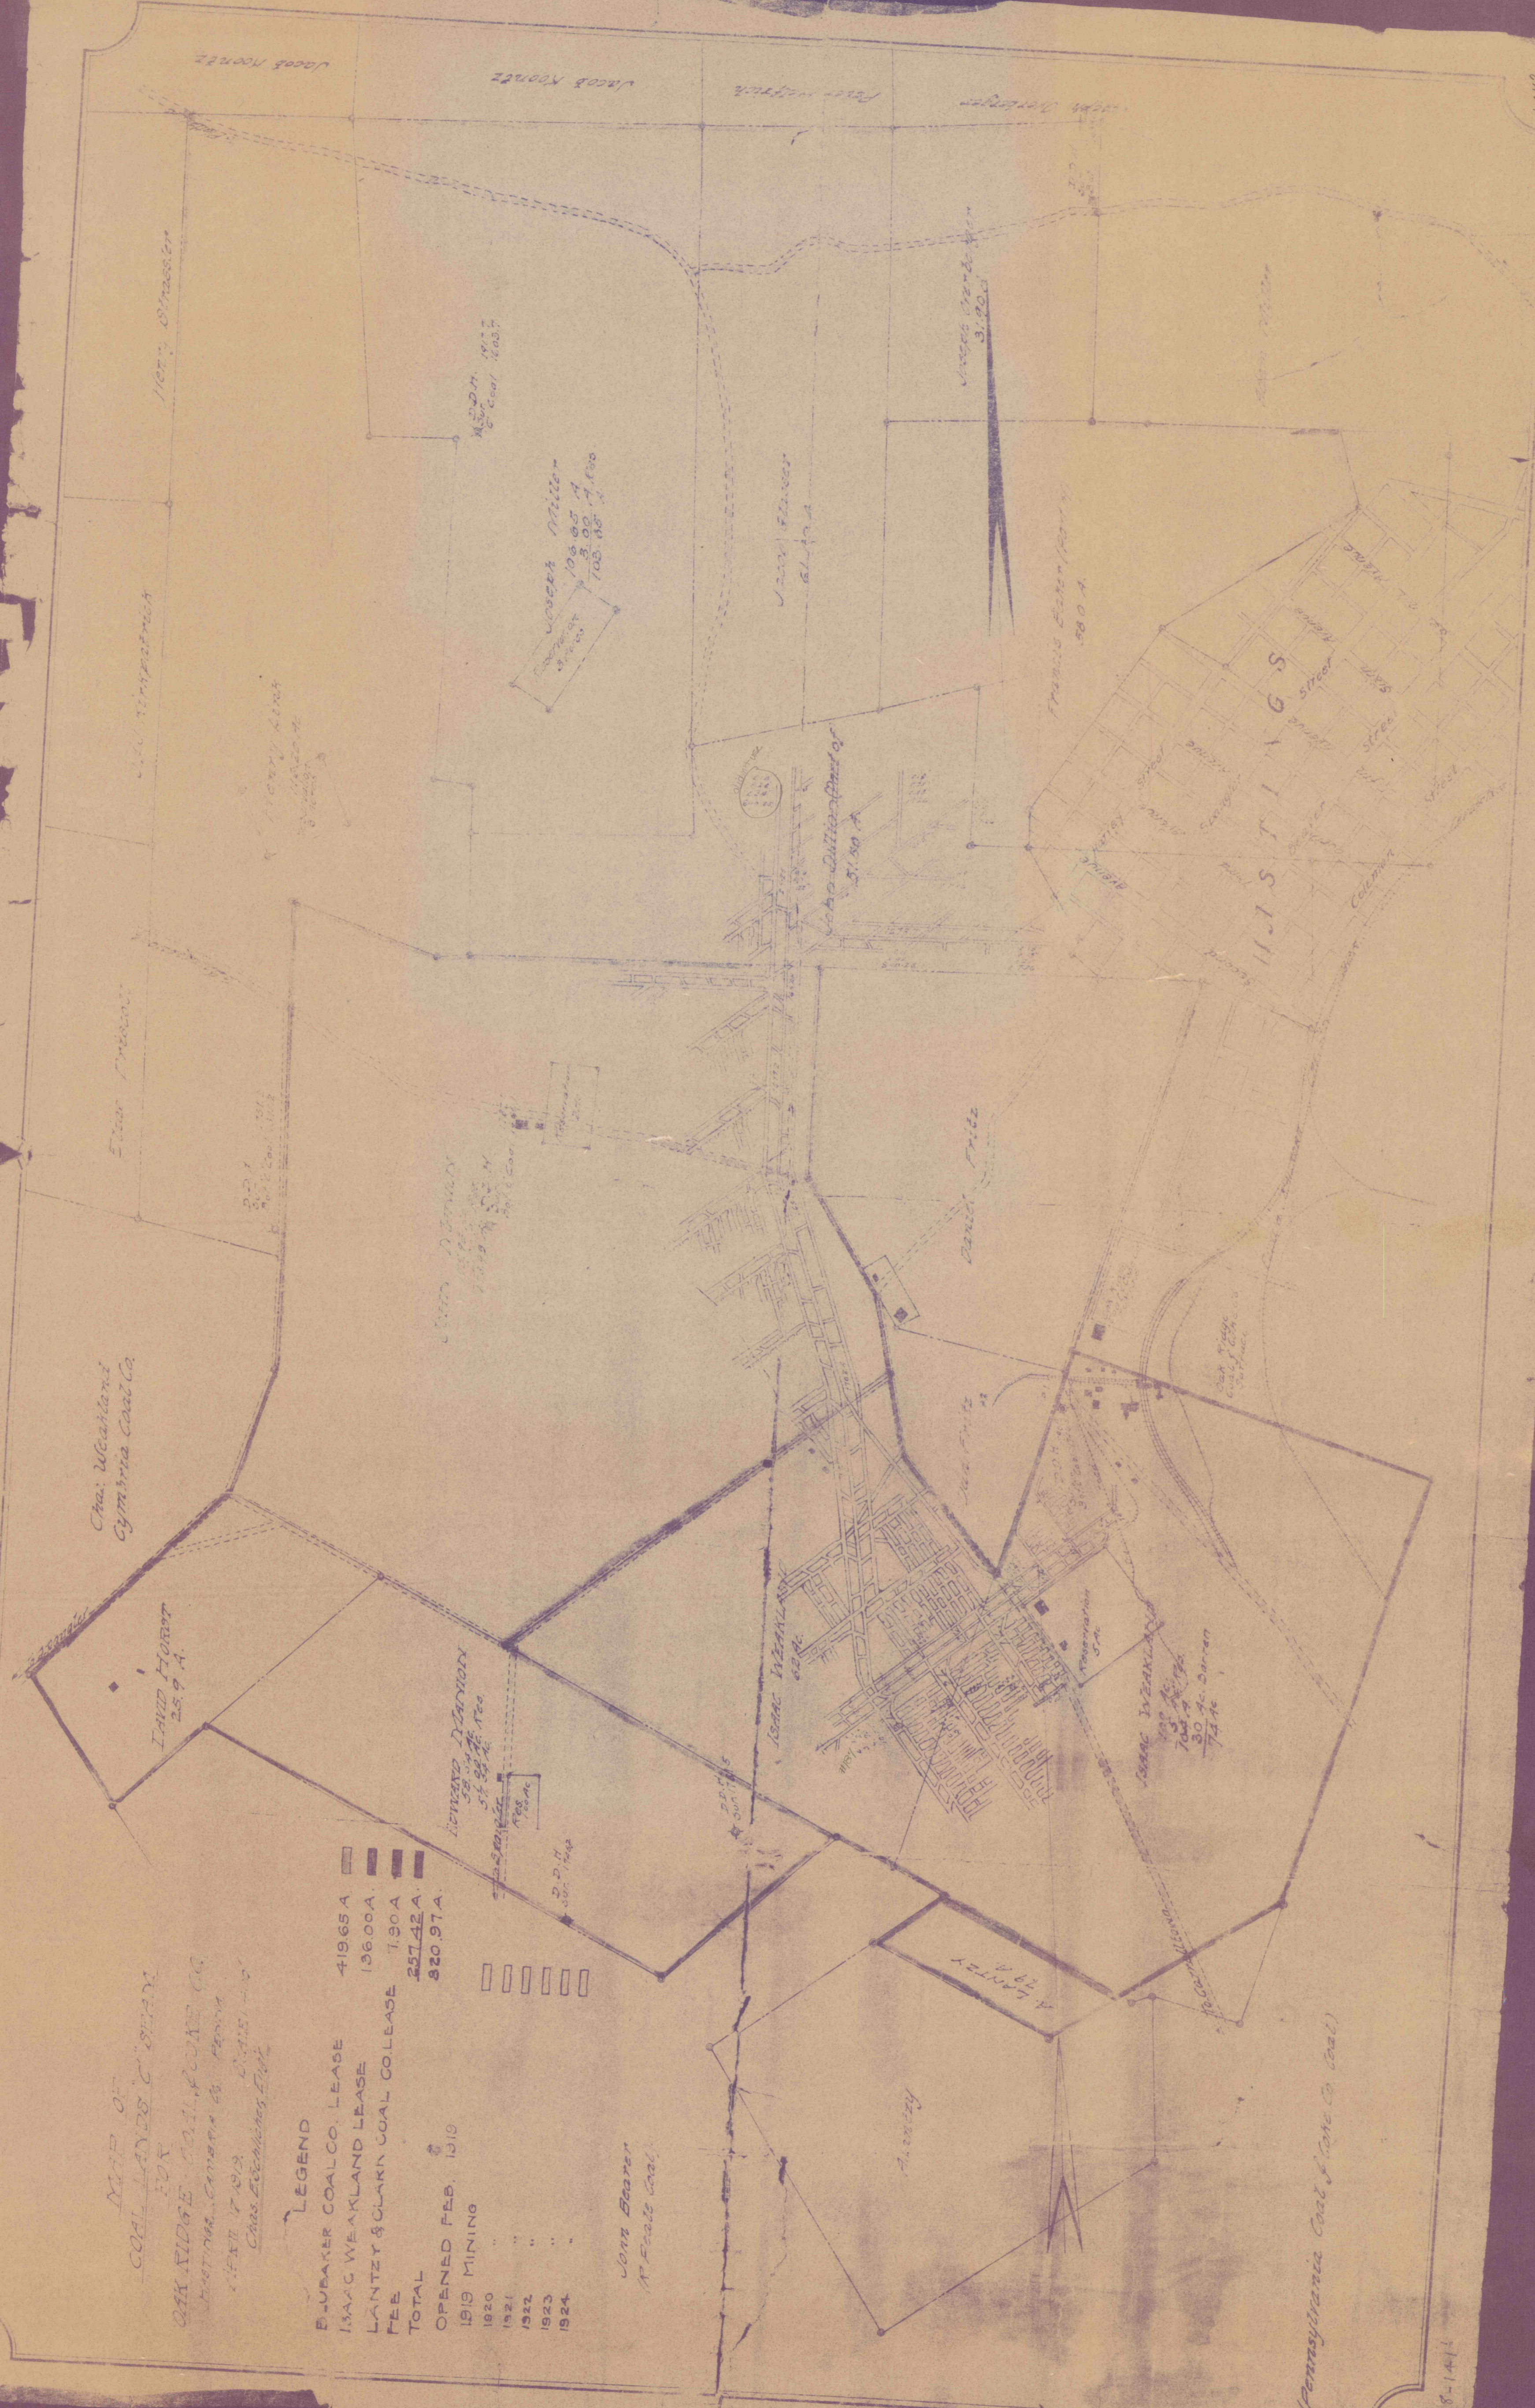

(Pennsylvania Coal & Coke Co. Coal)