


THE BLUBAKER COAL COMPANY

MAP OF
COAL LANDS
IN
CARROLL & BARR TOWNSHIPS, CAMBRIA CO., PA.
SHOWING "D" MINE WORKINGS
OWNED BY

SCALE - 1" = 400'

COLOR SCHEME D'SEAM

LEASED TO DUNCAN SPANGLER COAL CO. BY
" " CARROLLTOWN COAL CO. BY
NOT LEASED BY BROWN

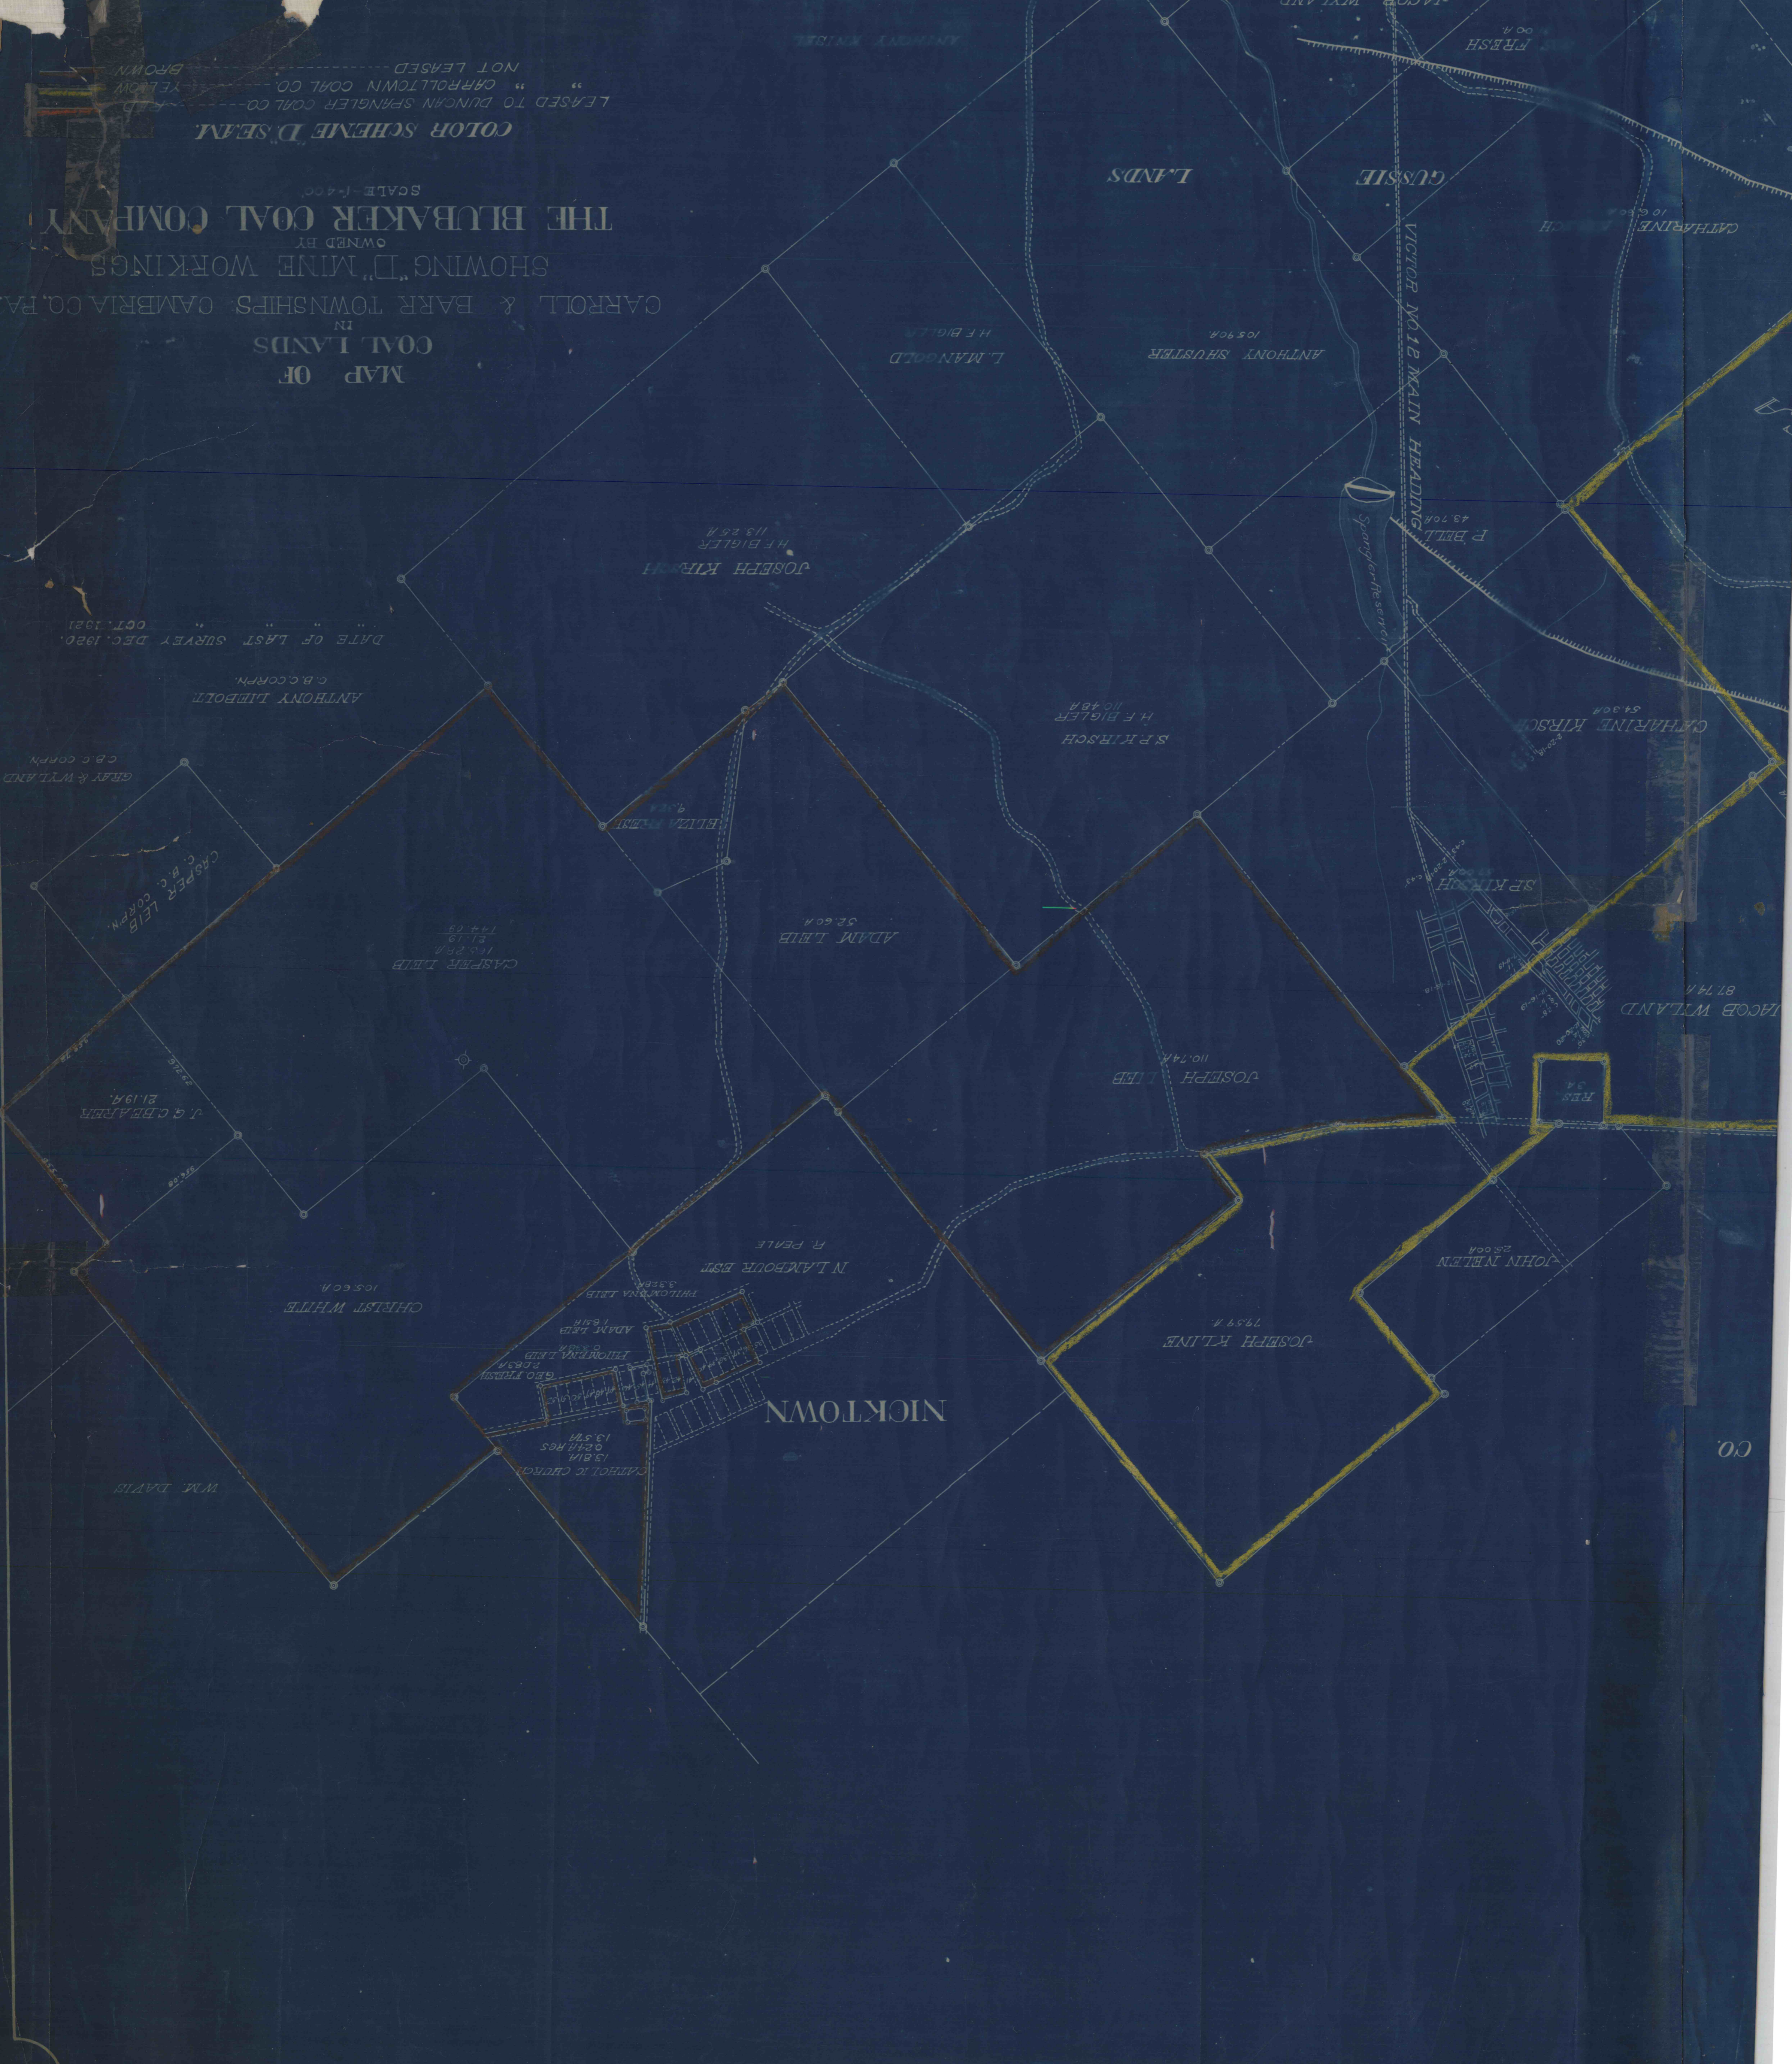

DATE OF LAST SURVEY DEC. 1920.
OCT. 1921

ANTHONY LIEBOLT
C.B.C. CORP.

GAFF & WYLAND
C.B.C. CORP.

CASPER LIEB
C.B.C. CORP.

CASPER LIEB
16.25 A.
174.69

ADAM LIEB
52.60 A.

J. G. BEAVER
21.19 A.

CHRIST WHITE
105.60 A.

W.M. DAVIS

CATHOLIC CHURCH
13.81 A.
6.21 A. RES.
13.57 A.

GEO. FRENCH
0.83 A.

EMILY LIEB
22.83 A.

ADAM LIEB
1.81 A.

PHILIP LIEB
3.28 A.

N. LAVBOUR EST.
R. PENLE

JOSEPH LIEB
110.74 A.

JOSEPH KLINE
79.59 A.

JOHN MEIER
25.00 A.

H.S.
2.4

JACOB WYLAND
81.74 A.

CATHARINE KIRSCH
54.90 A.

S.P. KIRSCH
H.F. BIGLER
110.48 A.

JOSEPH KIRSCH
H.F. BIGLER
113.25 A.

L. MANGOLD
H.F. BIGLER

ANTHONY SHUSTER
105.90 A.

P. BELL
43.70 A.

CATHARINE
10.60 A.

JACOB WYLAND
61.40 A.

FRESH
00 A.