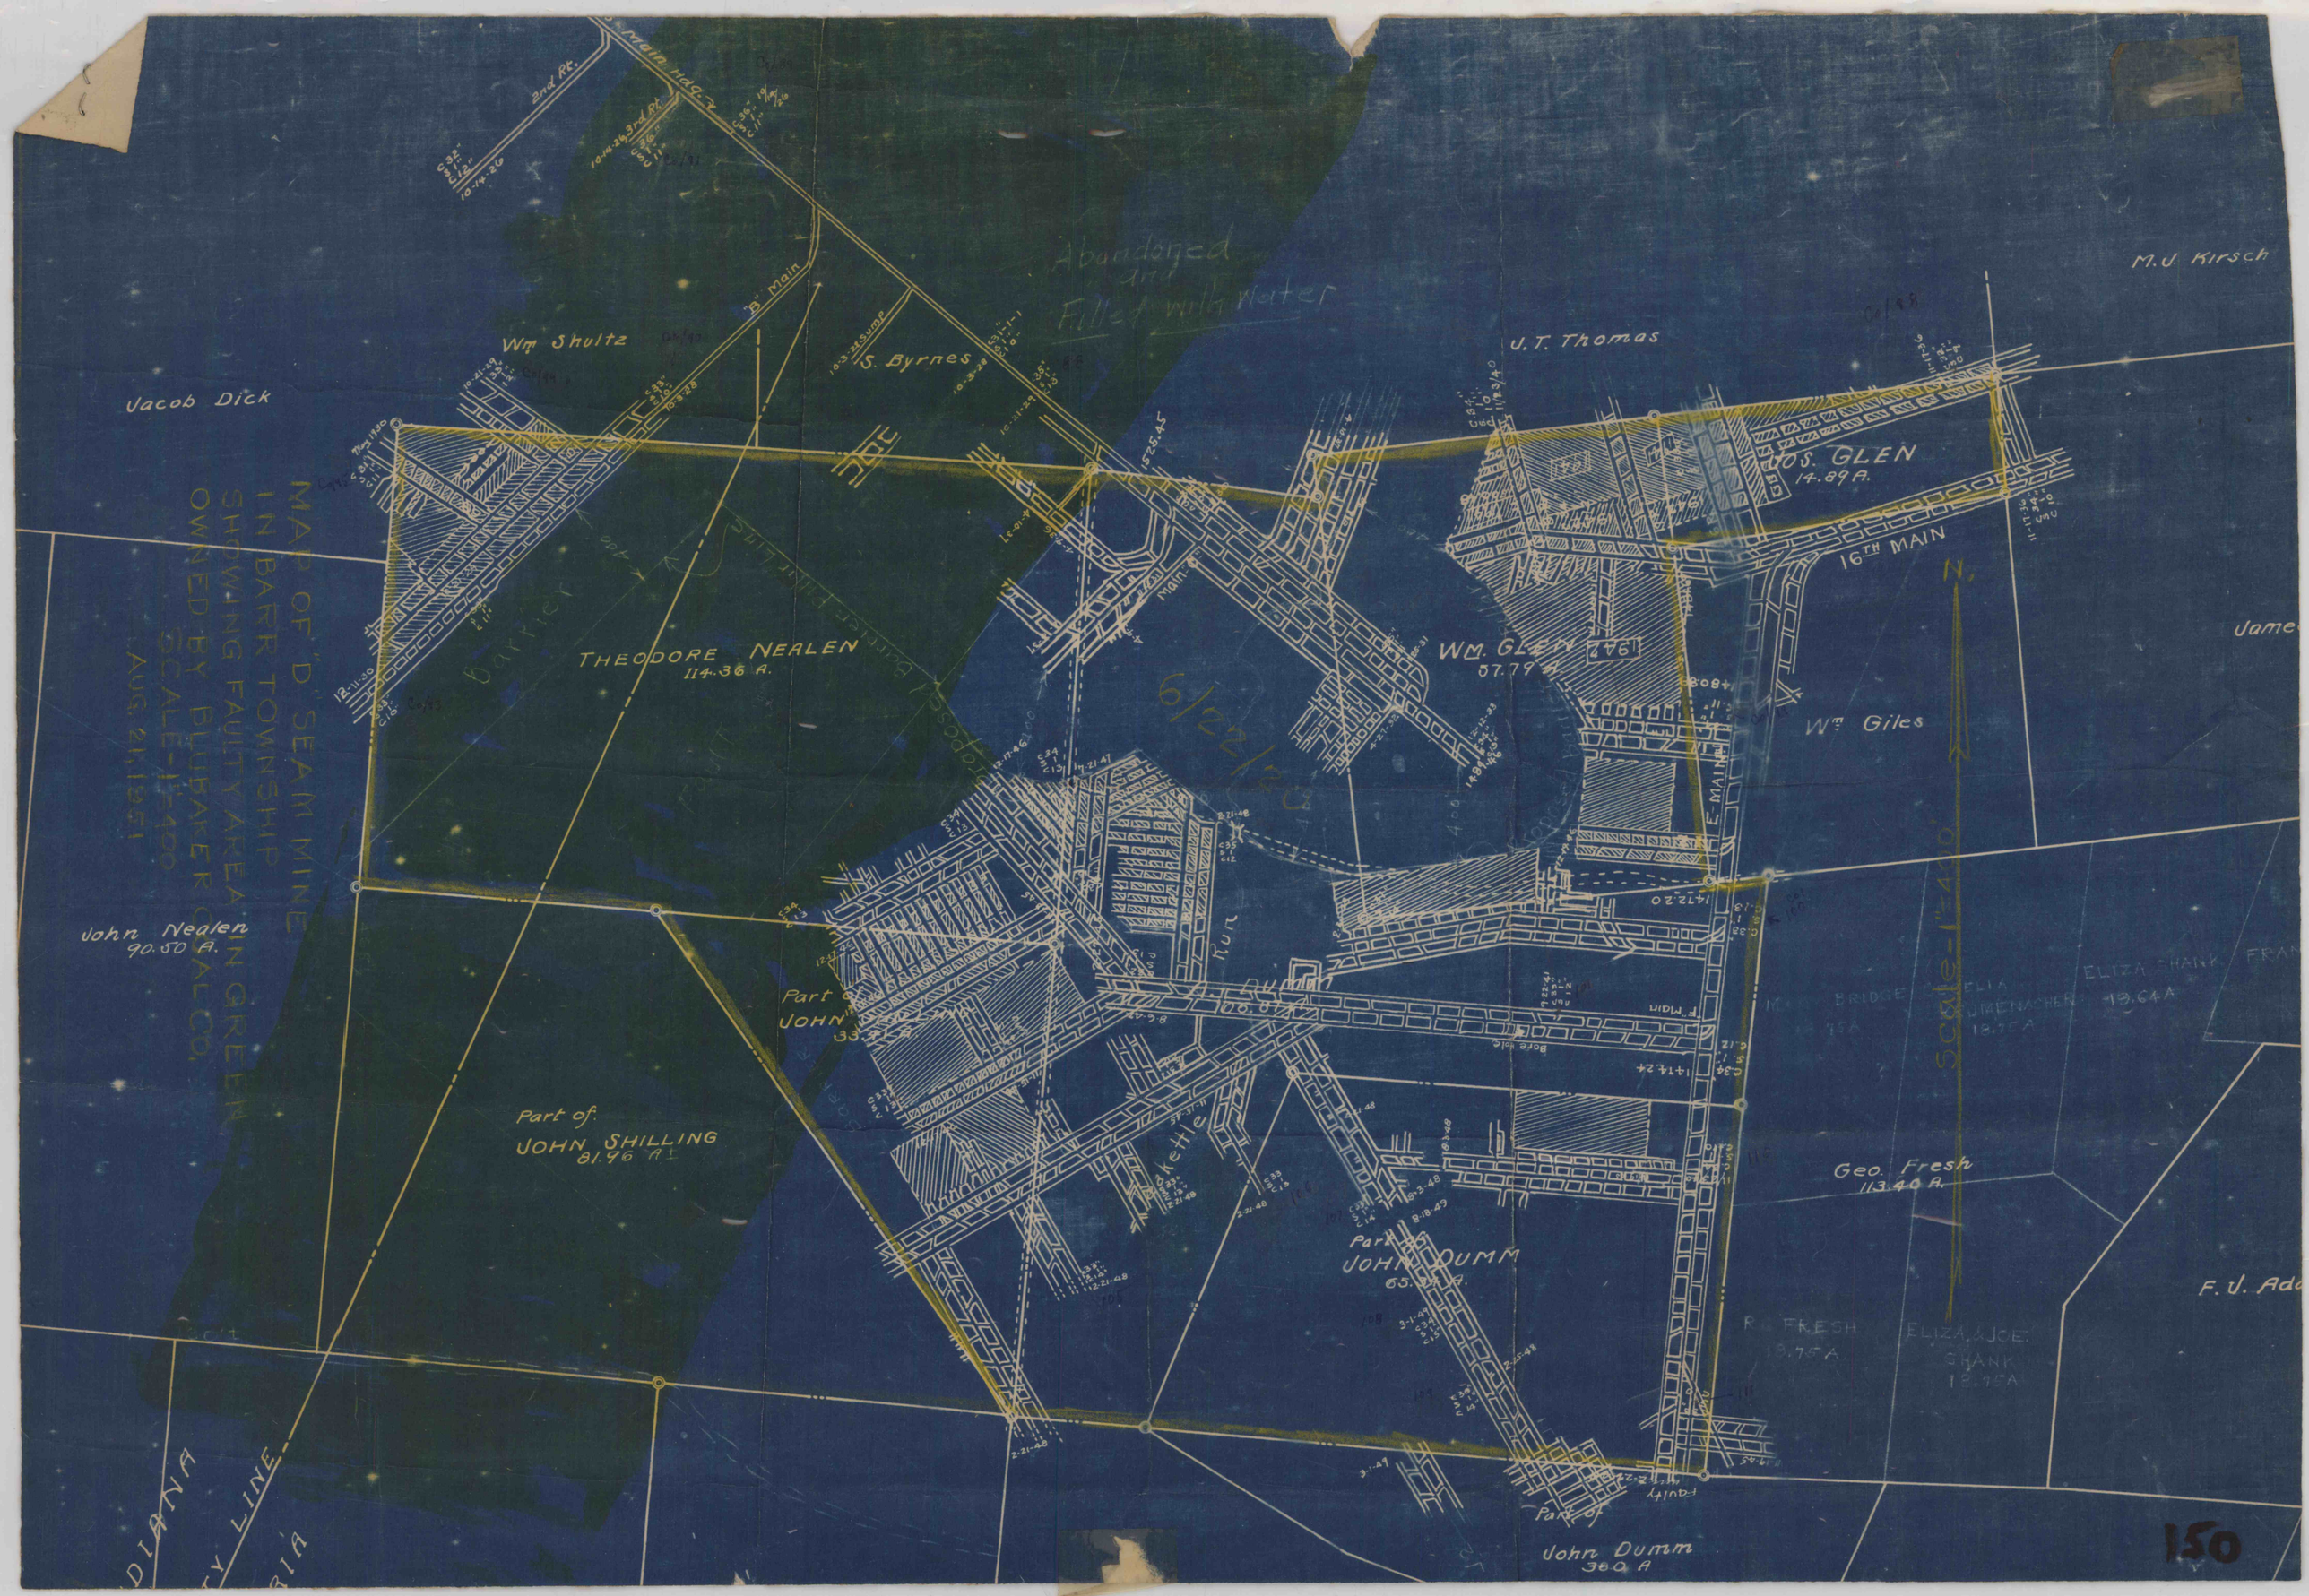
MAP OF "D" SEAM MINE
IN BARR TOWNSHIP
SHOWING FAULTY AREA IN GREEN
OWNED BY BLUBAKER COAL CO.
SCALE-1"=400
AUG. 21, 1951
Jacob Dick
Wm Shultz
S. Byrnes
J.T. Thomas
M.J. Kirsch
Abandoned and Filled with Water
THEODORE NEALEN
114.36 A.
JOS. GLEN
14.89 A.
16TH MAIN
WM. GLEN
57.79 A.
Wm Giles
John Nealen
90.50 A.
Part of JOHN SHILLING
81.96 A±
Part of JOHN DUMM
65.34 A.
Geo. Fresh
113.40 A.
ELIZA SHANK
19.64 A
ELIZA & JOE SHANK
18.75 A
R. FRESH
18.75 A
Part of John Dumm
380 A
Scale-1"=400
N.
150