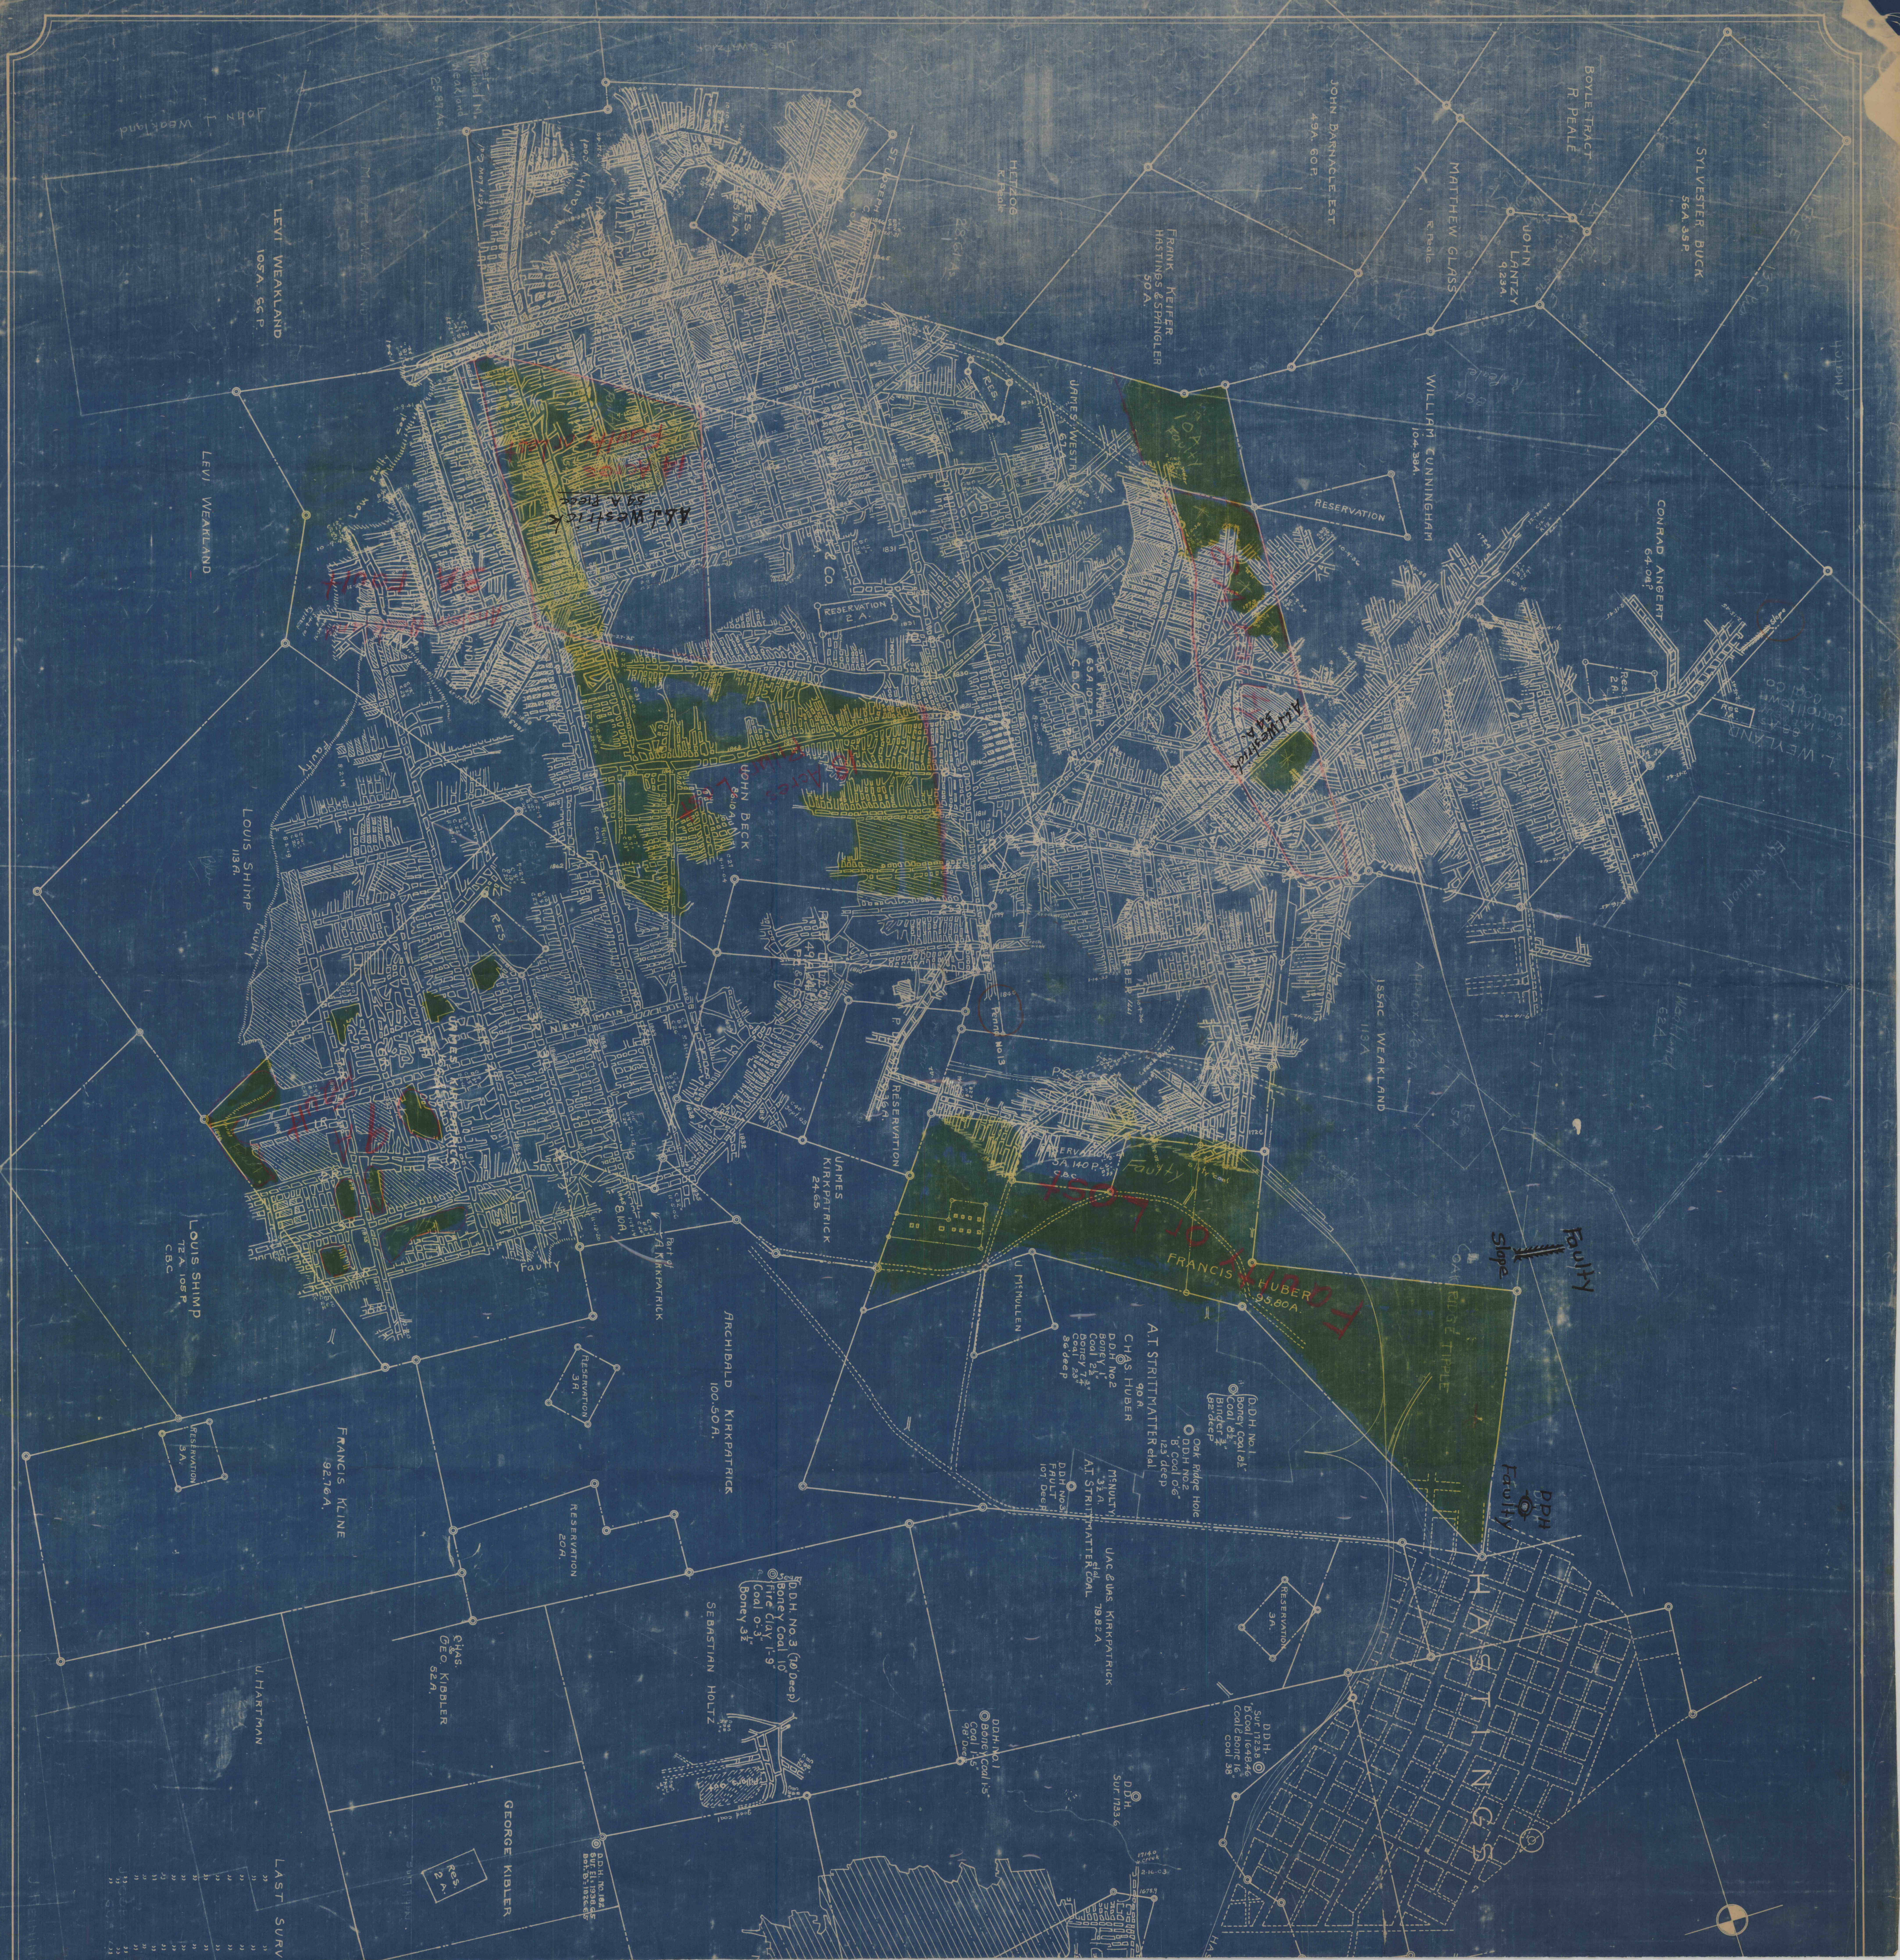
John J. Weakland
Part of Michael M. Weakland 25.87 As.
Levi Weakland 105A. 56P.
Levi Weakland
Joe Swatsik
Very Low Coal
Low Faulty Coal
Low Faulty Coal
A.&J. Westrick 59 A. Piece
14 Acres Faulty or Lost
3A Fault
Reservation 2 A.
Hetzog R. Peale
John Barnacle Est 49A. 60P.
Frank Keifer Hastings & Spangler 50 A.
Matthew Glass R. Peale
John Lantzy 9.23A.
Boyle Tract R. Peale
Sylvester Buck 56A. 35P.
James Westrick 67A.
Res.
10 A. Faulty
Reservation
William Cunningham 104.38A.
Conrad Angert 64.08P.
Res. 2A.
Res. 1A.
L. Weyland 88 As. Carrolltown Coal Co.
Slope
A.&J. Westrick 54 A.
Louis Shimp 113A.
Faulty
Res.
New Main
John Beck 86.10 A.
16 Acres Faulty Lost
Louis Shimp 72A. 105P. C.B.C.
Faulty
Part of A. Kirkpatrick
James Kirkpatrick 24.65
Reservation 36A.
Penna No 13
Isaac Weakland 113A
I. Weakland 62A.
Reservation 5A. 140P. C.B.C.
Faulty
Faulty or Lost
Francis X. Huber 95.80A.
Faulty Slope
Oak Ridge Tipple
U. McMullen
Archibald Kirkpatrick 100.50A.
Reservation 3A.
Reservation 3A.
Francis Kline 92.76A.
Reservation 20A.
A.T. Strittmatter 90 A.
Chas. Huber
D.D.H. No 2 Boney 1" Coal 2½" Boney 7¾" Coal 23" 86' deep
D.D.H. No. 1 Boney Coal 8½" Coal 8½" Binder ¾" 82' deep
Oak Ridge Hole D.D.H. No. 2 "B" Coal 0'6" 123' deep
D.D.H. No. 3 Fault 107' Deep
A.T. Strittmatter et al.
McNulty 3½ A.
J.A.C. & Jas. Kirkpatrick et al. 79.82 A.
A.T. Strittmatter Coal
DDH Faulty
Reservation 3A.
D.D.H. No. 3 (10' Deep) Boney Coal 10" Fire Clay 1'-9" Coal 0'-3" Boney 3½"
Sebastian Holtz
Chas. & Geo. Kibbler 52A.
J. Hartman
George Kibler
Res. 2A.
Last Surv
D.D.H. No. 1&2 Sur. El. 1938.65 Bot. "B" 1826.65
D.D.H. No. 1 Boney Coal 1'5" Coal 1'5" 98' Deep
D.D.H. Sur. 1723.8 "B" Coal 1648.46 Coal & Bone 16" Coal 38"
D.D.H. Sur. 1733.6
Hastings