


MAP OF  
 COAL LANDS  
 IN  
 ELDER TOWNSHIP CAMBRIA CO. PA.  
 SHOWING C AND D SEAMS  
 OWNED BY  
 THE BLUBAKER COAL COMPANY

SCALE 1"=400'  
 COLTET SCHEME  
 LEASED TO PENN. COAL & CONE CO. BY  
 " LAMARK COAL CO. BY  
 " EUBANK COAL CO. BY  
 " FRANK SWAN BY  
 " CHAS. HETZEL BY

LAST SURVEY MADE

DATE	SURVEYOR
AUG. 1913	SIMMONS
NOV. 1920	"
NOV. 1922	"
DEC. 1923	"
DEC. 1927	"
DEC. 1928	"
NOV. 1930	"
NOV. 1933	"

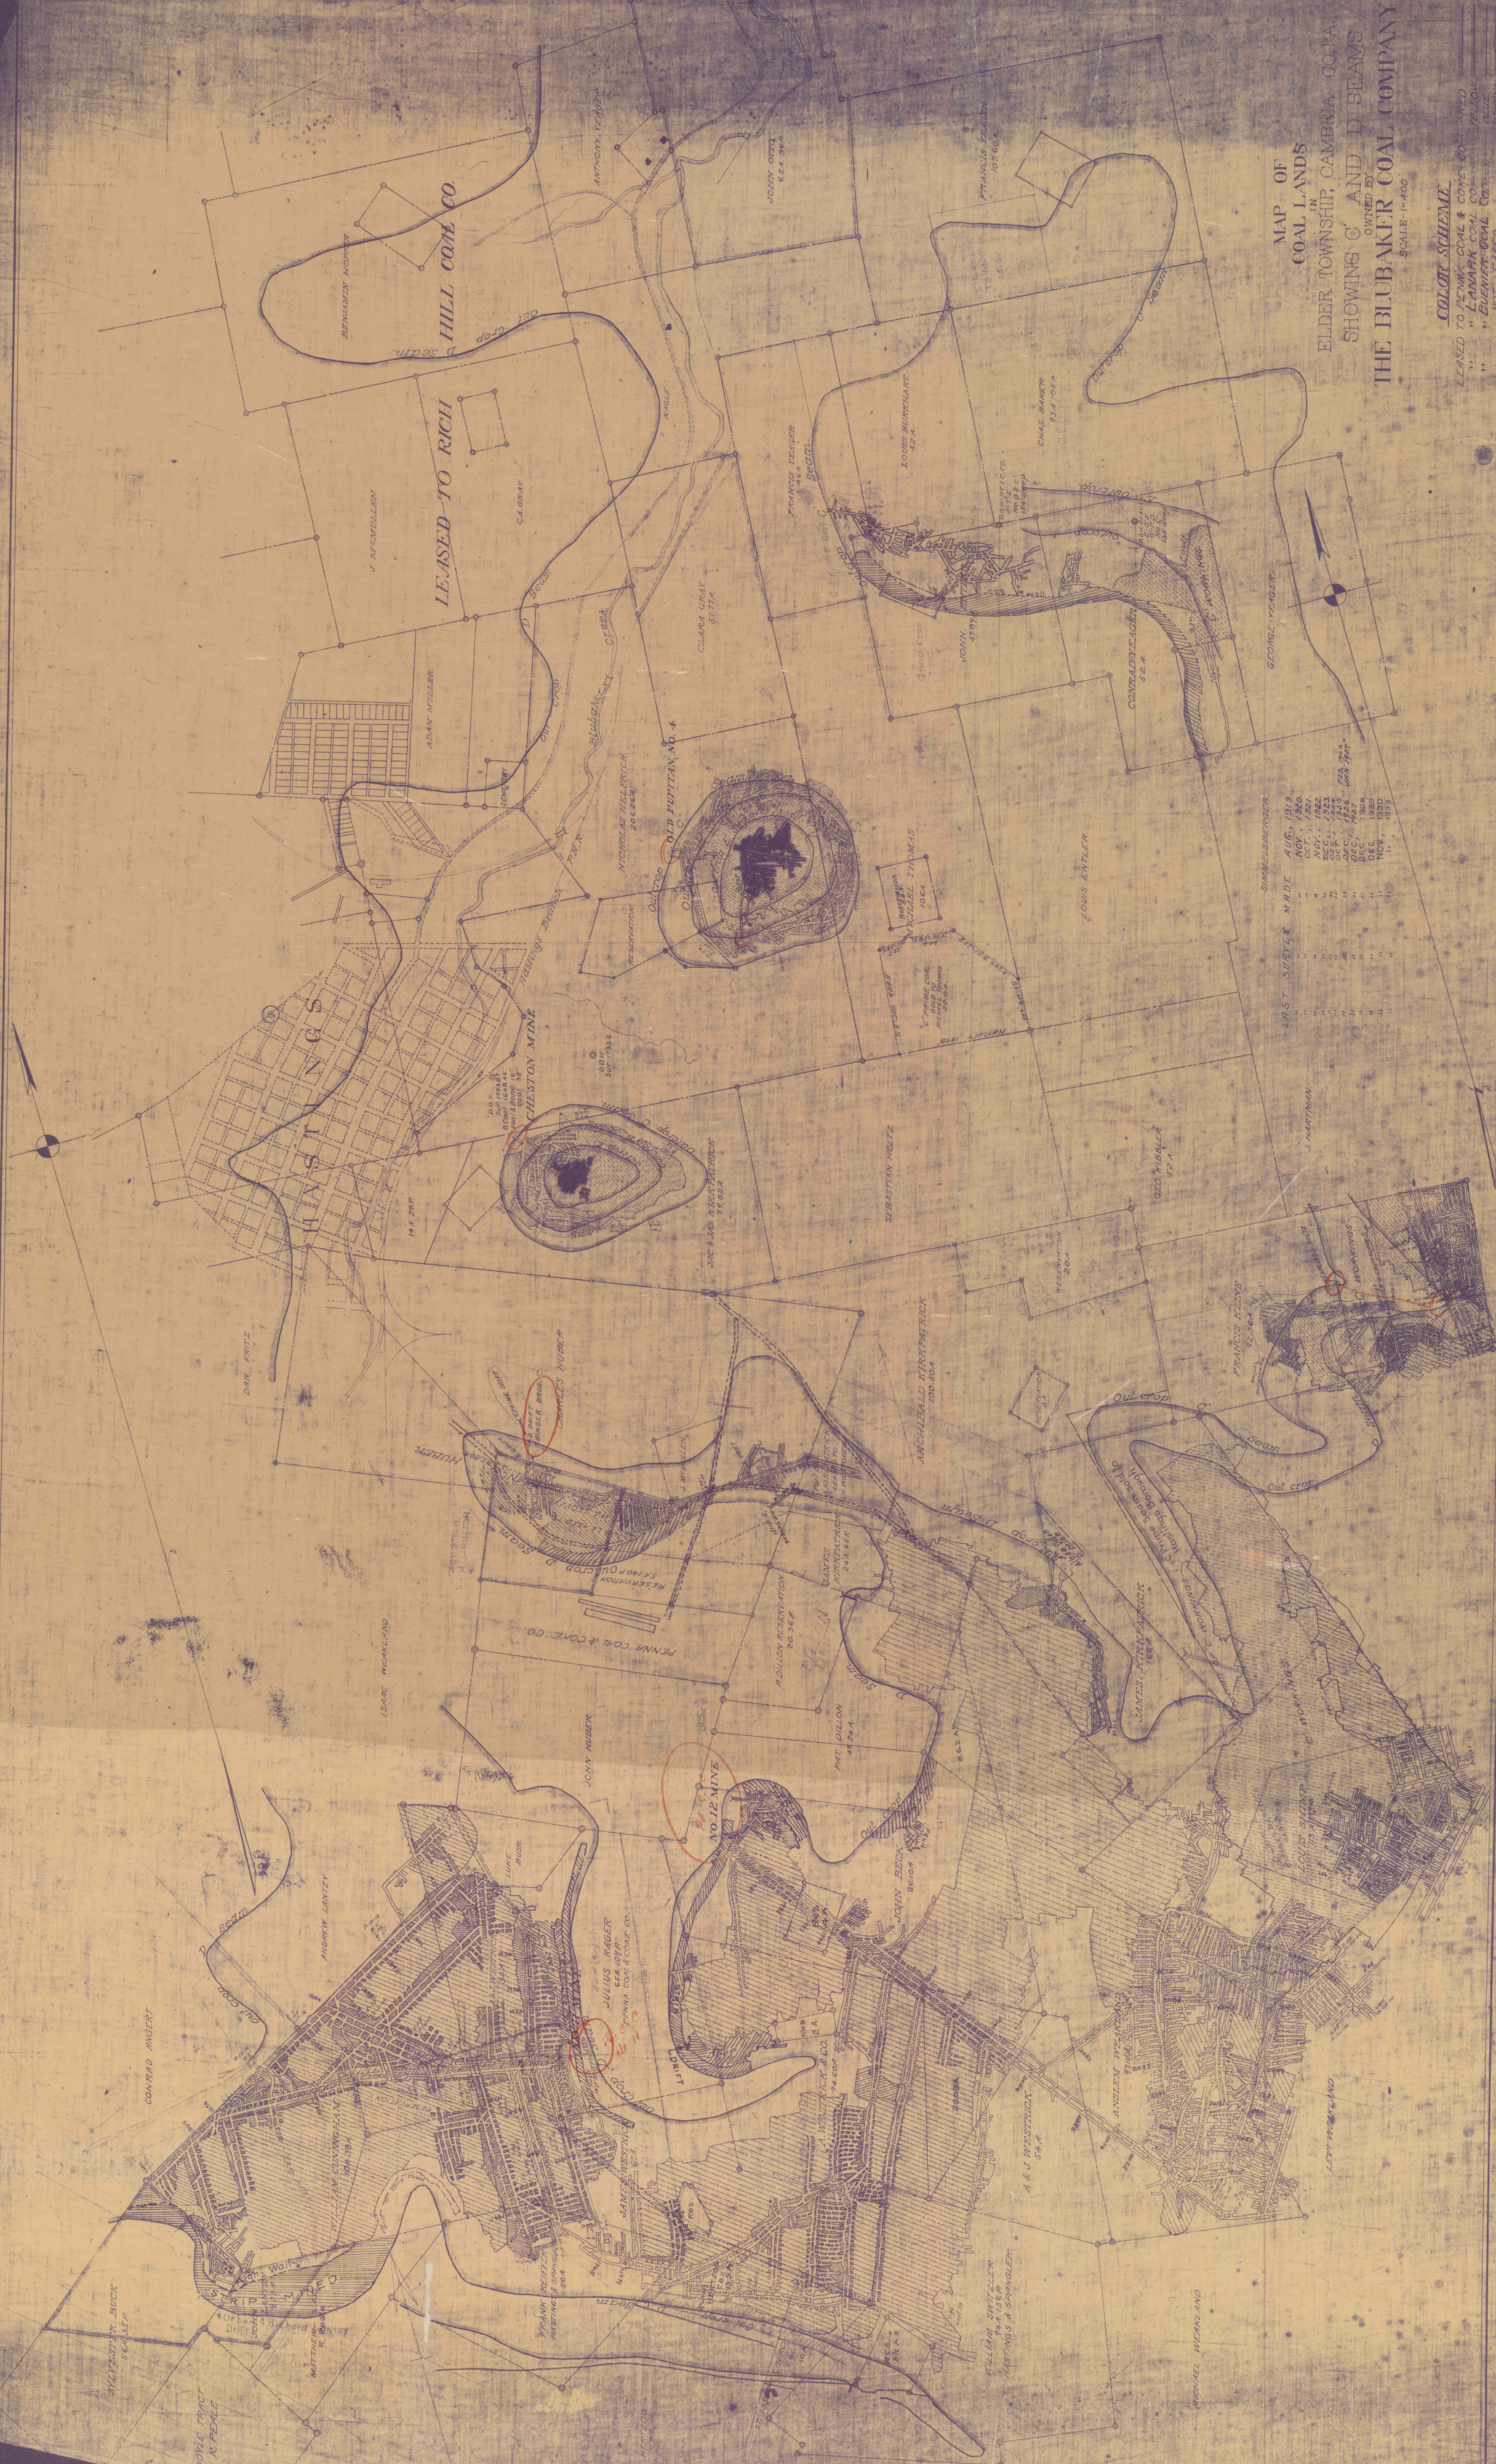

LEASED TO RICH  
 HILL COAL CO






















