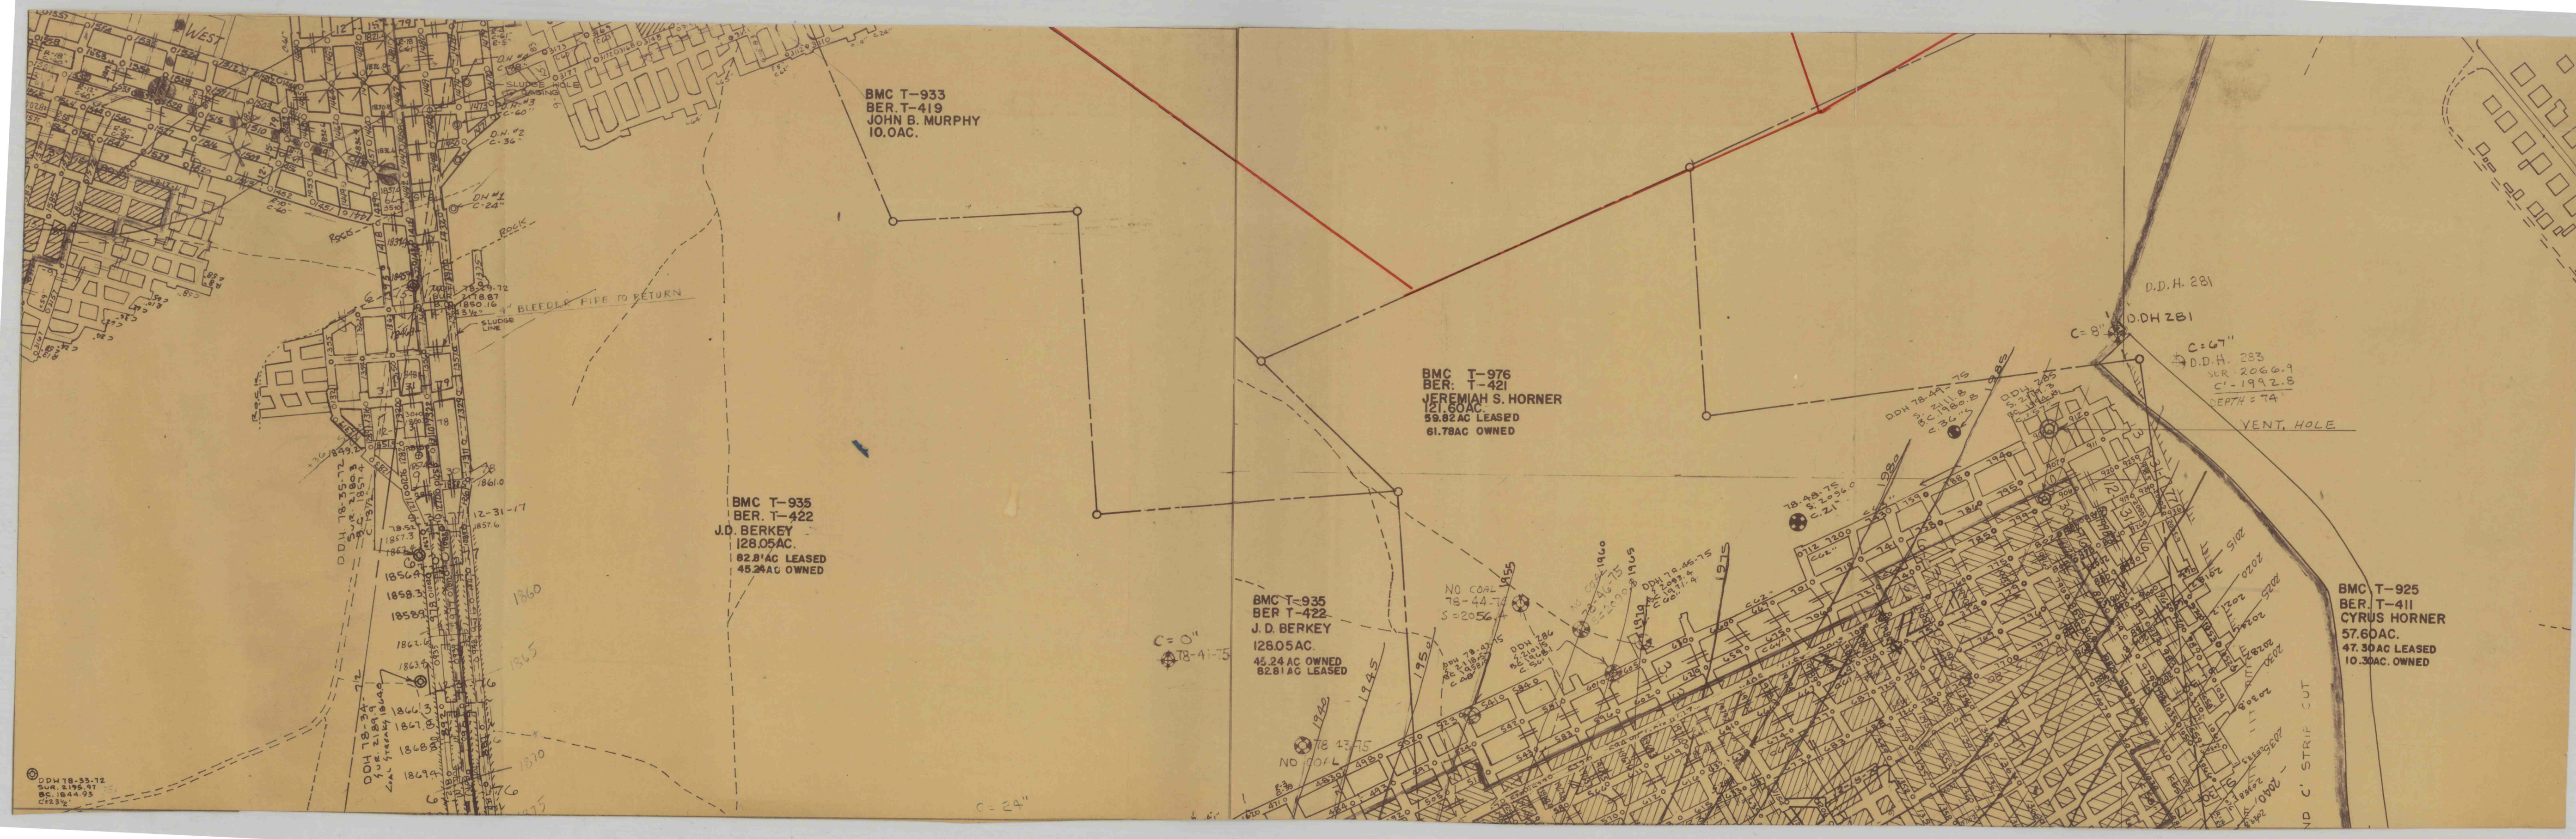
WEST
BMC T-933
BER. T-419
JOHN B. MURPHY
10.0AC.
BMC T-935
BER. T-422
J.D. BERKEY
128.05AC.
82.81AC LEASED
45.24AC OWNED
BMC T-976
BER: T-421
JEREMIAH S. HORNER
121.60AC.
59.82AC LEASED
61.78AC OWNED
BMC T-935
BER T-422.
J. D. BERKEY
128.05AC.
45.24 AC OWNED
82.81AC LEASED
BMC T-925
BER. T-411
CYRUS HORNER
57.60AC.
47.30AC LEASED
10.30AC. OWNED
BLEEDER PIPE TO RETURN
SLUDGE LINE
VENT. HOLE
D.D.H. 281
D.D.H. 283
ROCK
C=24"
C=0"
C=8"
C=6"
NO COAL
NO COAL
NO COAL
DDH 78-33-72
SUR. 2196.9T
BC. 1844.93
C=23.0'
DDH 78-35-72
SUR. 2196.9T
BC. 1844.93
C=23.0'
DDH 78-44-75
S=2056.0
C=21.0'
DDH 78-44-75
S=2066.9
C=19.8'
D.D.H. 283
N.R. 2066.9
C'-1992.8
DEPTH = 94'
1860
1865
1870
1875
1880
1885
1890
1895
1900
1905
1910
1915
1920
1925
1930
1935
1940
1945
1950
1955
1960
1965
1970
1975
1980
1985
1990
1995
2000
2005
2010
2015
2020
2025
2030
2035
2040
2045
2050
2055