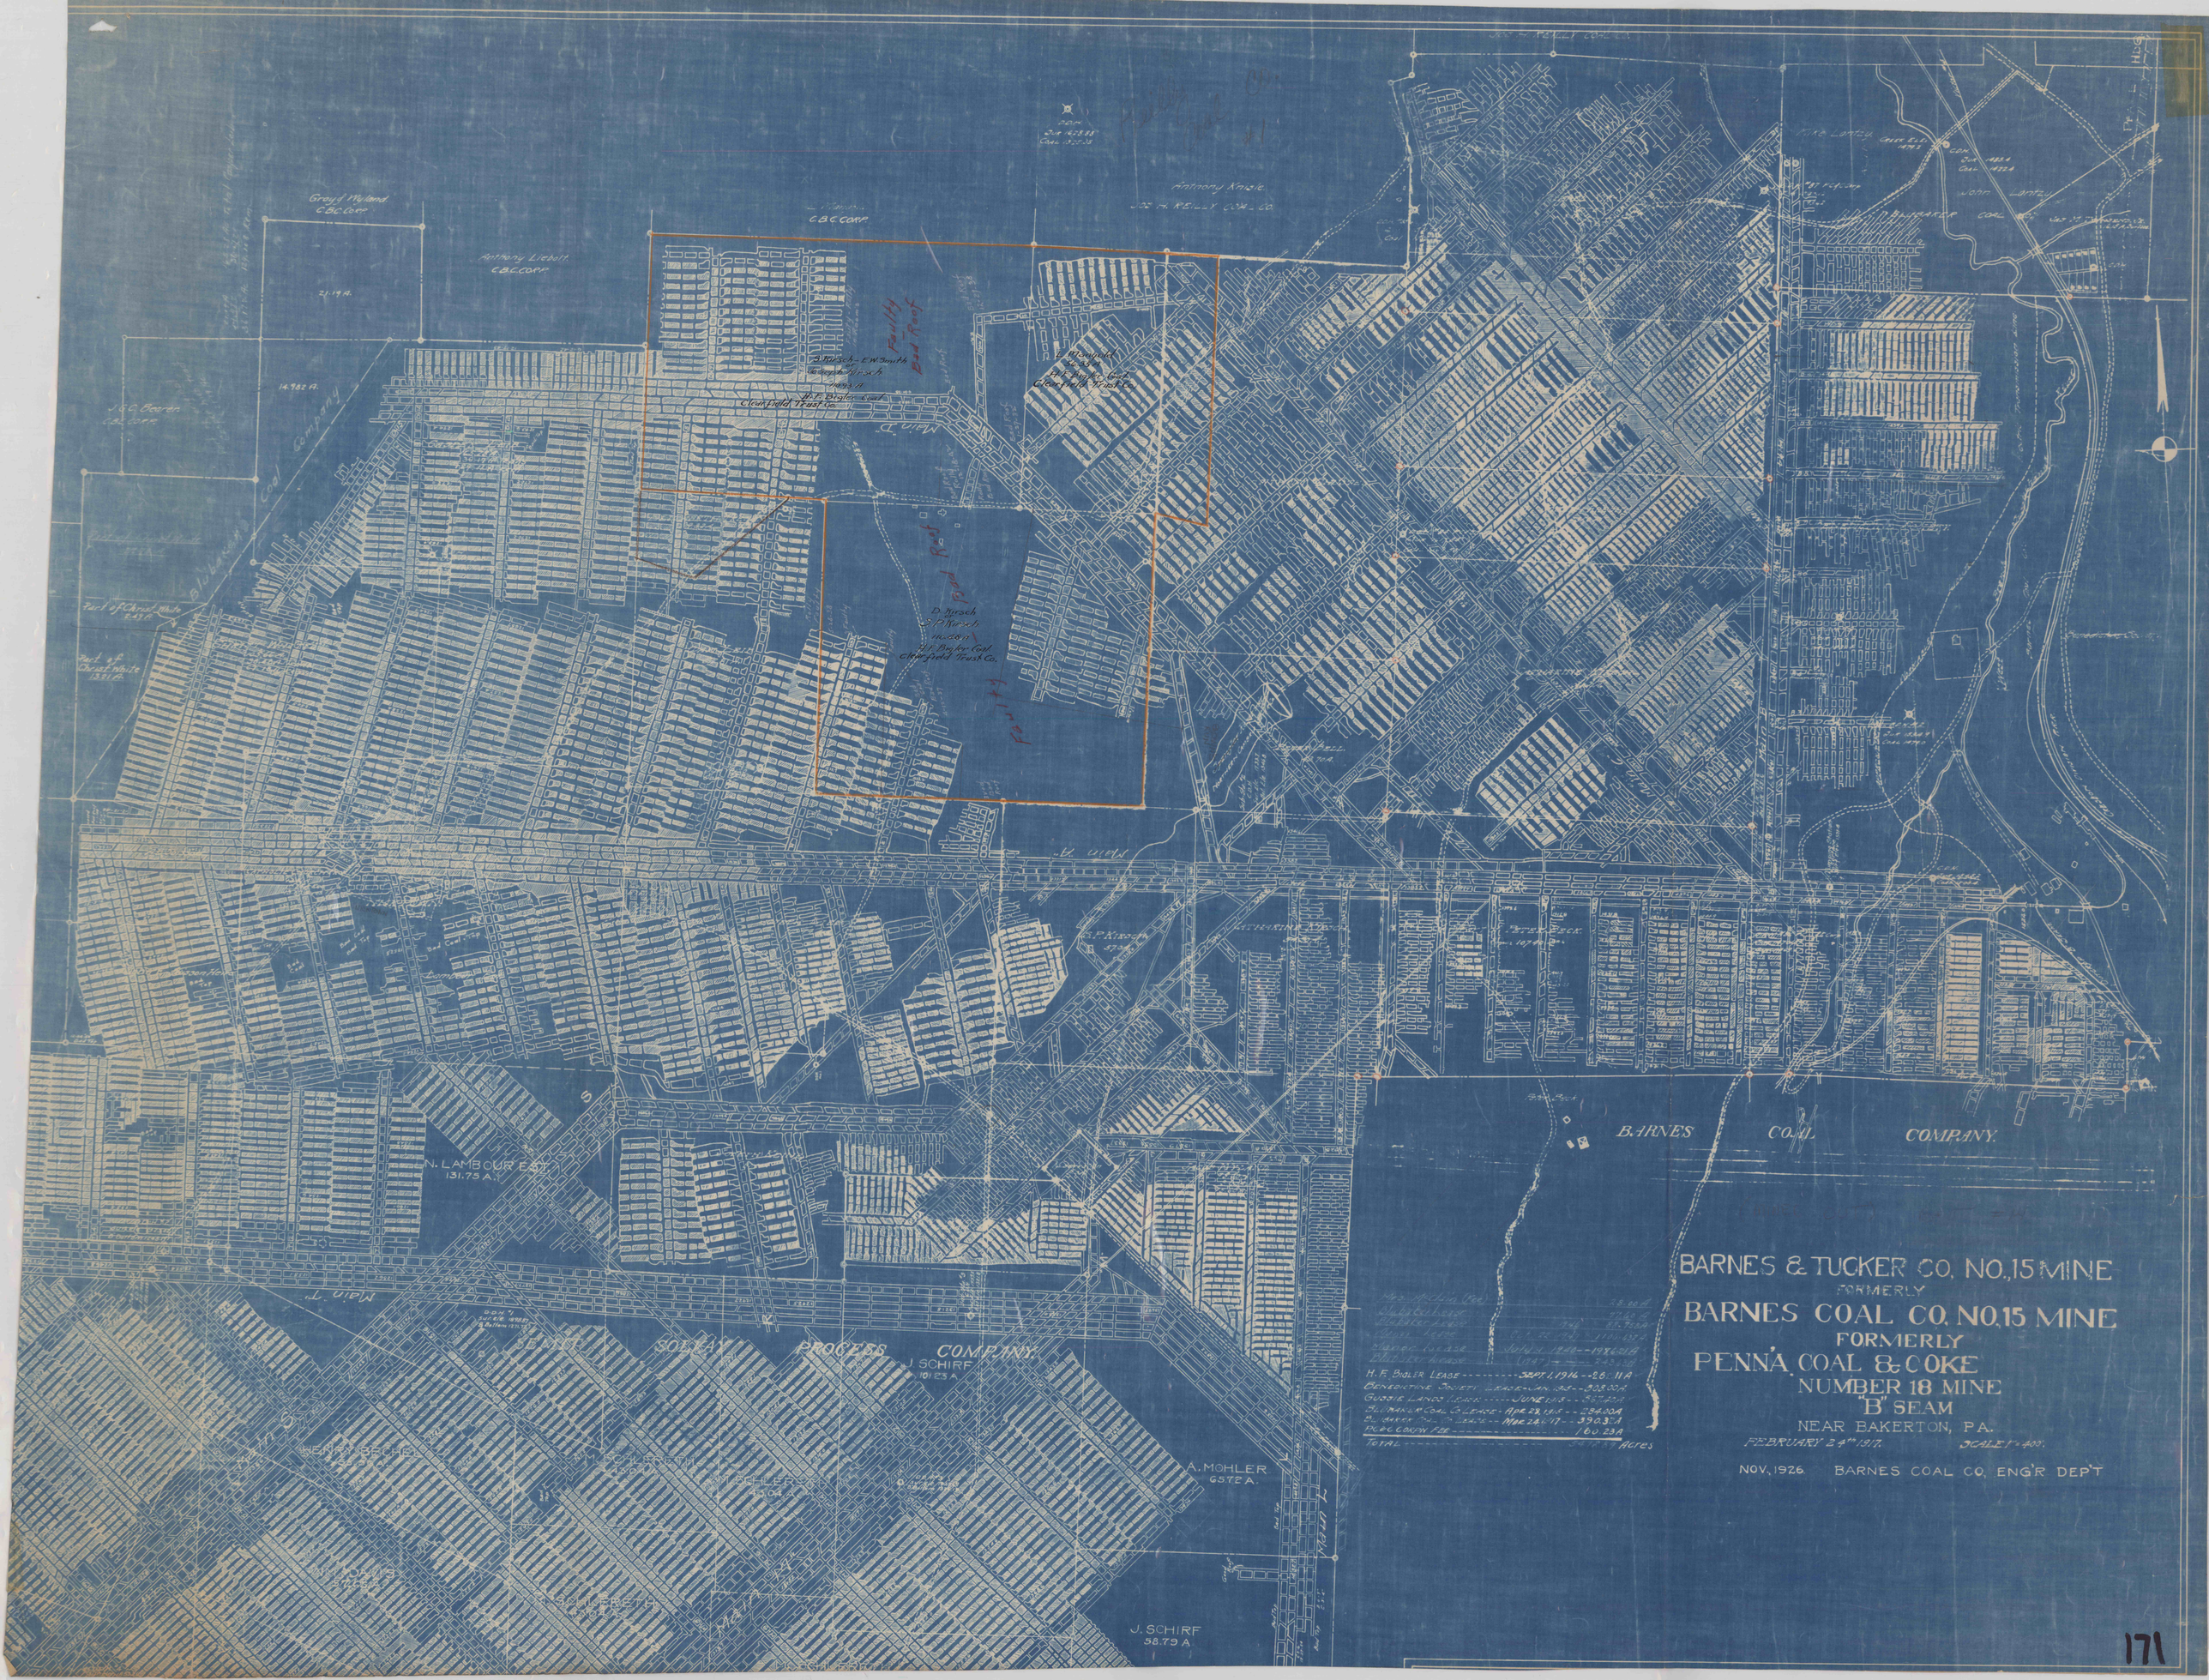
BARNES & TUCKER CO. NO. 15 MINE
FORMERLY
BARNES COAL CO. NO. 15 MINE
FORMERLY
PENNA. COAL & COKE
NUMBER 18 MINE
"B" SEAM
NEAR BAKERTON, PA.
FEBRUARY 24th 1917.
SCALE 1" = 400'.
NOV. 1926.
BARNES COAL CO. ENG'R DEP'T
BARNES COAL COMPANY
SOLVAY PROCESS COMPANY
N. LAMBOUR EST.
131.75 A.
J. SCHIRF
101.23 A.
A. MOHLER
65.72 A.
J. SCHIRF
58.79 A.
Main T.
Fault Bad Roof
Anthony Knisle
JOE H. REILLY COAL CO.
Anthony Liebolt
C.B.C. CORP.
Gray & Wyland
C.B.C. CORP.
J.G.C. Bearer
C.B.C. CORP.
Part of Christ White
Part of Christ White
Clearfield Trust Co.
H.F. Bigler Coal
Clearfield Trust Co.
D. Kirsch
S.P. Kirsch
H.F. Bigler Coal
Clearfield Trust Co.
Mike Lantzy
John Lantzy
Blubaker Coal Co.
Blubaker Coal Company
Mrs. McCain (Fee) 28.00 A.
Blubaker Lease 77.60 A.
Blubaker Lease 86.758 A.
Mayer Lease Oct. 22, 1914 1100.63 A.
Mayer Lease July 1, 1920 197.621 A.
Blubaker Lease (1947) 243.63 A.
H.F. Bigler Lease Sept. 1, 1916 262.11 A.
Benedictine Society Lease Jan. 1915 308.00 A.
Gussie Lands Lease June 1915 567.40 A.
Blubaker Coal Co. Lease Apr. 28, 1915 284.00 A.
Blubaker Coal Co. Lease Mar. 24, 1917 390.32 A.
P.C.&C. Corp. Fee 160.23 A.
Total 3418.57 Acres

171