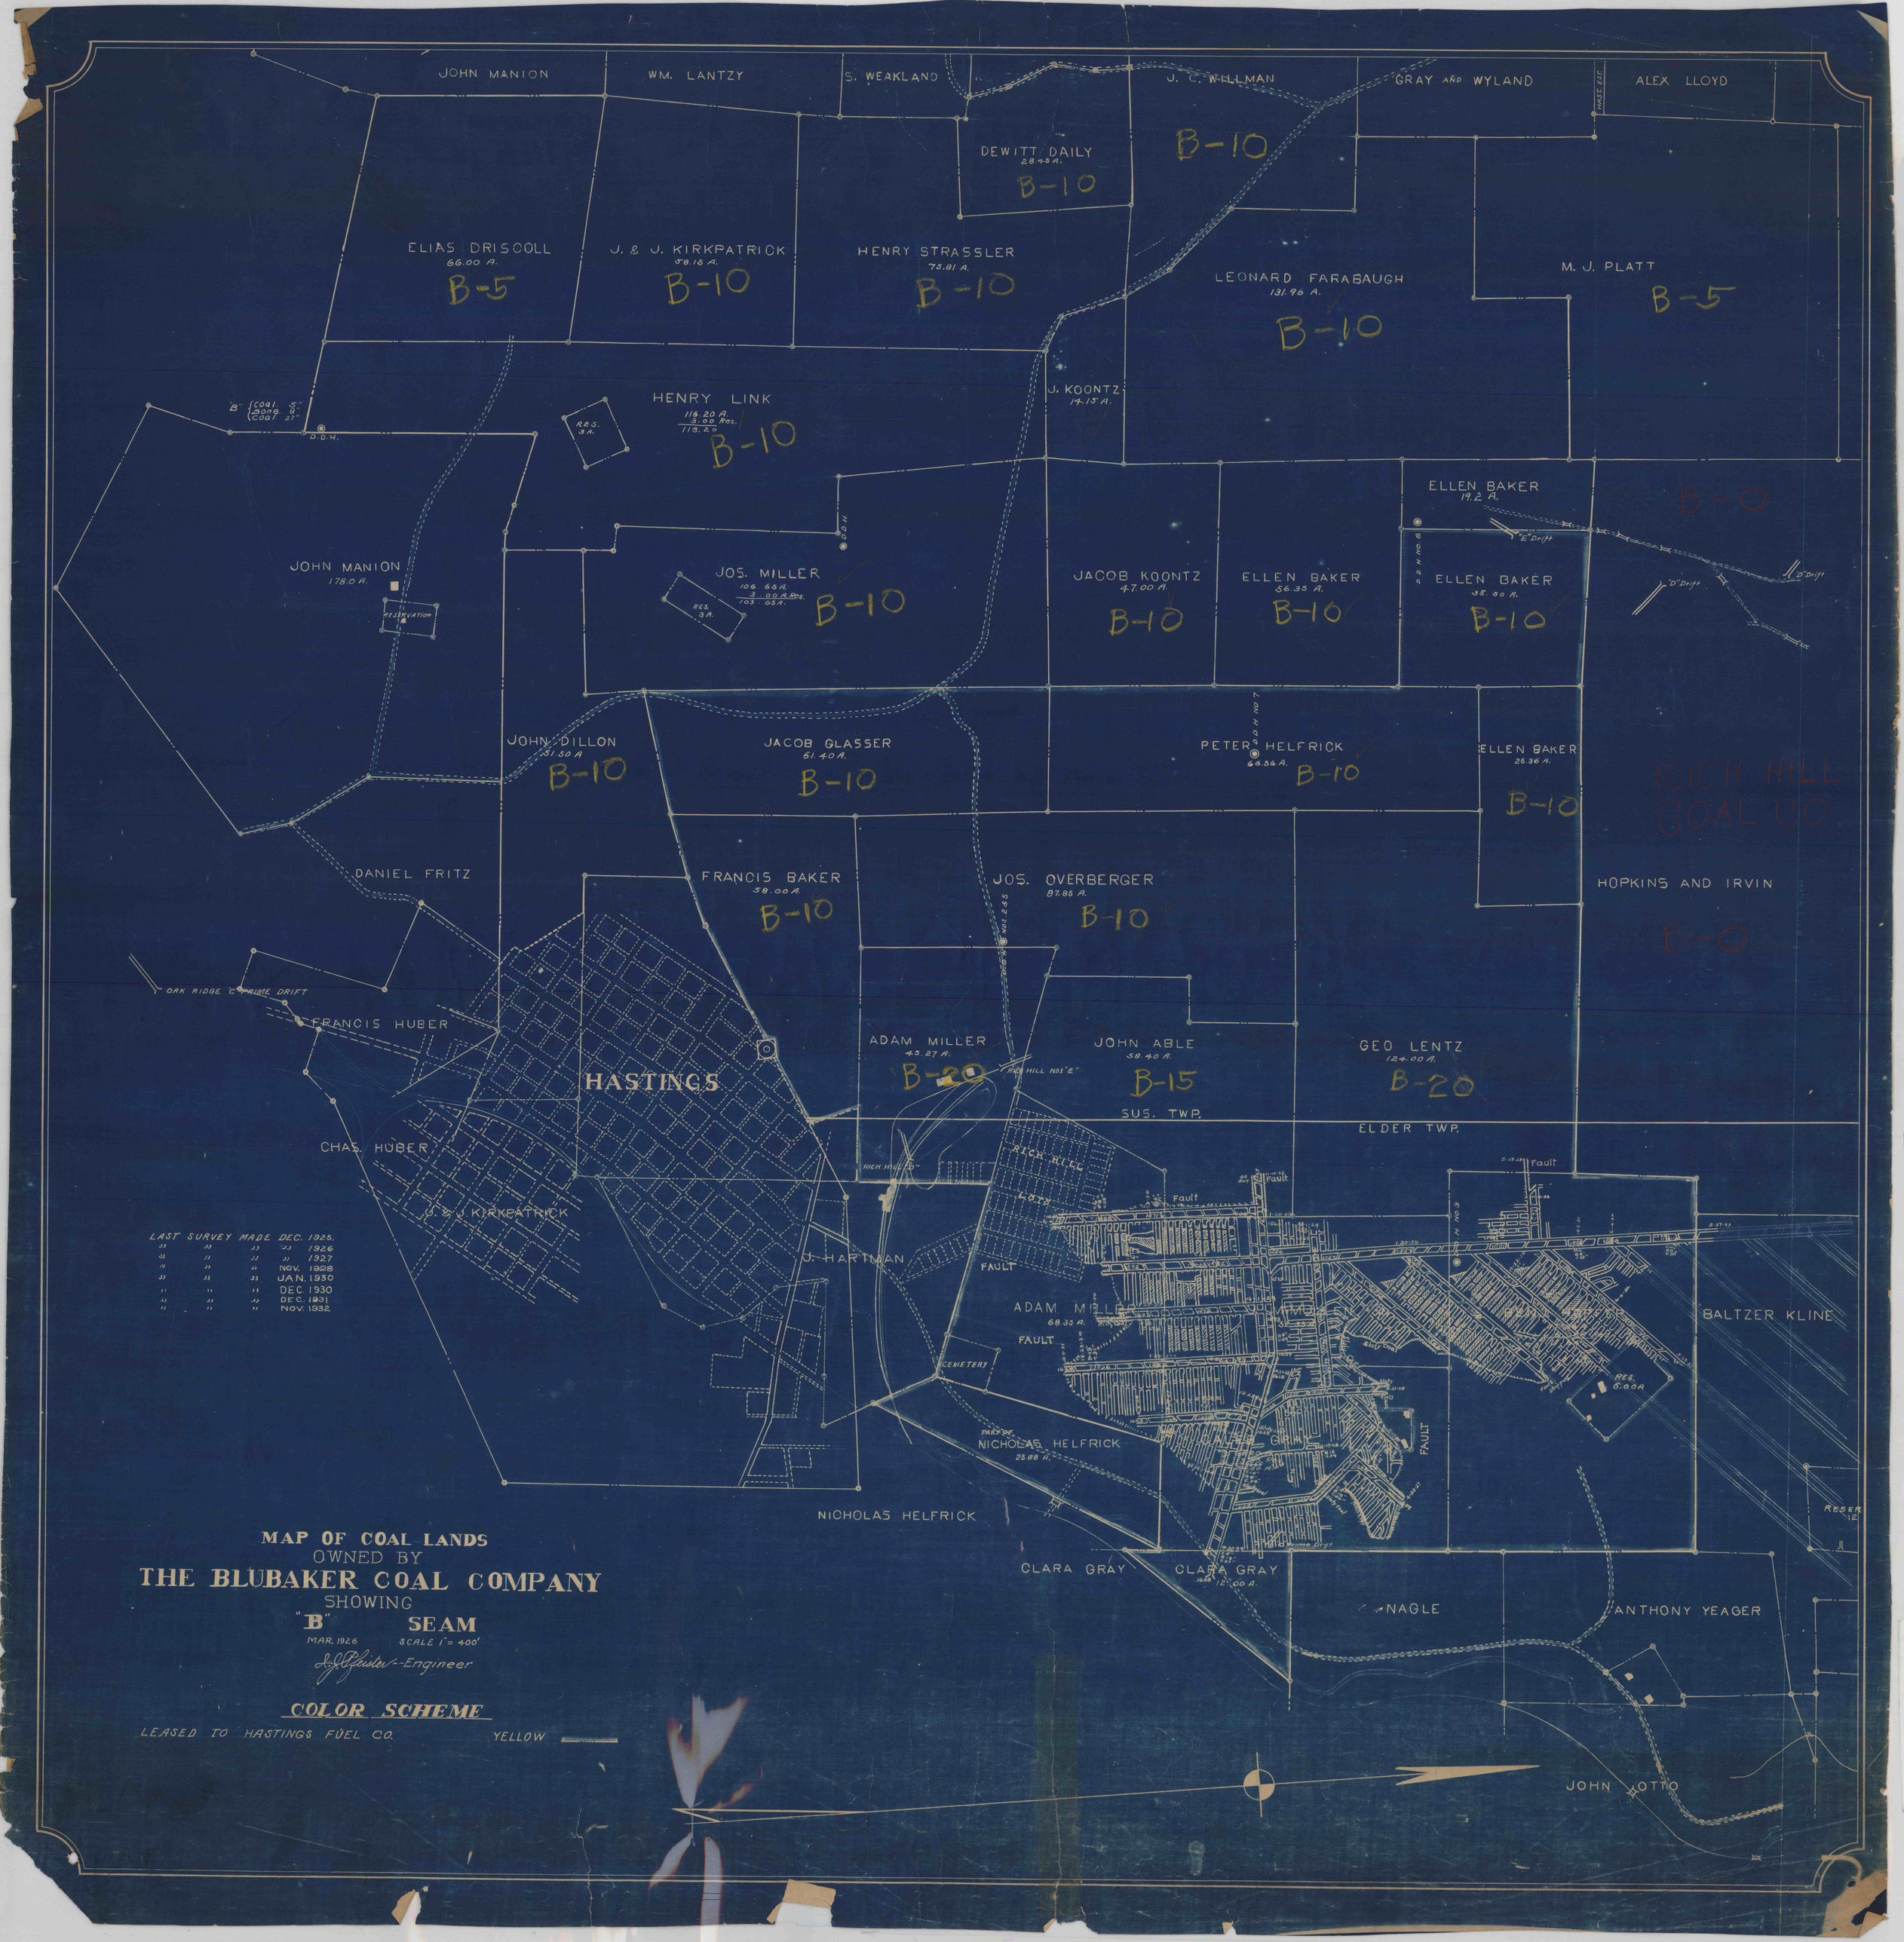
JOHN MANION
WM. LANTZY
S. WEAKLAND
J. C. WILLMAN
GRAY AND WYLAND
ALEX LLOYD
DEWITT DAILY
28.45 A.
B-10
B-10
ELIAS DRISCOLL
66.00 A.
B-5
J. & J. KIRKPATRICK
58.16 A.
B-10
HENRY STRASSLER
75.81 A.
B-10
LEONARD FARABAUGH
131.96 A.
B-10
M. J. PLATT
B-5
HENRY LINK
116.20 A.
3.00 Res.
113.20
B-10
J. KOONTZ
14.15 A.
ELLEN BAKER
19.2 A.
B-0
JOHN MANION
178.0 A.
JOS. MILLER
106.65 A.
3.00 A. Res.
103.65 A.
B-10
JACOB KOONTZ
47.00 A.
B-10
ELLEN BAKER
56.35 A.
B-10
ELLEN BAKER
35.50 A.
B-10
JOHN DILLON
51.50 A.
B-10
JACOB GLASSER
61.40 A.
B-10
PETER HELFRICK
66.56 A.
B-10
ELLEN BAKER
25.36 A.
B-10
RICH HILL COAL CO.
DANIEL FRITZ
FRANCIS BAKER
58.00 A.
B-10
JOS. OVERBERGER
87.85 A.
B-10
HOPKINS AND IRVIN
B-0
OAK RIDGE C PRIME DRIFT
FRANCIS HUBER
HASTINGS
ADAM MILLER
45.27 A.
B-20
JOHN ABLE
58.40 A.
B-15
GEO LENTZ
124.00 A.
B-20
SUS. TWP.
ELDER TWP.
CHAS. HUBER
J. & J. KIRKPATRICK
J. HARTMAN
FAULT
ADAM MILLER
68.33 A.
FAULT
CEMETERY
BALTZER KLINE
NICHOLAS HELFRICK
25.88 A.
NICHOLAS HELFRICK
CLARA GRAY
CLARA GRAY
12.00 A.
NAGLE
ANTHONY YEAGER
JOHN OTTO
LAST SURVEY MADE DEC. 1925.
" " " " 1926
" " " " 1927
" " " NOV. 1928
" " " JAN. 1930
" " " DEC. 1930
" " " DEC. 1931
" " " NOV. 1932
MAP OF COAL LANDS
OWNED BY
THE BLUBAKER COAL COMPANY
SHOWING
"B" SEAM
MAR. 1926
SCALE 1" = 400'
J. J. Pfeister--Engineer
COLOR SCHEME
LEASED TO HASTINGS FUEL CO.
YELLOW