


12 IN. 3350 34 1/2

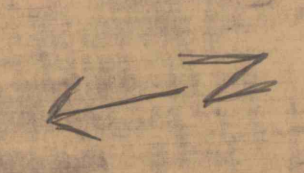

TAYLOR & McCOY COAL & COKE CO.

AM H. SECHLER

JOSEPHINE R. WEISE

JAMES BOLAND ESTATE

JAMES BOLAND ESTATE

VINCENT P. (VA) SANKER

LEMON & BAILEY

WILLIAM McDERMITT ESTATE

ANDERSON

295

THOMAS L. PARRISH

SUSAN GALLAGHER & DR. T. S. TROXELL

CONRAD WENDEROTH

WILLIAM LILLY

PENNSYLVANIA COAL AND COKE CORPORATION
CRESSON NO 98 COLLIERY
CRESSON, CAMBRIA CO., PENNSYLVANIA

SCALE 1"=400'