

CAMBRIA

MINING AND MANUFACTURING CO.

SONMAN SHAFT COAL CO.

962 ACRES
LEASED TO

ARMT SONMAN

PORTAGE TOWNSHIP

ROBERT FLYNN
PORTAGE TOWNSHIP

ROBERT FLYNN
PORTAGE BOROUGH

CAMBRIA COUNTY COAL CO.



PORTAGE TOWNSHIP AND PORTAGE BOROUGH.

MAP TO ACCOMPANY AFFIDAVIT OF
W. A. SILLIMAN
REGARDING PROVEN AREAS OF FAULTED COAL
ON LANDS OF
CAMBRIA MINING AND MANUFACTURING CO.
FEBRUARY 1st, 1927.

LEASEHOLDS AND OWNERSHIPS
OF THE
SONMAN SHAFT COAL CO.
IN THE
"B" OR LOWER KITTANNING SEAM,
PORTAGE AND SUMMERHILL TOWNSHIPS, CAMBRIA COUNTY, PA.
SCALE: 1" = 400'

WORKINGS SHOWN TO Dec 1st 1926

W. A. SILLIMAN,
ENGINEER,
ALTOONA, PA.

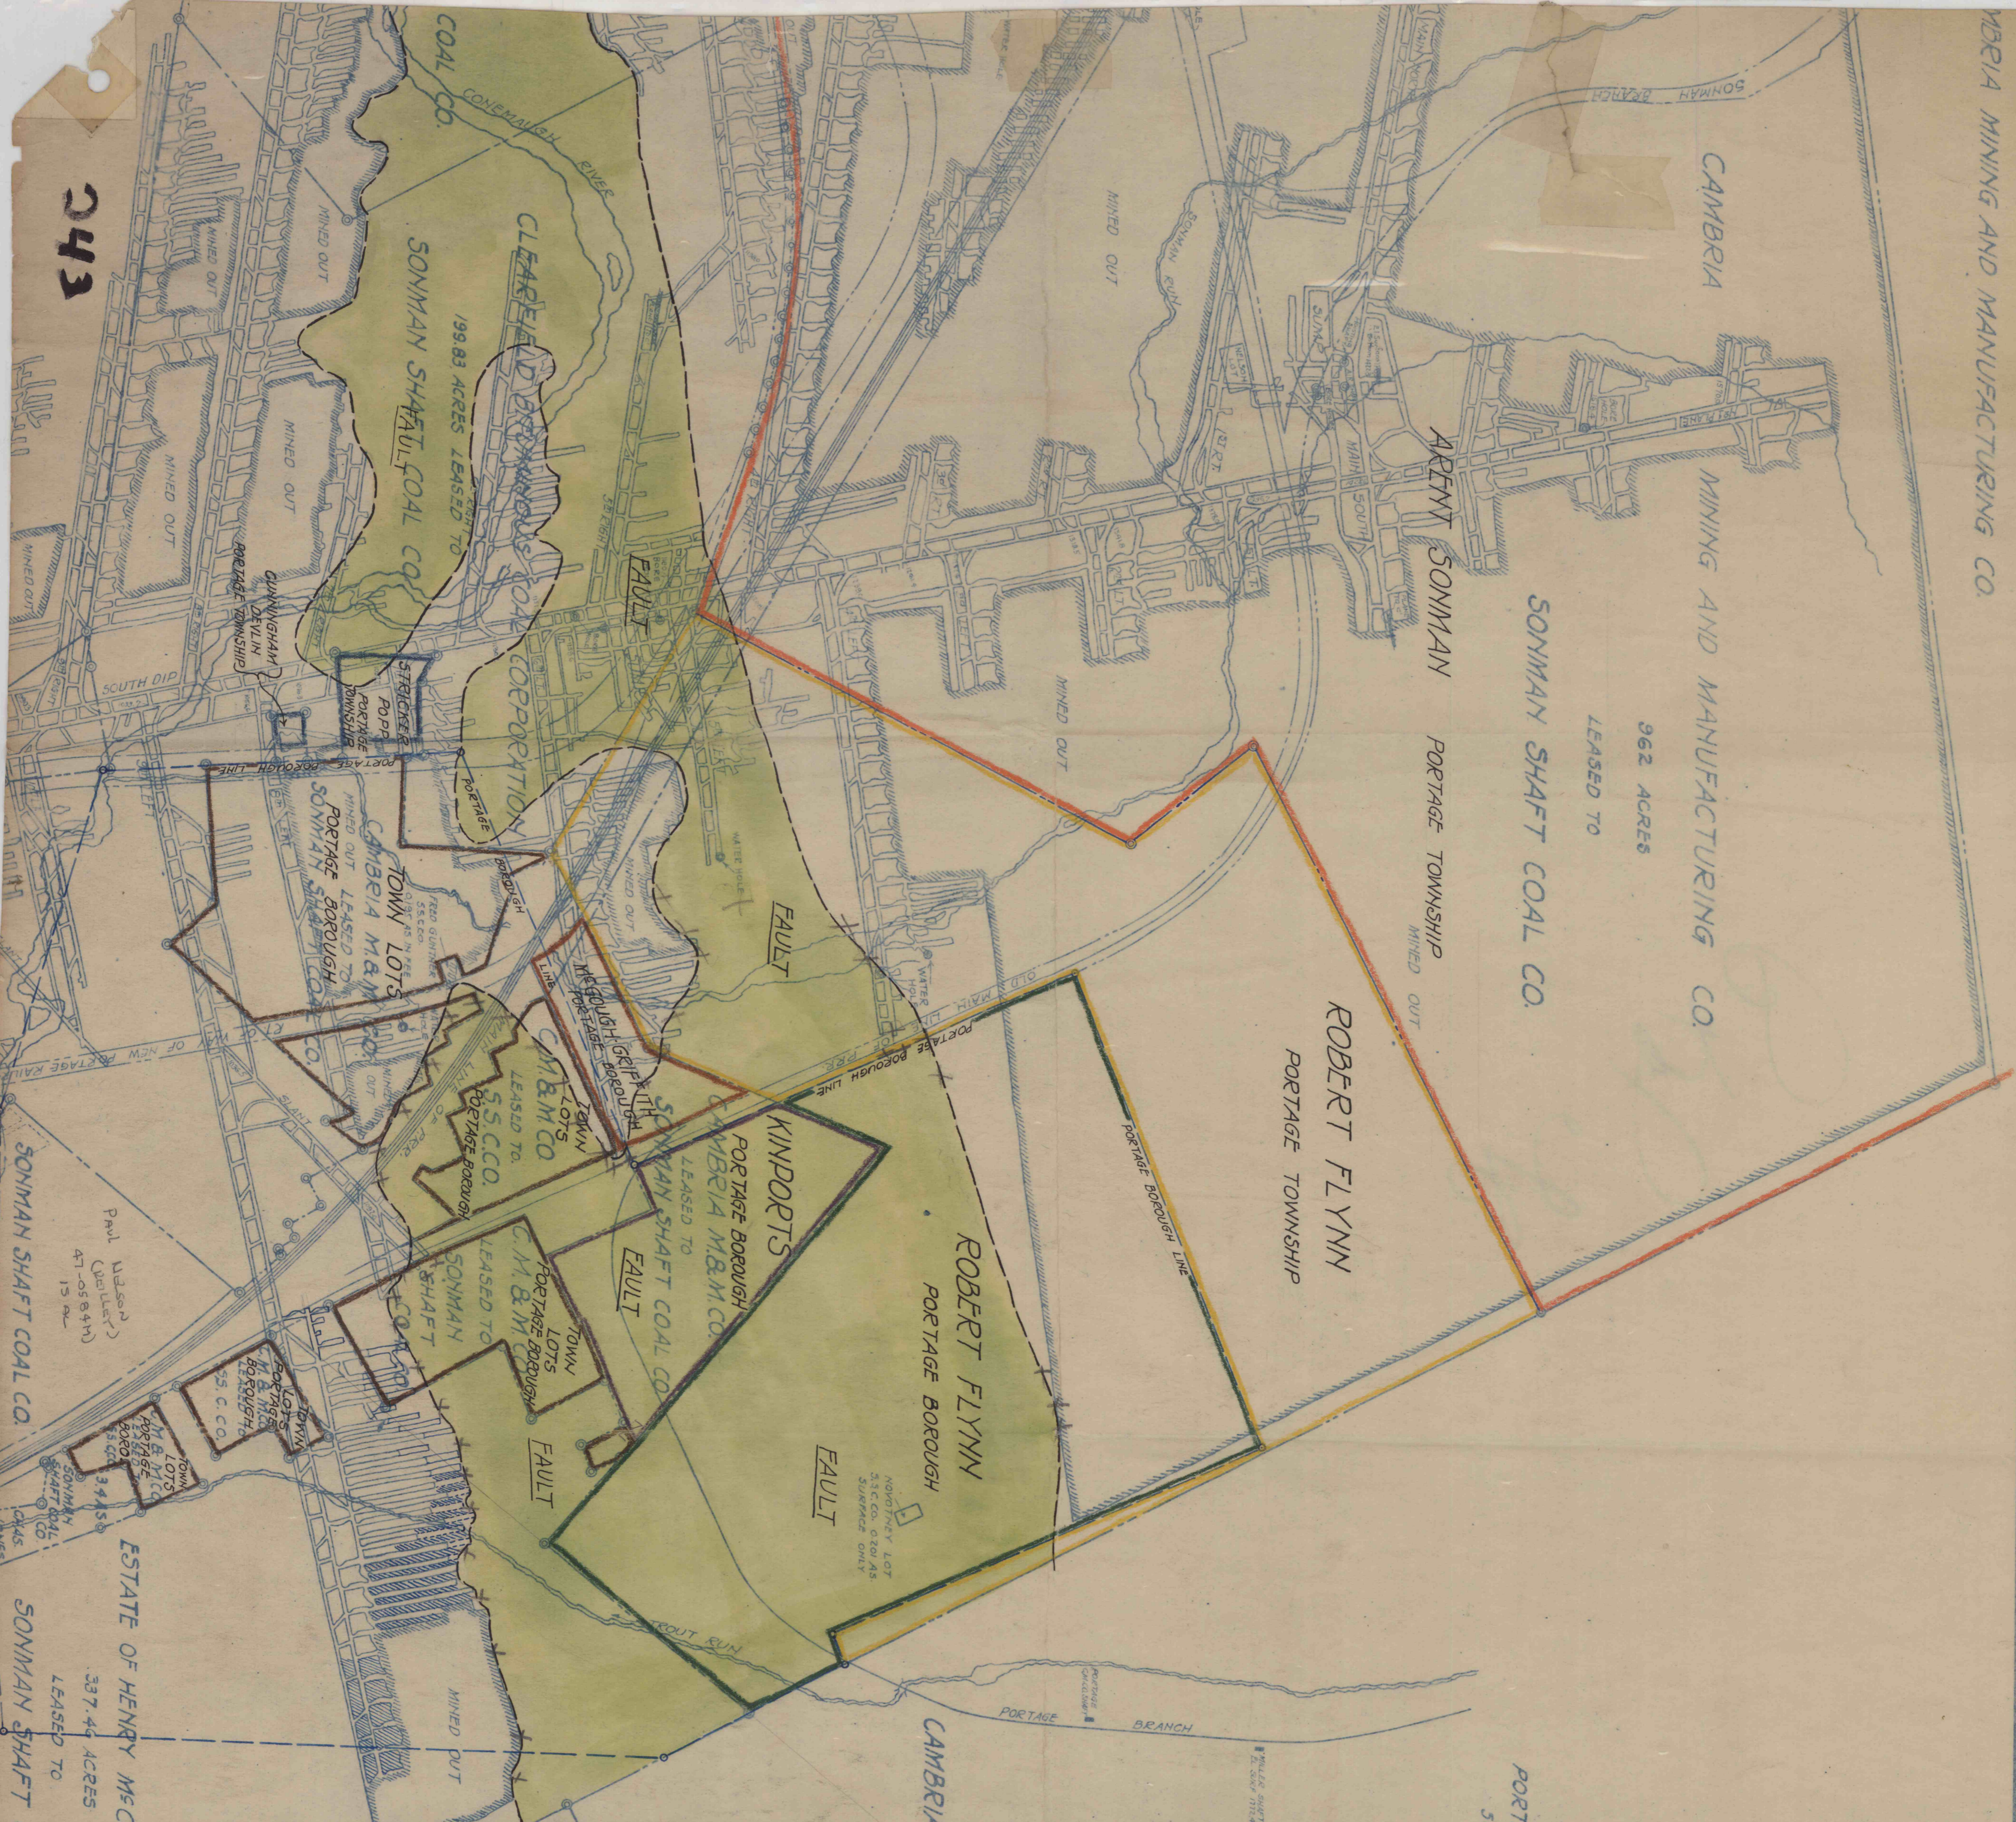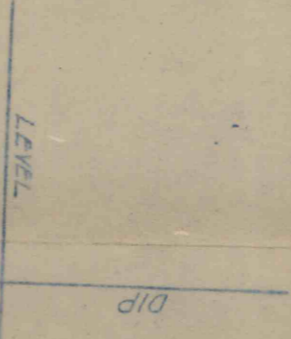

243

ESTATE OF HENRY Mc CORMICK

ESTATE OF HENRY Mc CORMICK
337.46 ACRES
LEASED TO
SONMAN SHAFT COAL CO.

SONMAN SHAFT COAL CO.

SONMAN SHAFT COAL CO.

SONMAN SHAFT COAL CO.

SONMAN SHAFT COAL CO.