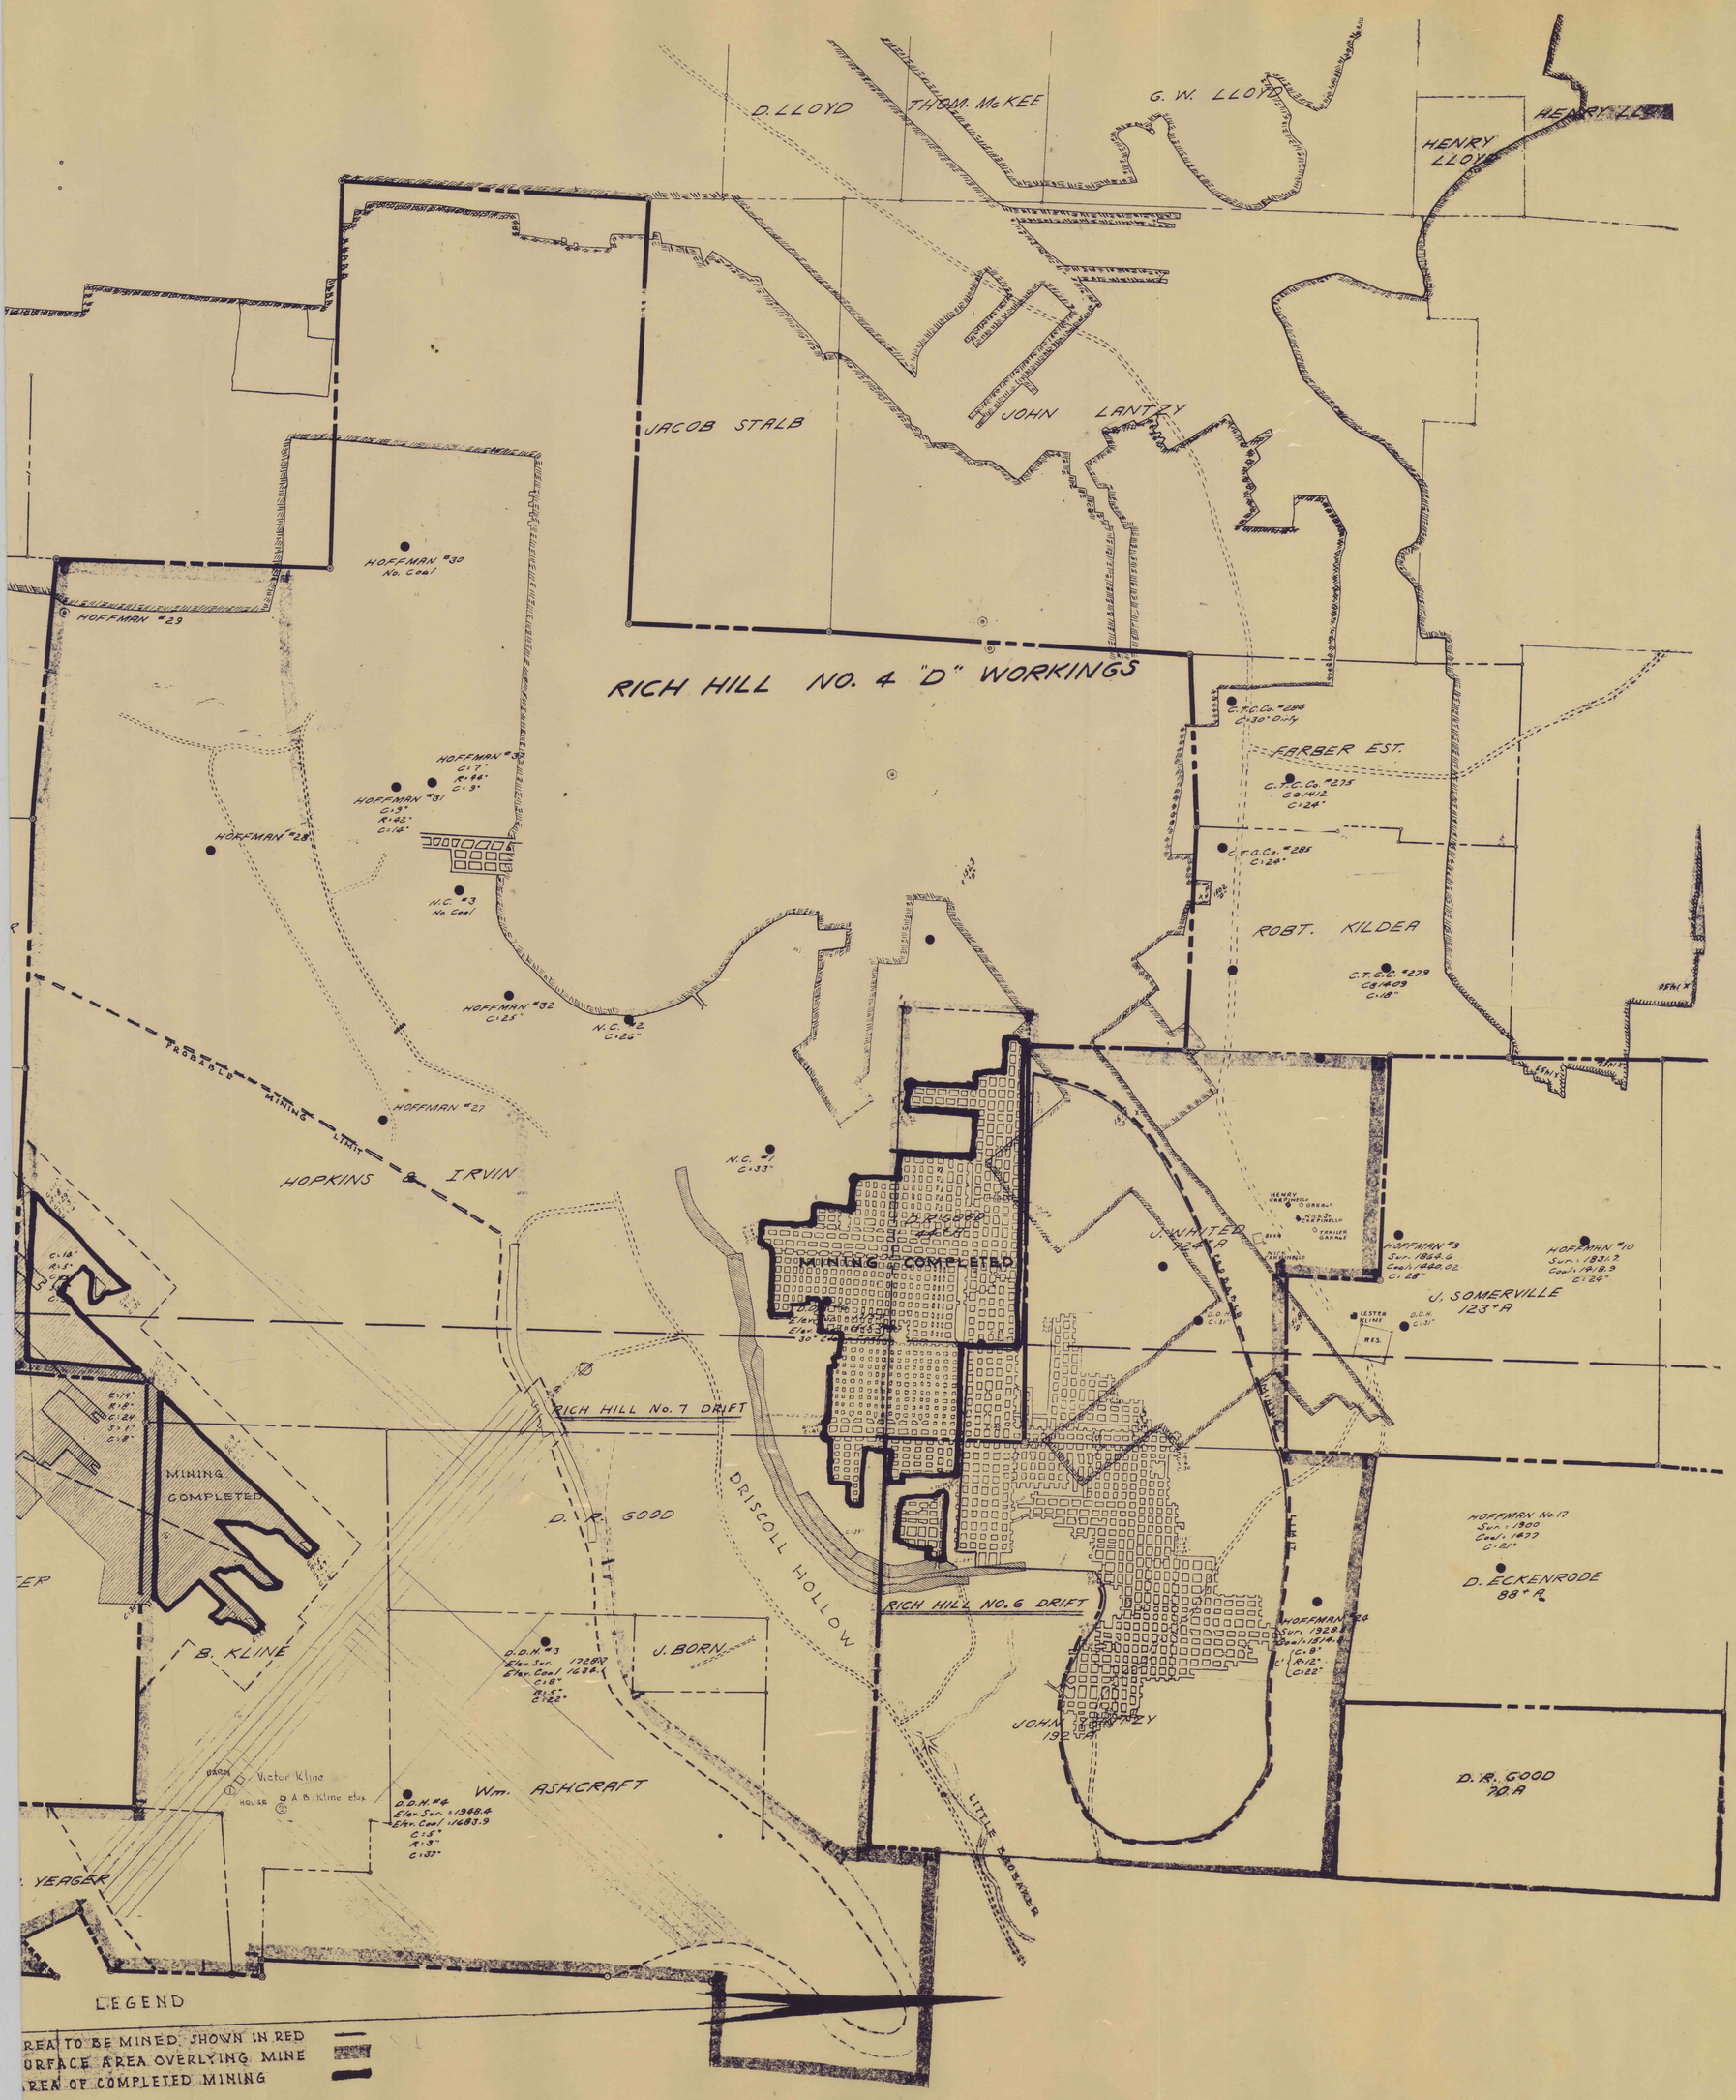

D. LLOYD
THOM. McKEE
G. W. LLOYD
HENRY LLOYD
JACOB STALB
JOHN LANTZY
HOFFMAN #30
No. Coal
HOFFMAN #29
RICH HILL NO. 4 "D" WORKINGS
C.T.C.Co. #284
C:30" Dirty
FARBER EST.
C.T.C.Co. #275
C:24"
HOFFMAN #31
HOFFMAN #28
C.T.C.Co. #285
C:24"
N.C. #3
No Coal
ROBT. KILDEA
C.T.C.C. #279
C:18"
HOFFMAN #32
C:25"
N.C. #2
C:26"
PROBABLE MINING LIMIT
HOFFMAN #27
HOPKINS & IRVIN
N.C. #1
C:33"
MINING COMPLETED
J. WHITED
HOFFMAN #9
Sur. 1864.6
Coal 1440.02
C:28"
HOFFMAN #10
Sur. 1831.7
Coal 1418.9
C:24"
J. SOMERVILLE
123+A
RICH HILL No. 7 DRIFT
MINING COMPLETED
D. R. GOOD
DRISCOLL HOLLOW
HOFFMAN No. 17
Sur. 1900
Coal 1477
C:21"
D. ECKENRODE
88+A
RICH HILL NO. 6 DRIFT
HOFFMAN #24
B. KLINE
J. BORN
D.D.H. #3
Elev. Sur. 1728.7
Elev. Coal 1634.1
C:8"
R:5"
C:22"
JOHN LANTZY
192+A
D. R. GOOD
70 A
Victor Kline
A. B. Kline etux
Wm. ASHCRAFT
D.D.H. #4
Elev. Sur. 1948.4
Elev. Coal 1683.9
C:5"
R:3"
C:37"
LITTLE BROBAKER
YEAGER
LEGEND
REA TO BE MINED SHOWN IN RED
URFACE AREA OVERLYING MINE
REA OF COMPLETED MINING