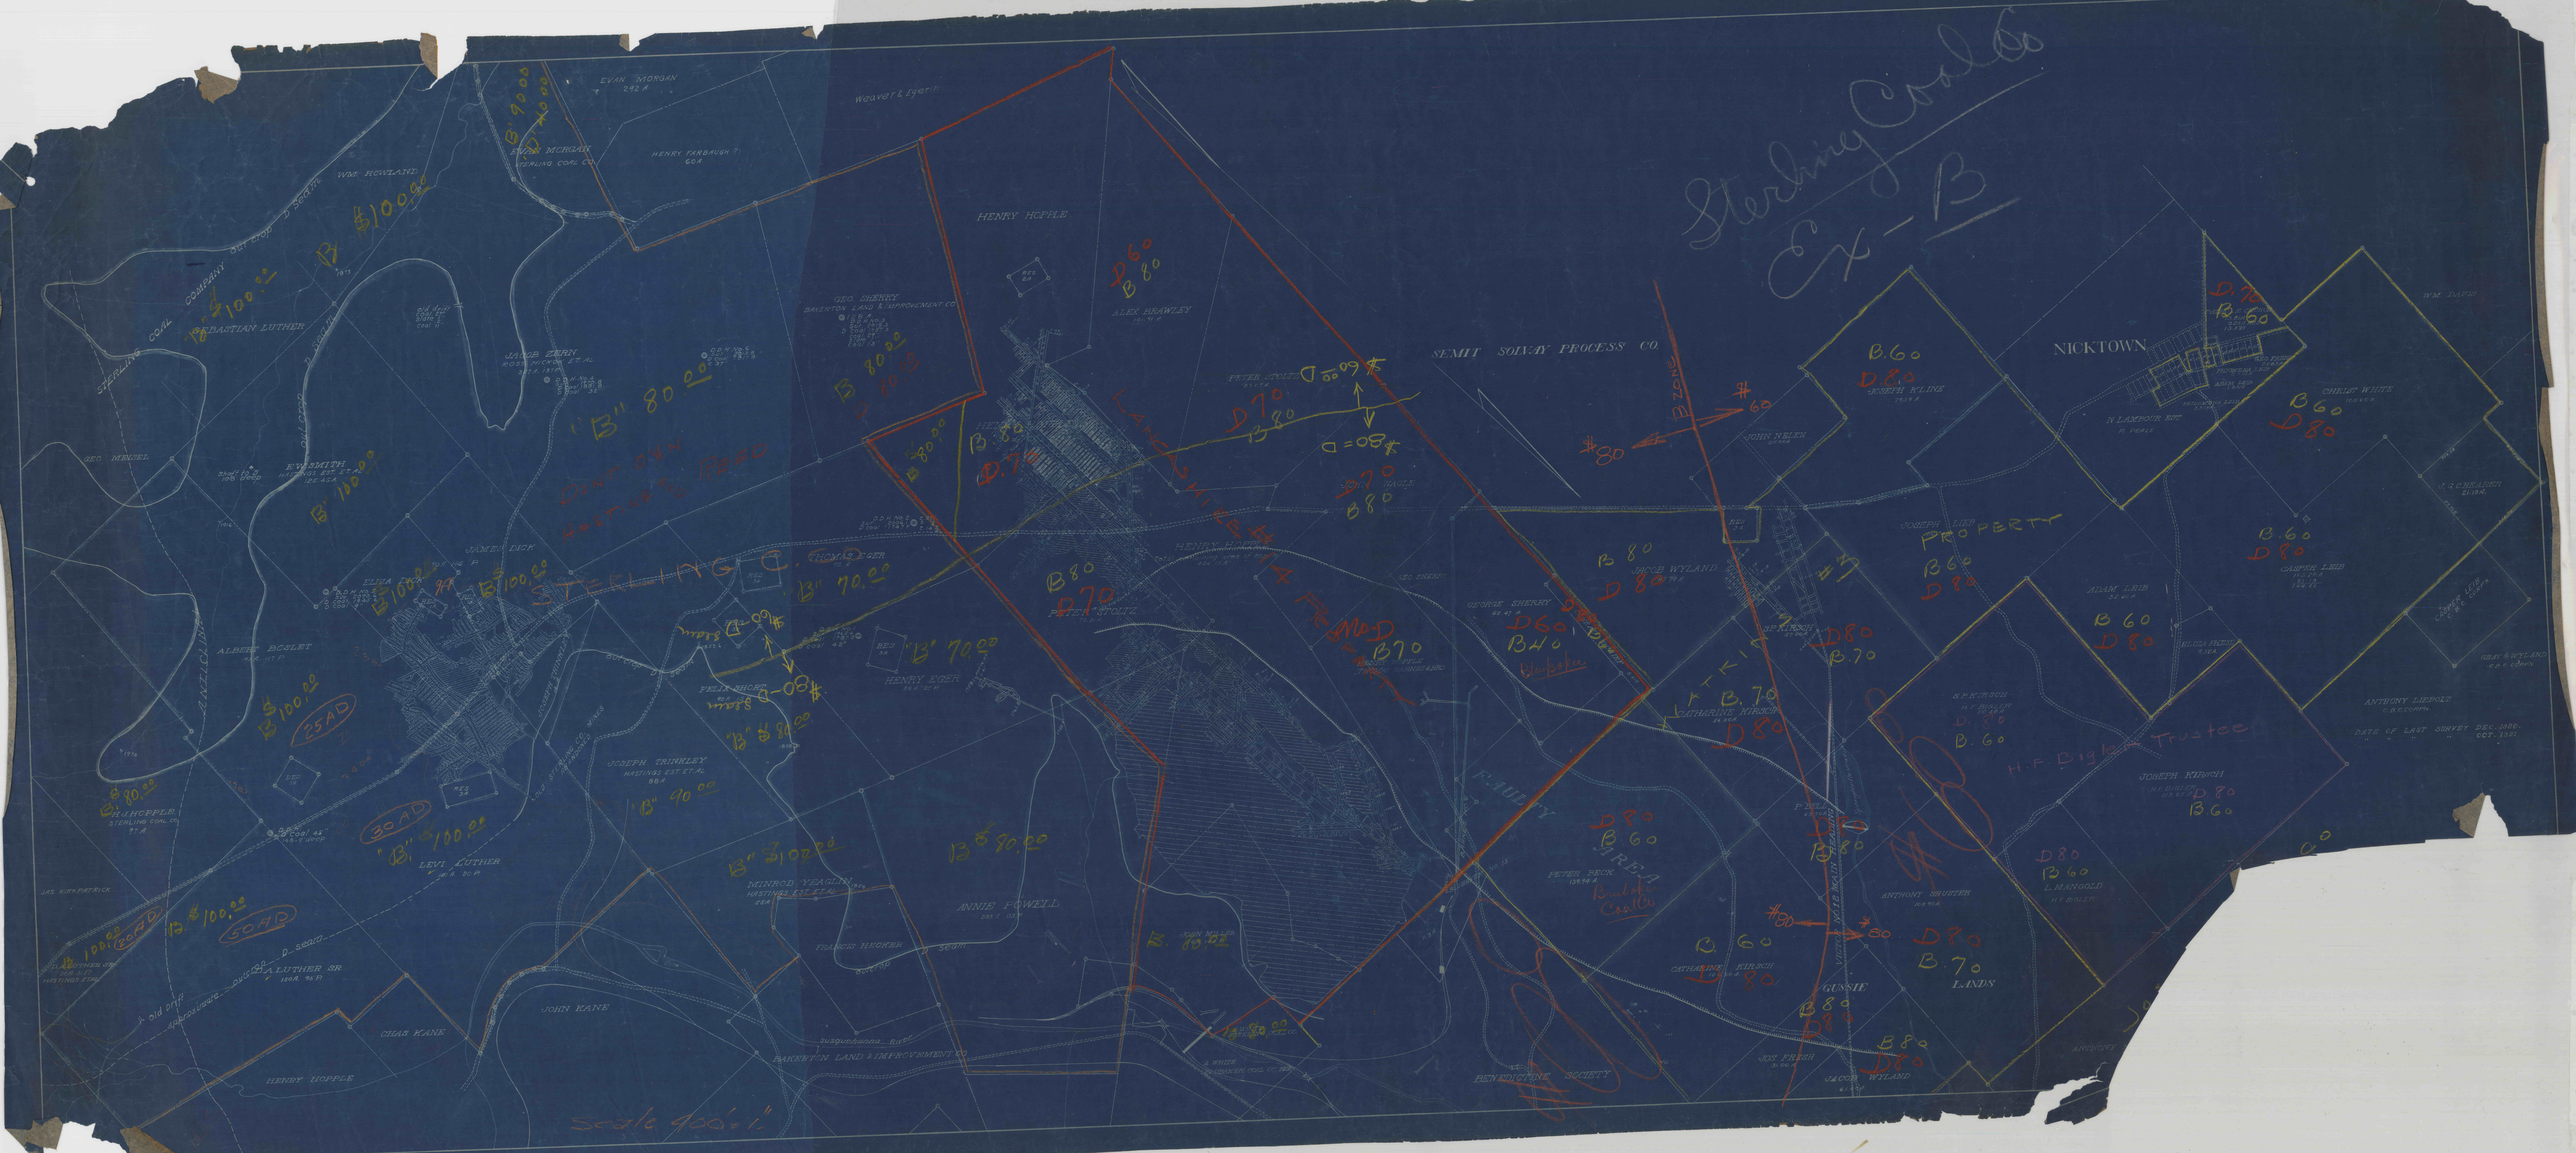
Sterling Coal Co
Ex-B
SEMIT SOLVAY PROCESS CO.
NICKTOWN
HENRY HOPPLE
ALEX BRAWLEY
PETER STOLTZ
JACOB WYLAND
GEORGE SHERRY
JOSEPH KLINE
JOHN NELEN
JOSEPH KIRSCH
ADAM LEIB
CASPER LEIB
CHRIST WHITE
ANTHONY LIEBOLT
CATHARINE KIRSCH
GUSSIE LANDS
ANTHONY SHUSTER
L. MANGOLD
JOS FRESH
JACOB WYLAND
BENEDICTINE SOCIETY
PETER BECK
FAULTY AREA
PROPERTY
H.F. Bigler Trustee
STERLING C.
LANDSWIRE 4 PEAK
JOSEPH TRINKLEY
HENRY EGER
ANNIE POWELL
MINROD YEAGLIN
FRANCIS HECKER
JOHN KANE
CHAS KANE
HENRY HOPPLE
LEVI LUTHER
ALBERT BOSLET
JAMES DICK
EVESMITH
JACOB ZERN
SEBASTIAN LUTHER
WM. ROWLAND
EVAN MORGAN
HENRY FARBAUGH
GEO. SHERRY
BAKERTON LAND & IMPROVEMENT CO.
Scale 400'=1"