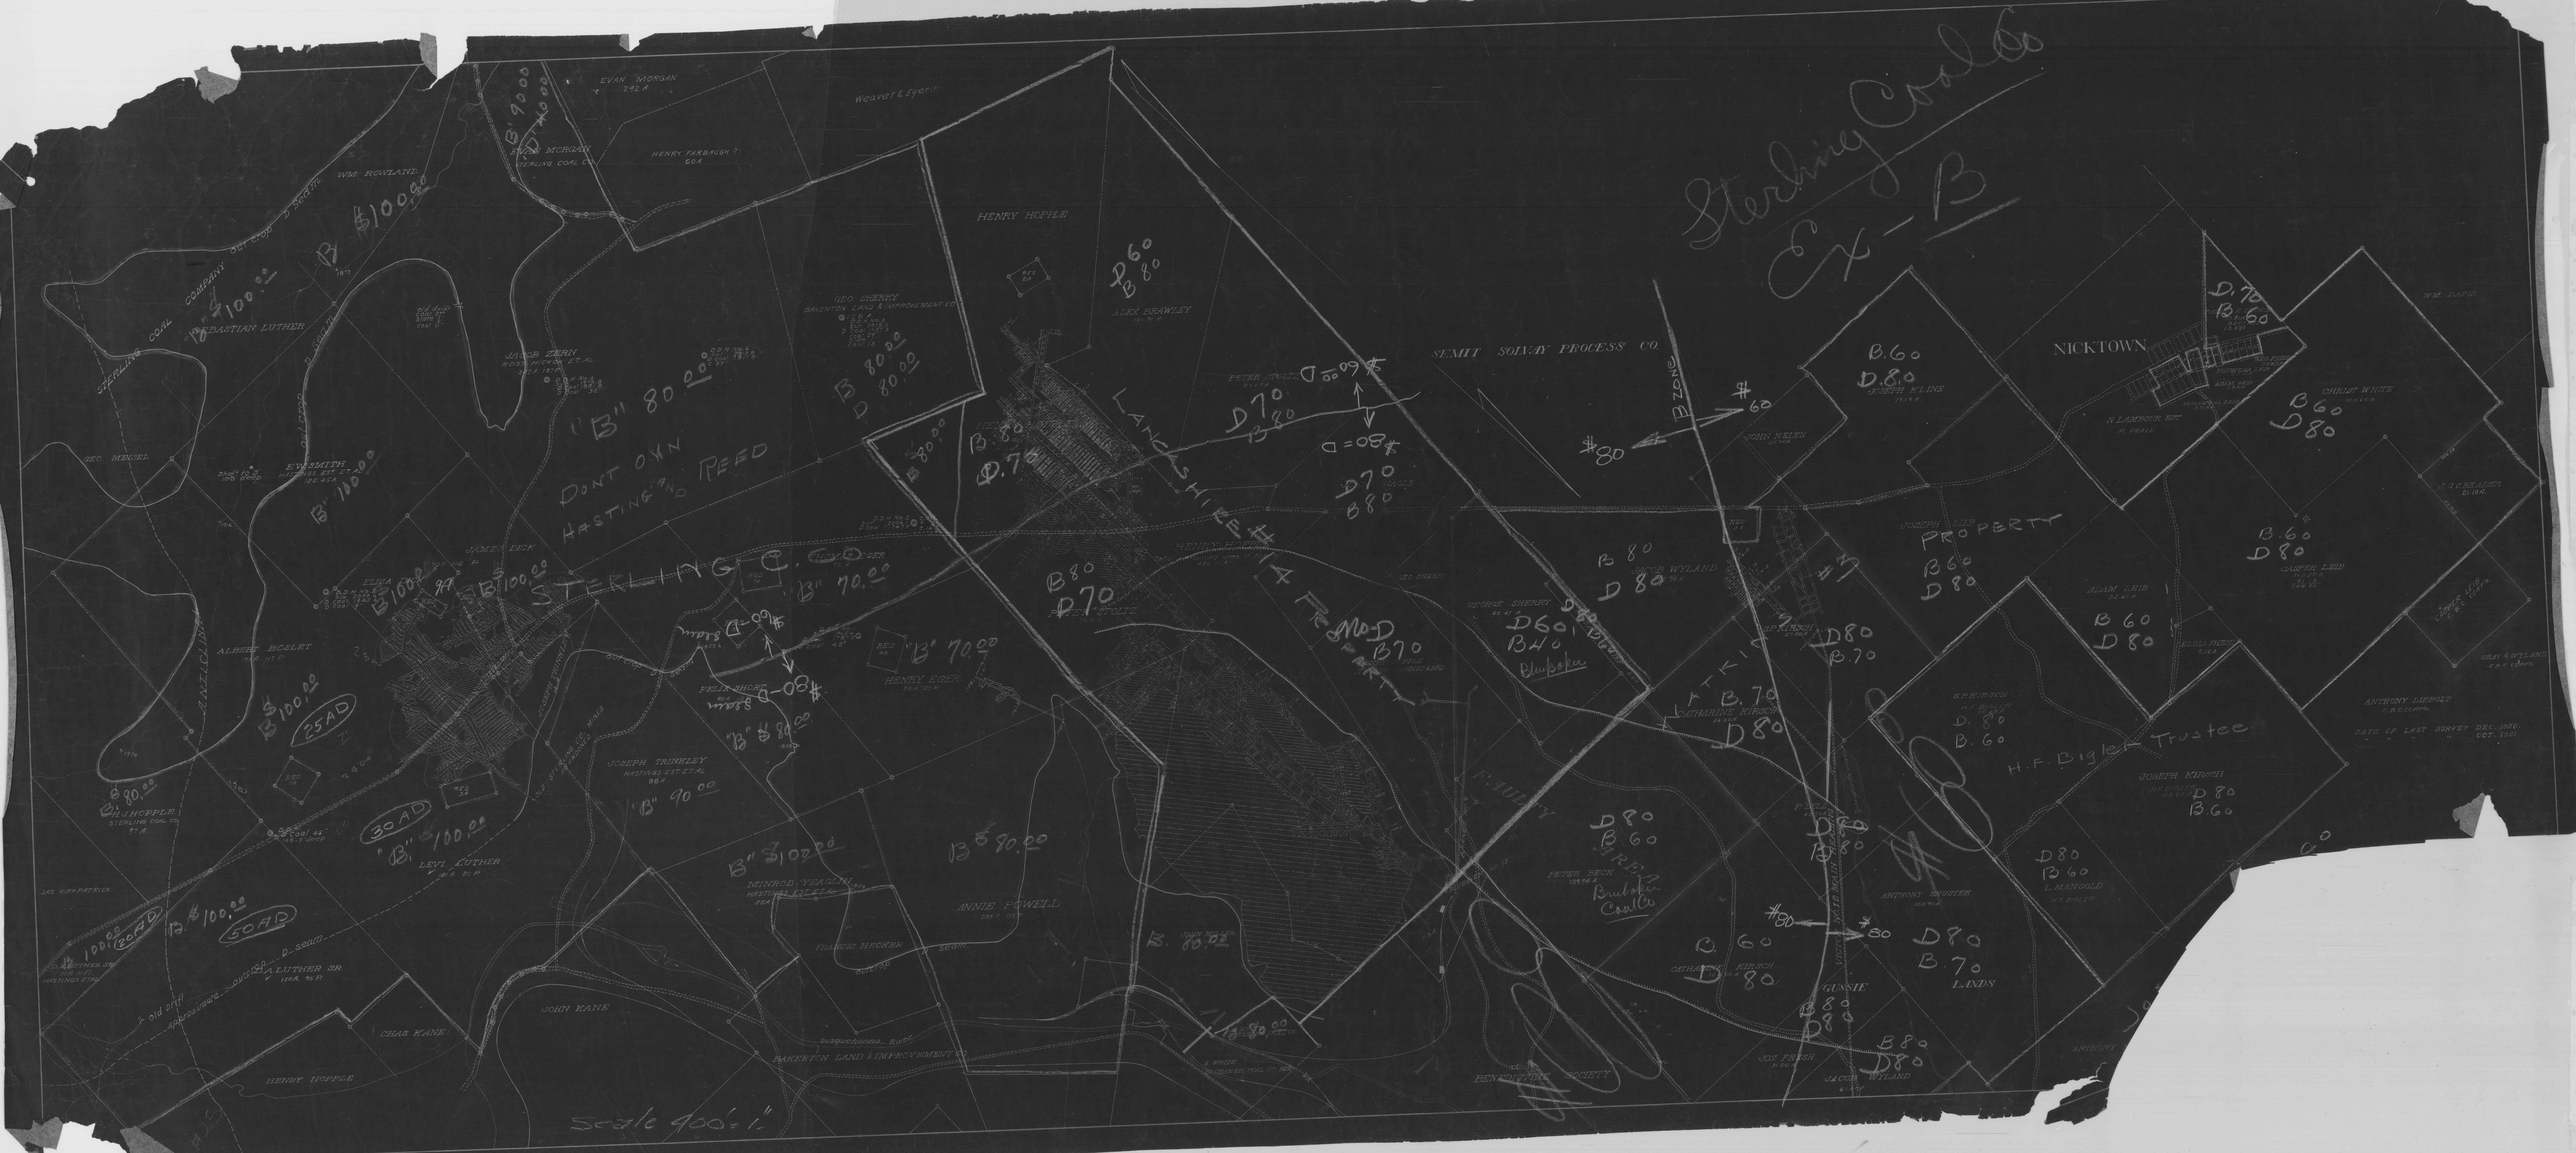
Sterling Coal Co
Ex-B
STERLING COAL COMPANY
DONT OWN
HASTINGS AND REED
STERLING C. CO.
LANCASHIRE #14 PROPERTY
SEMIT SOLVAY PROCESS CO.
NICKTOWN
PROPERTY
H.F. Bigler Trustee
HENRY HOPPLE
ALEX BRAWLEY
JOSEPH TRINKLEY
ANNIE POWELL
JOHN KANE
CHAS KANE
LEVI LUTHER
ALBERT BOSLET
JAMES DICK
EVESMITH
GEO. MENZEL
WM. ROWLAND
EVAN MORGAN
HENRY FARBAUGH
JACOB ZERN
GEO. SHERRY
PETER STOLTZ
JOSEPH KLINE
JOHN NELEN
JACOB WYLAND
GEORGE SHERRY
CATHARINE KIRSCH
JOSEPH KIRSCH
ANTHONY SHUSTER
L. MANGOLD
GUSSIE LANDS
JOS FRESH
BENEDICTINE SOCIETY
BAKERTON LAND & IMPROVEMENT CO.
Scale 400'=1"