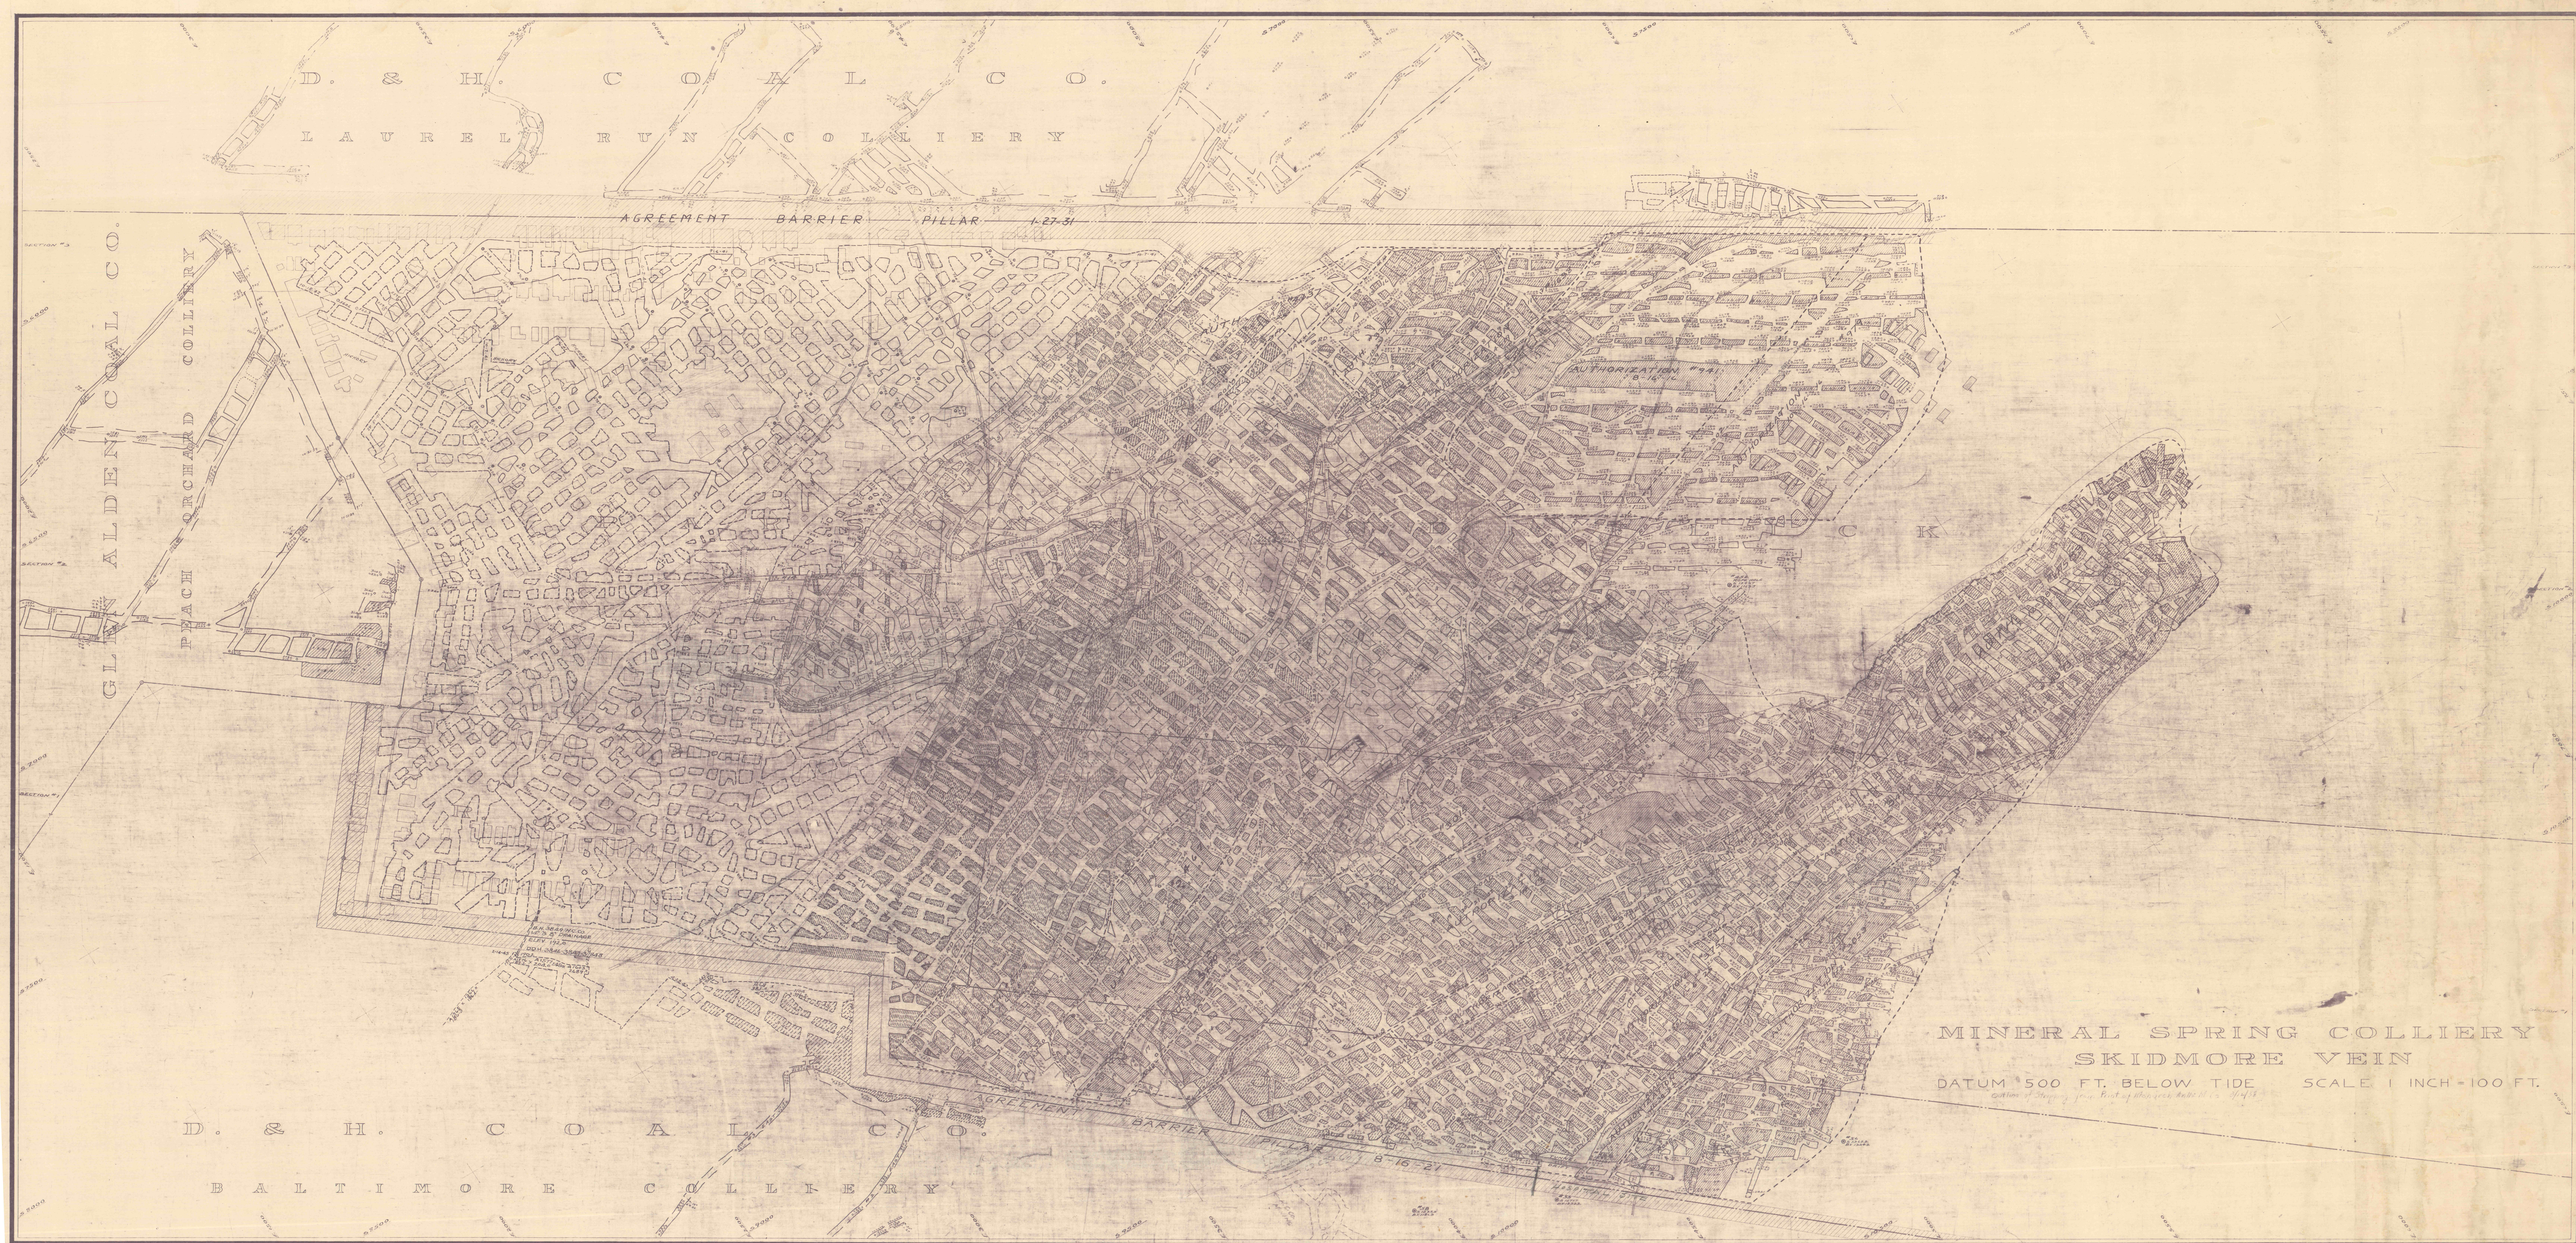
D. & H. COAL CO.
LAUREL RUN COLLIERY
AGREEMENT BARRIER PILLAR 1-27-31
GLEN ALDEN COAL CO.
PEACH ORCHARD COLLIERY
AUTHORIZATION #741
8-16
C K
MINERAL SPRING COLLIERY
SKIDMORE VEIN
DATUM 500 FT. BELOW TIDE SCALE 1 INCH = 100 FT.
AGREEMENT BARRIER PILLAR 8-16-27
D. & H. COAL CO.
BALTIMORE COLLIERY